


No 150. Screw Steamer. "Lady Olive"  
 Scale  $\frac{1}{8}$ " = One foot.  
 Glasgow Report No. 4785

A. & J. INGLIS,  
 Engineers and Shipbuilders,  
 GLASGOW

7<sup>th</sup> May 1878.

Rev 9/5/78 & 1/5/78  
 JH

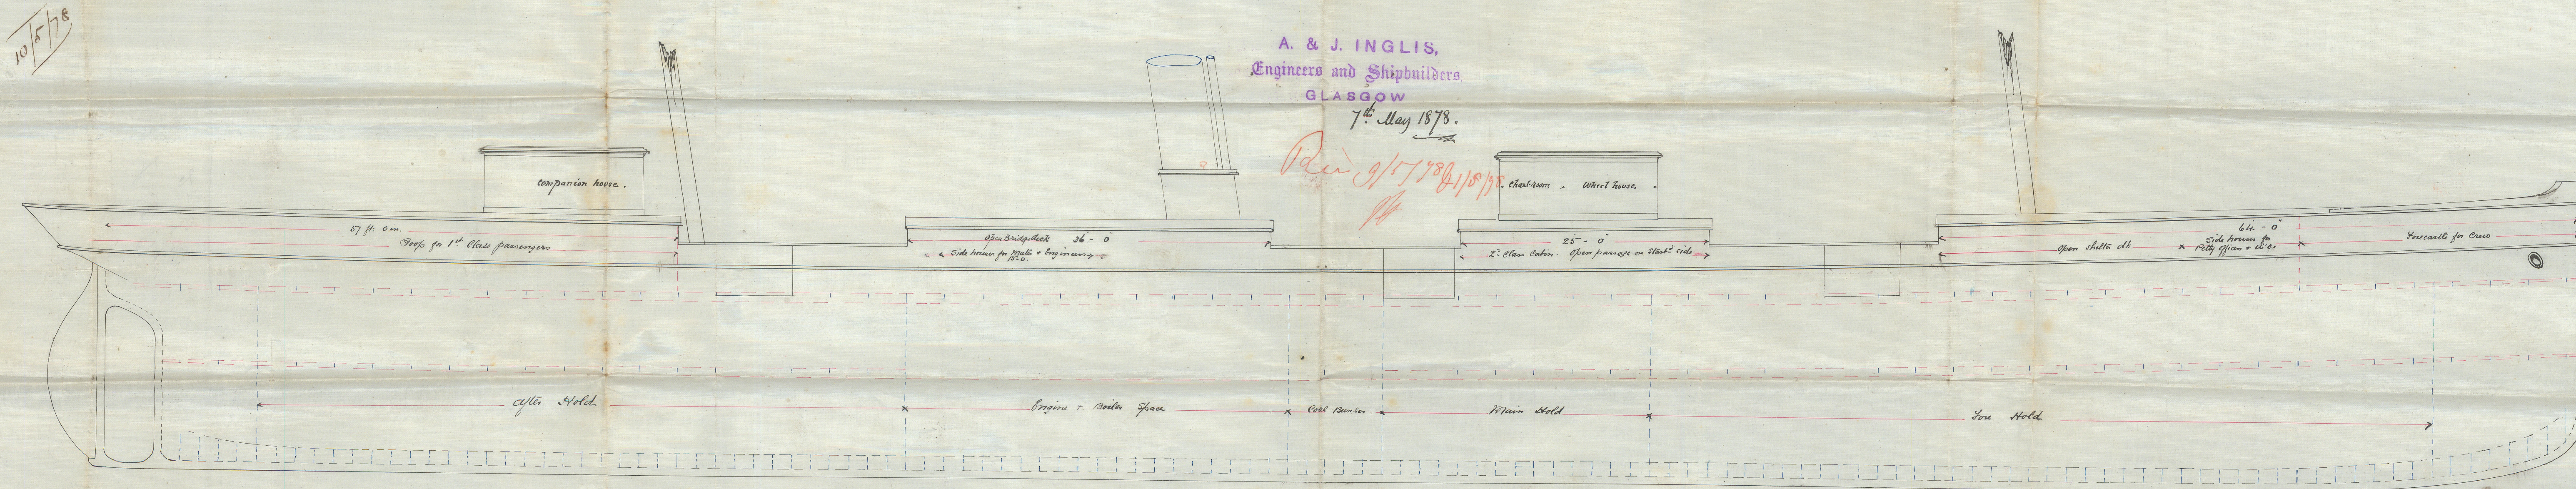

© 2021  
 Lloyd's Register  
 Foundation

IRONS32-0076