



26/9/78



1/2 Midship Section  
Paddle Steamer "St. Clair of the Lakes"  
Scale 1/4 in = 1 Foot

1/2 Breadth	12
1/2 Depth	23.2
Depth	13.2
	46.8
	183
	855.4

1/2 Breadth	12.0
1/2 Depth	21.6
Depth	13.2
	46.8
Length	183
	8564.4 2 m No
	7-6 B.
	13-8 D

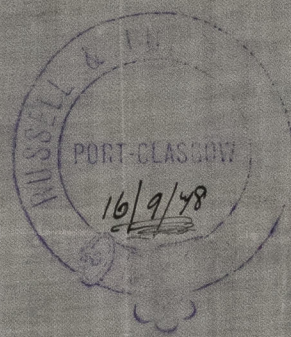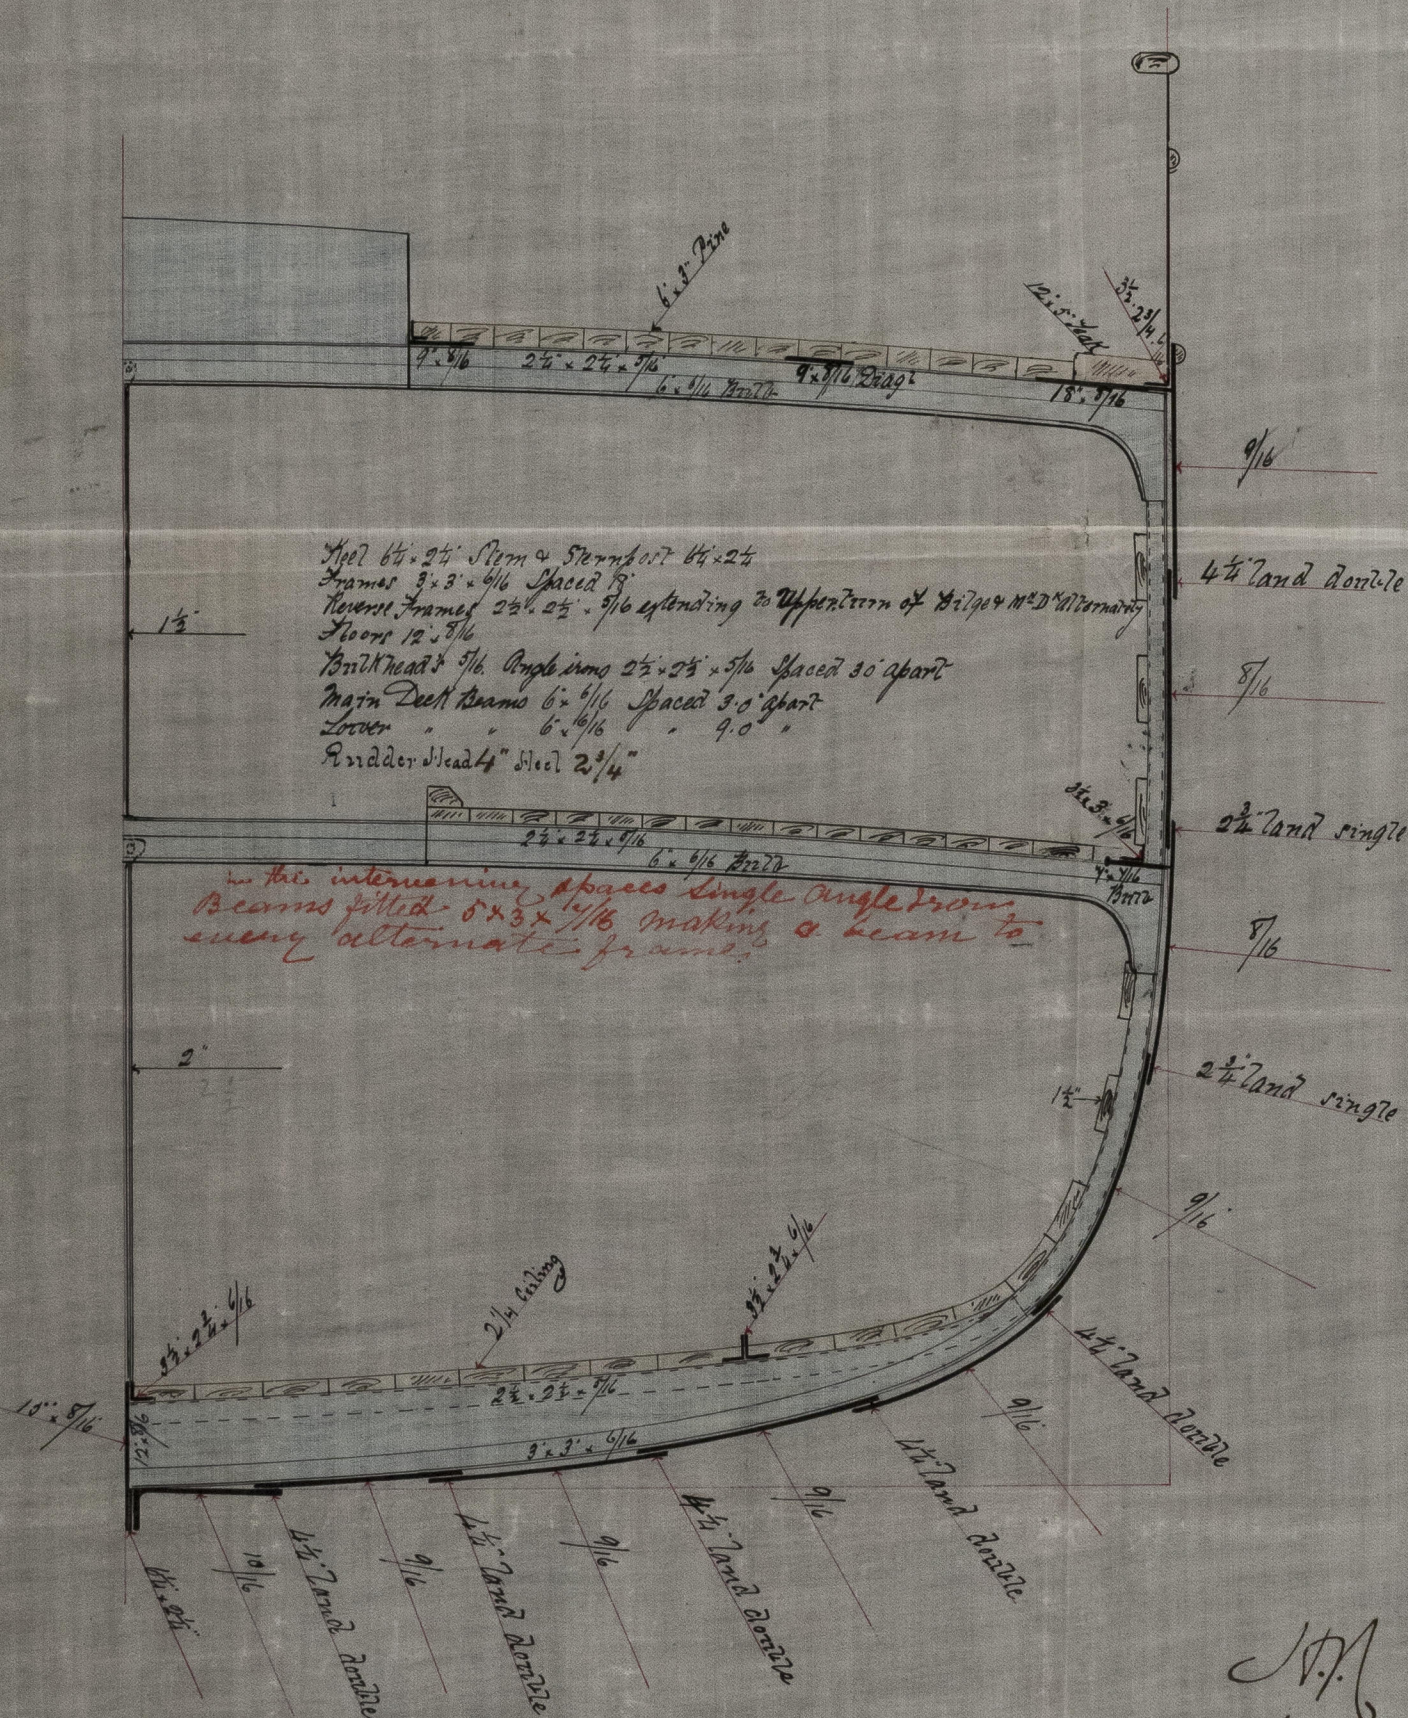

26/9/78