



Dimensions  
 Length from After part of Stern to Fore part of Mast 268' 6"  
 Breadth Keel to Keel 33' 3 1/2"  
 Depth to Stern 25' 11"  
 14 to 15 Depth to Length at Main Deck  
 8 to 8 1/2 Breadth to Length  
 10 to 11 Depth to upper deck

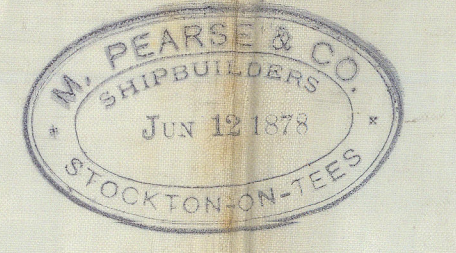

*S.S. Baron Monarch, West Hartlepool Report No. 1116.*  
Iron 22647

ELEVATION  
 OF  
 No. 166 S.S.  
 SCALE - 1/4 INCH TO THE FOOT

270' 0" x 33' 6" x 24' 0"  
*Rev 11/1/78*

 

*J.M.*  
*18/1/78*

*W.H. Pool*  
*18/6/78*  
*110*