

Per 19/7/28

S.S. "Saxon Monarch," West Hartlepool Report No. 4116.


## PLAN OF MASTS

— FOR

- N<sup>o</sup> 166 SS

Scale  $\frac{1}{2}$  Inch to one Foot.

Fore Mast.

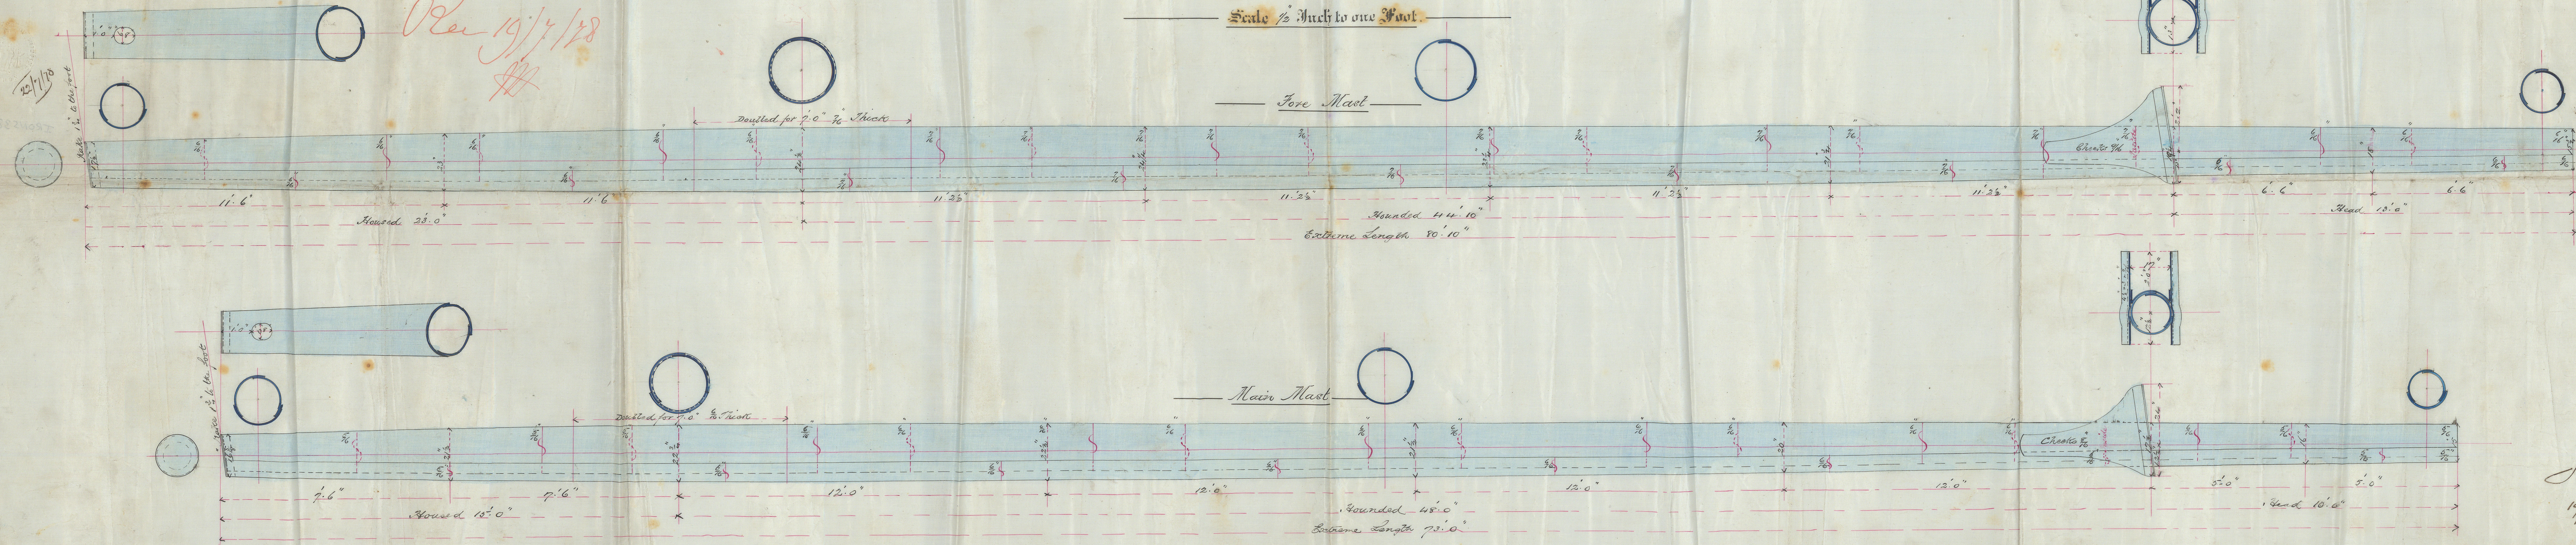

J.H.L.  
19/7/78

W. H. Pool 18<sup>th</sup> July 1878

IRONS32-0117



Lloyd's Register Foundation





454 seems double  
outside as shown on facing in section  

Position of these walls to be strictly adhered to and to be fitted outside of mass except where marked inside

45 Section to be thicker than the plates they connect

45 Section above that to be filled riveted

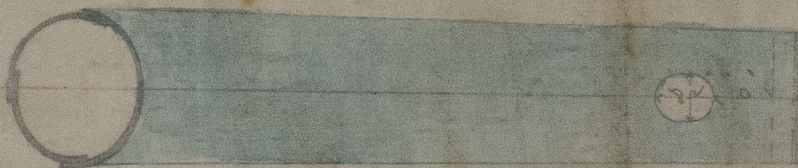

IRONS 32-0117

