


S. S. Clark & Co.
S. S. Clark & Co.
Glasgow Rep. No. 4800
Dec 29/57/78 & 10/8/78 & 3/9/98
RS

No 215 + 216
Three Decked Glass 100 A -

Length between posts.	305 ft. 0 in.
Breadth moulded	34 " 6 "
Depth "	26 " 5 1/2 "
" in Hold	24 " 3 1/2 "

Frames spaced 24" Centre to Centre

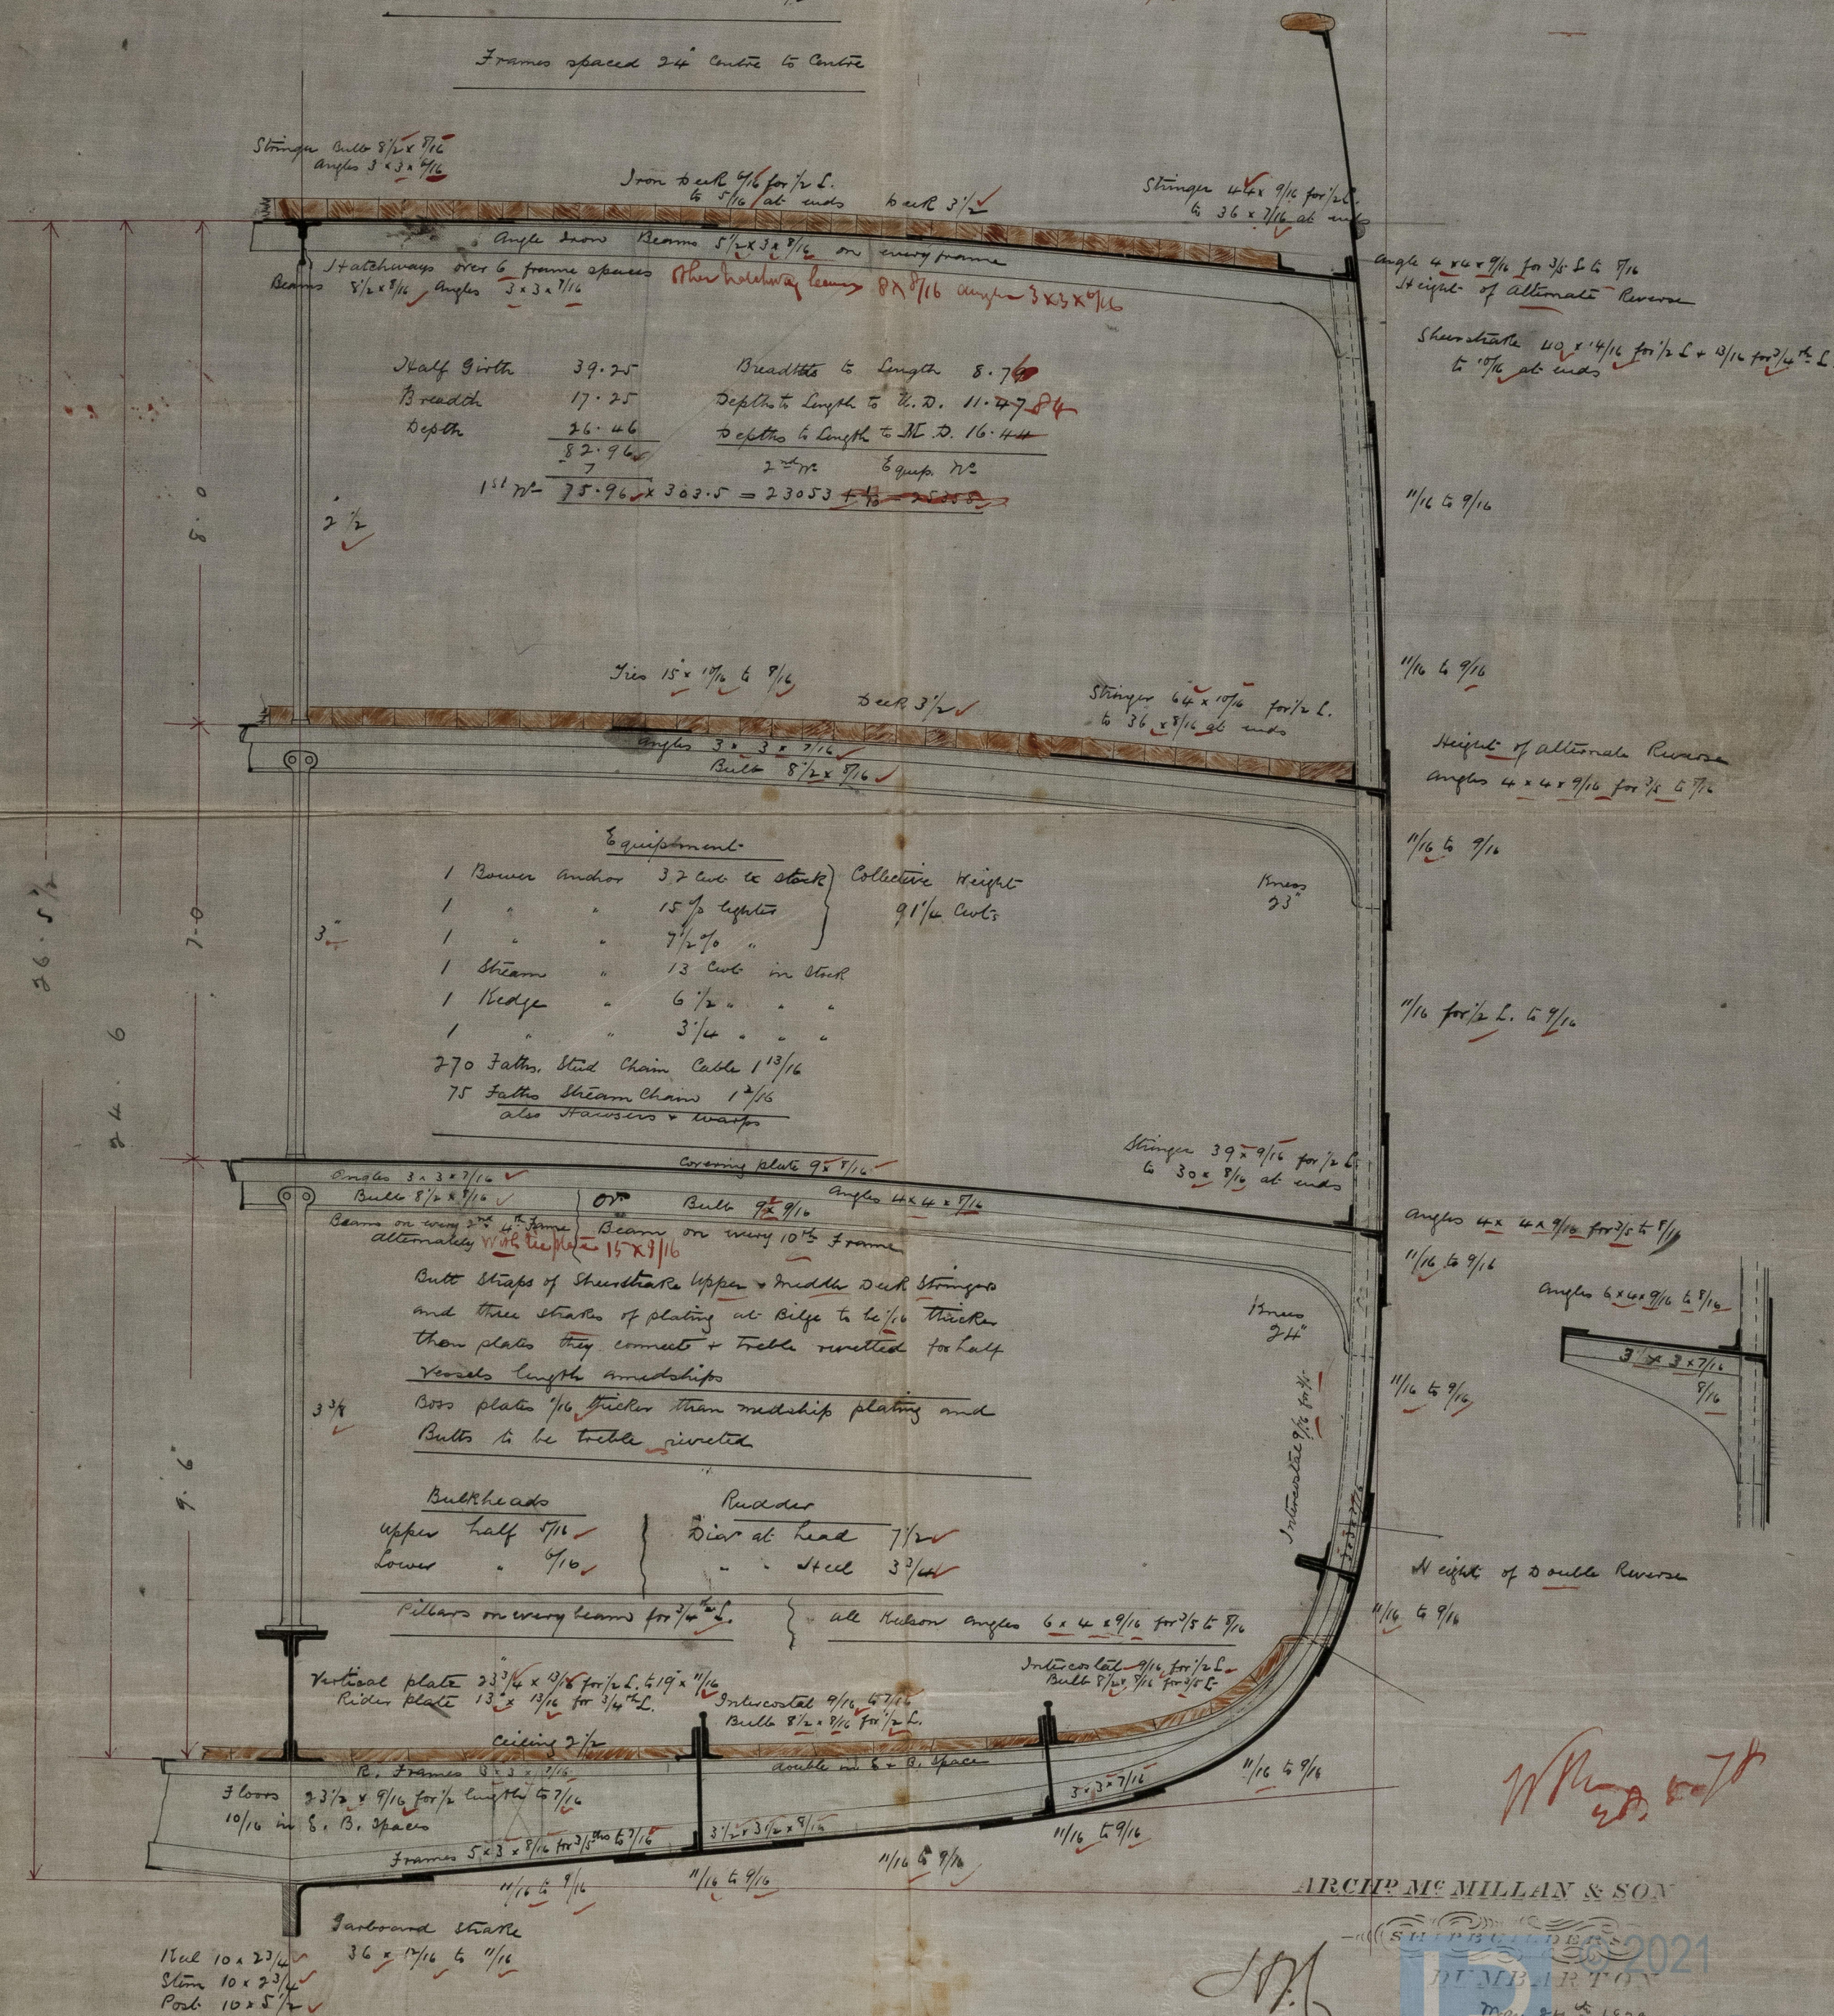

ARCHD^o M^o MILLAN & SON

DEMBERTON

May 24th 1878

1878
Lloyd's Register
Foundation

IRONS32 - 0147