


"Clan Ranald"  
No. 4800

Screw Steamer No 215 + 16

25/7/78

Rec 24/7/78 & 5/9/78  
JA W

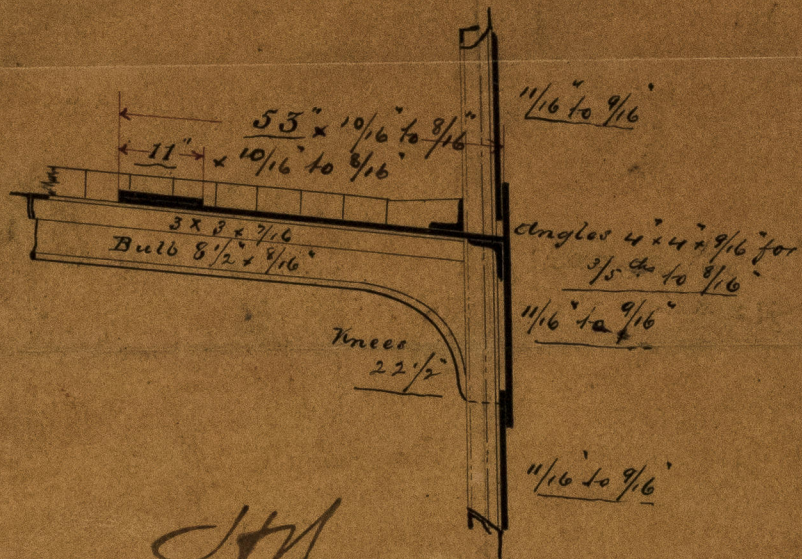

JA

24/7/78



© 2021

Lloyd's Register  
Foundation

IRON 532 - 014-8