

"Topage" - Report No 14240.

7/6/78


No 39 Ship
Sketch showing stiffening of
Bulkheads when Water Ballast
extends to Stold beams

J. S. SWAIN & CO
Iron Shipbuilders
WALLSEND
NEWCASTLE ON TYNE.
5th June 1878.

Scale $\frac{1}{2}$ inch to foot

Rec 7/6/78

JS

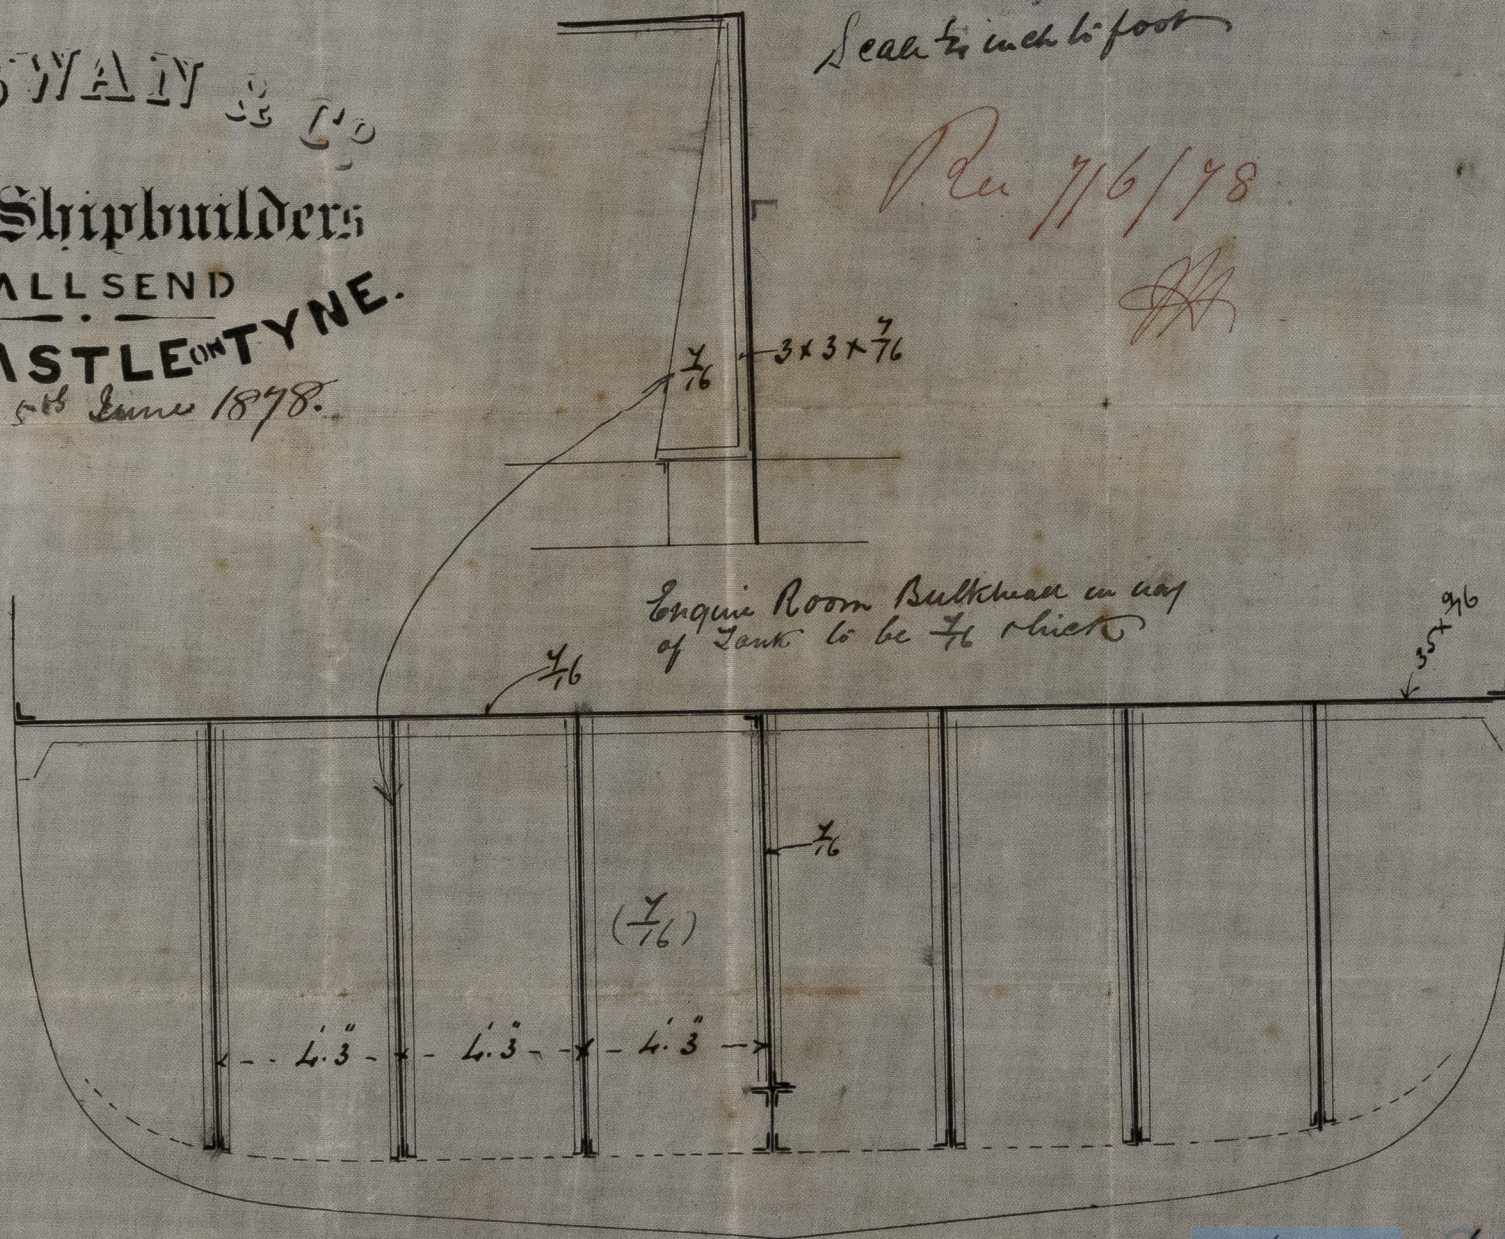

2021
Lloyd's Register
Foundation
IRONS32-0162