

7/6/78


C. S. SWAN & CO
Iron Shipbuilders
WALLSEND
NEWCASTLE-ON-TYNE.
3rd June 78

"Topage" Report No 14240

Rev 7/6/78

Sketch showing arrangement
of Hold Stanking Beams
Leath 8 in to foot

6/6/78

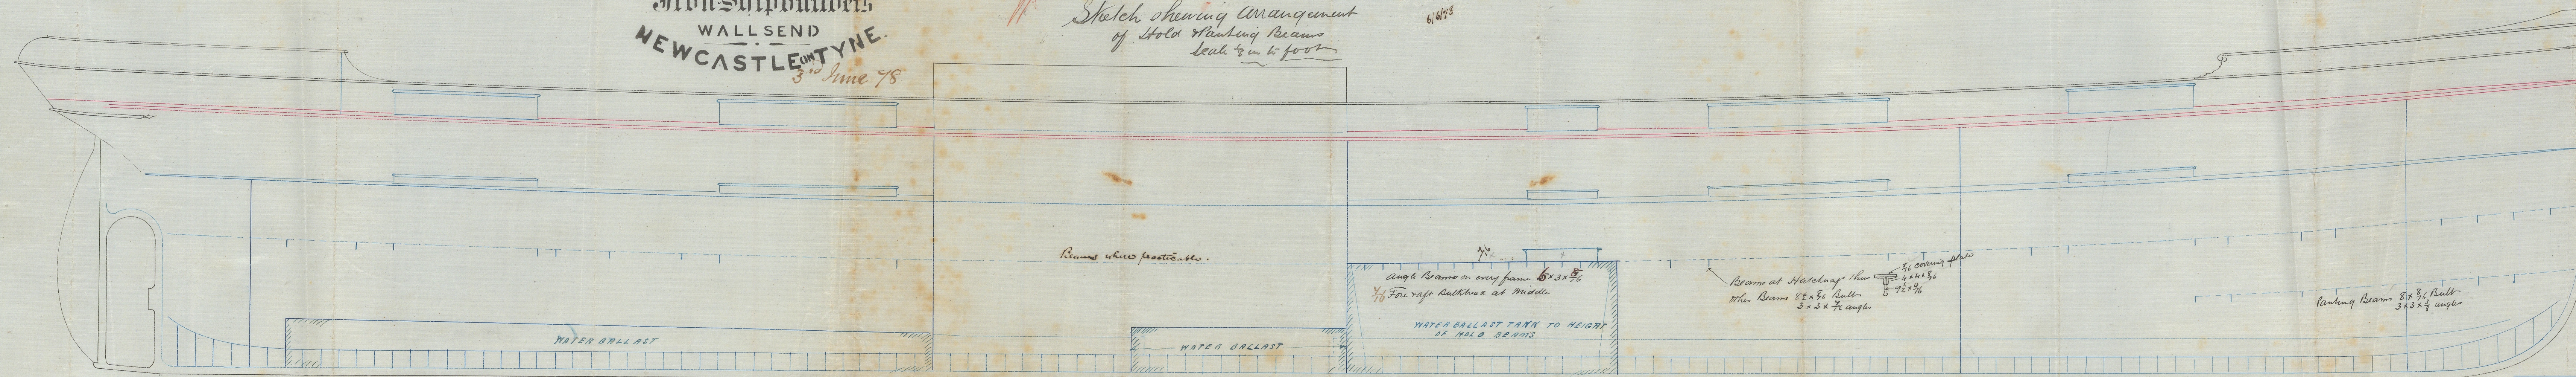

7/6/78