

No^d 300


LENGTH BETWEEN PERPENDICULAR _____ 162
BREADTH EXTREME _____ 29
DEPTH IN HOLD _____ 13.5
TONNAGE REGISTER _____ 470

Numbers for Scanlings

Half Rounding Breadth	14.4
Depths from top of keel to top of Deck Beam	18.

Number for Equipment 9464.9

Section
of
Raised Quarter Deck

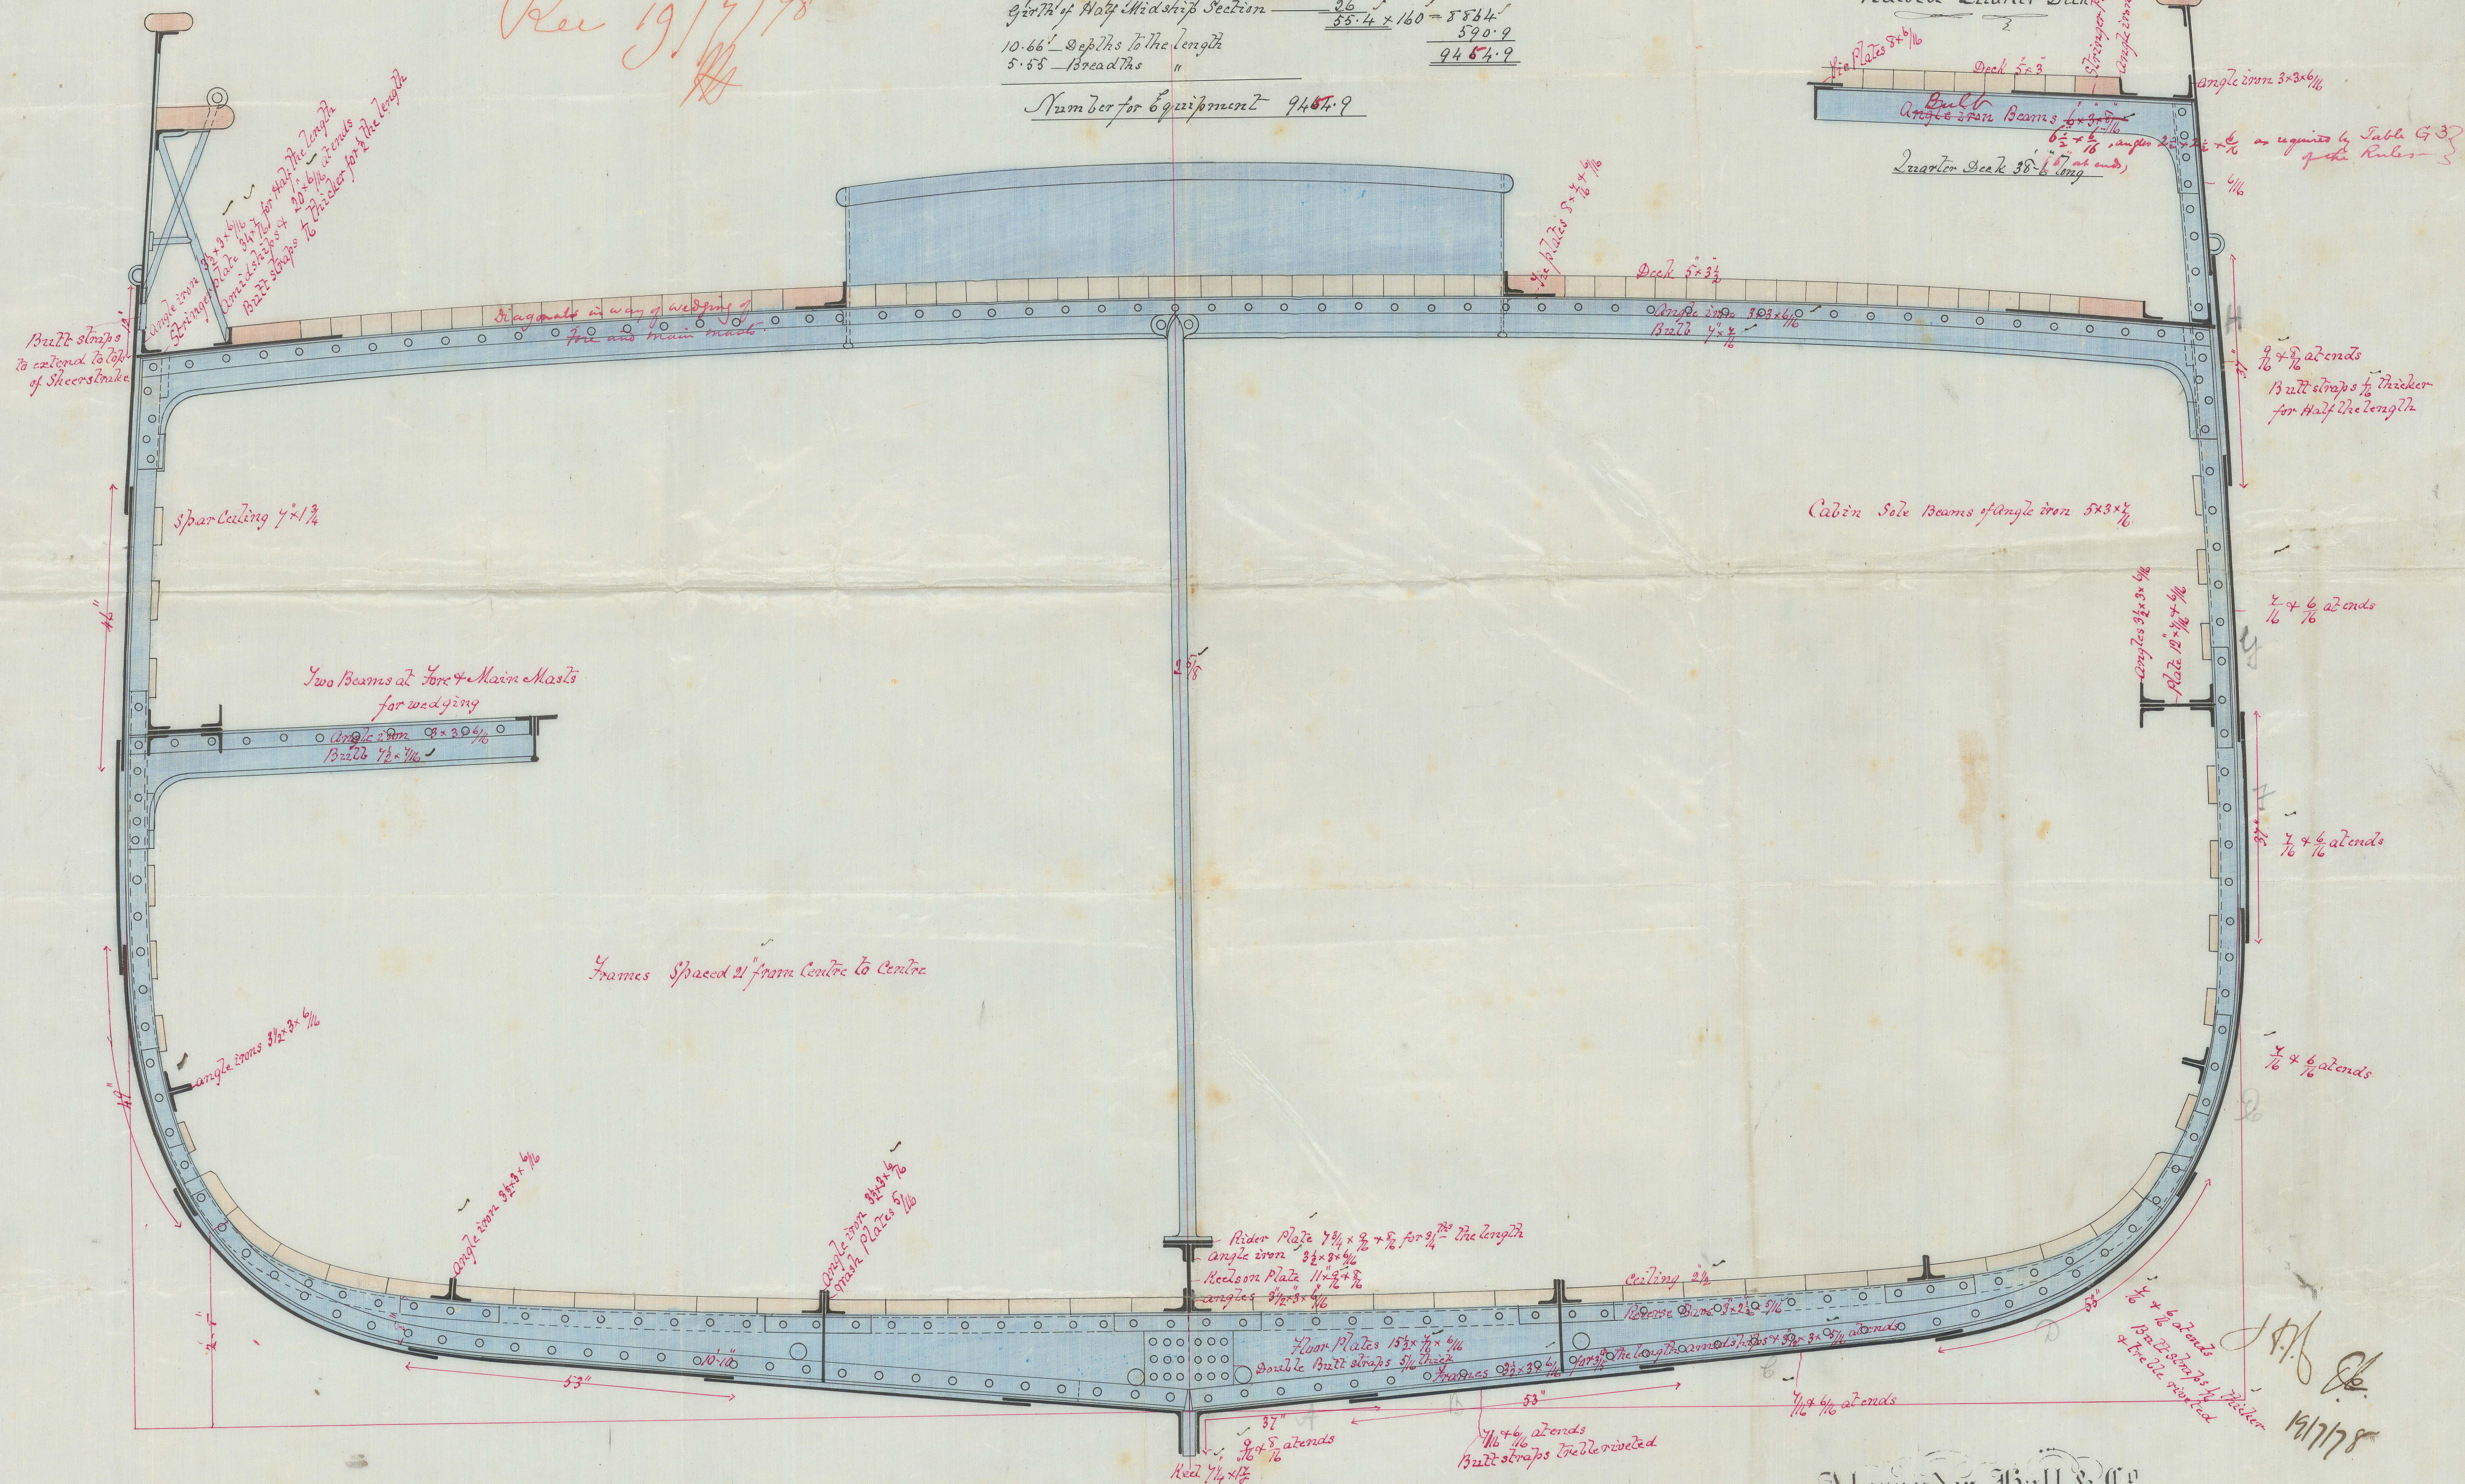

SCALE $\frac{3}{4}$ INCH TO A FOOT

Alexander Hall & Co
Shipbuilders
ABERDEEN.