

"Rheneia" - Report No 14700.

No 95

DIMENSIONS.

| | |
|-----------------|--------------|
| LENGTH PERPS. | 254.9 |
| BREADTH MOULDED | 33.6 |
| DEPTH | 21.9 |
| DO OF HOLD | 20.6 |
| ENGINES | NOMINAL H.P. |


Class 100A

Scale 1/2 inch = one foot.

Rev 21/6/78

Bridge, Poop, & Forecastle decks 4" x 3"
Beams of Forecastle 6" x 1/2" Bulbs & 2 1/2" x 3/4" angles

21/6/78

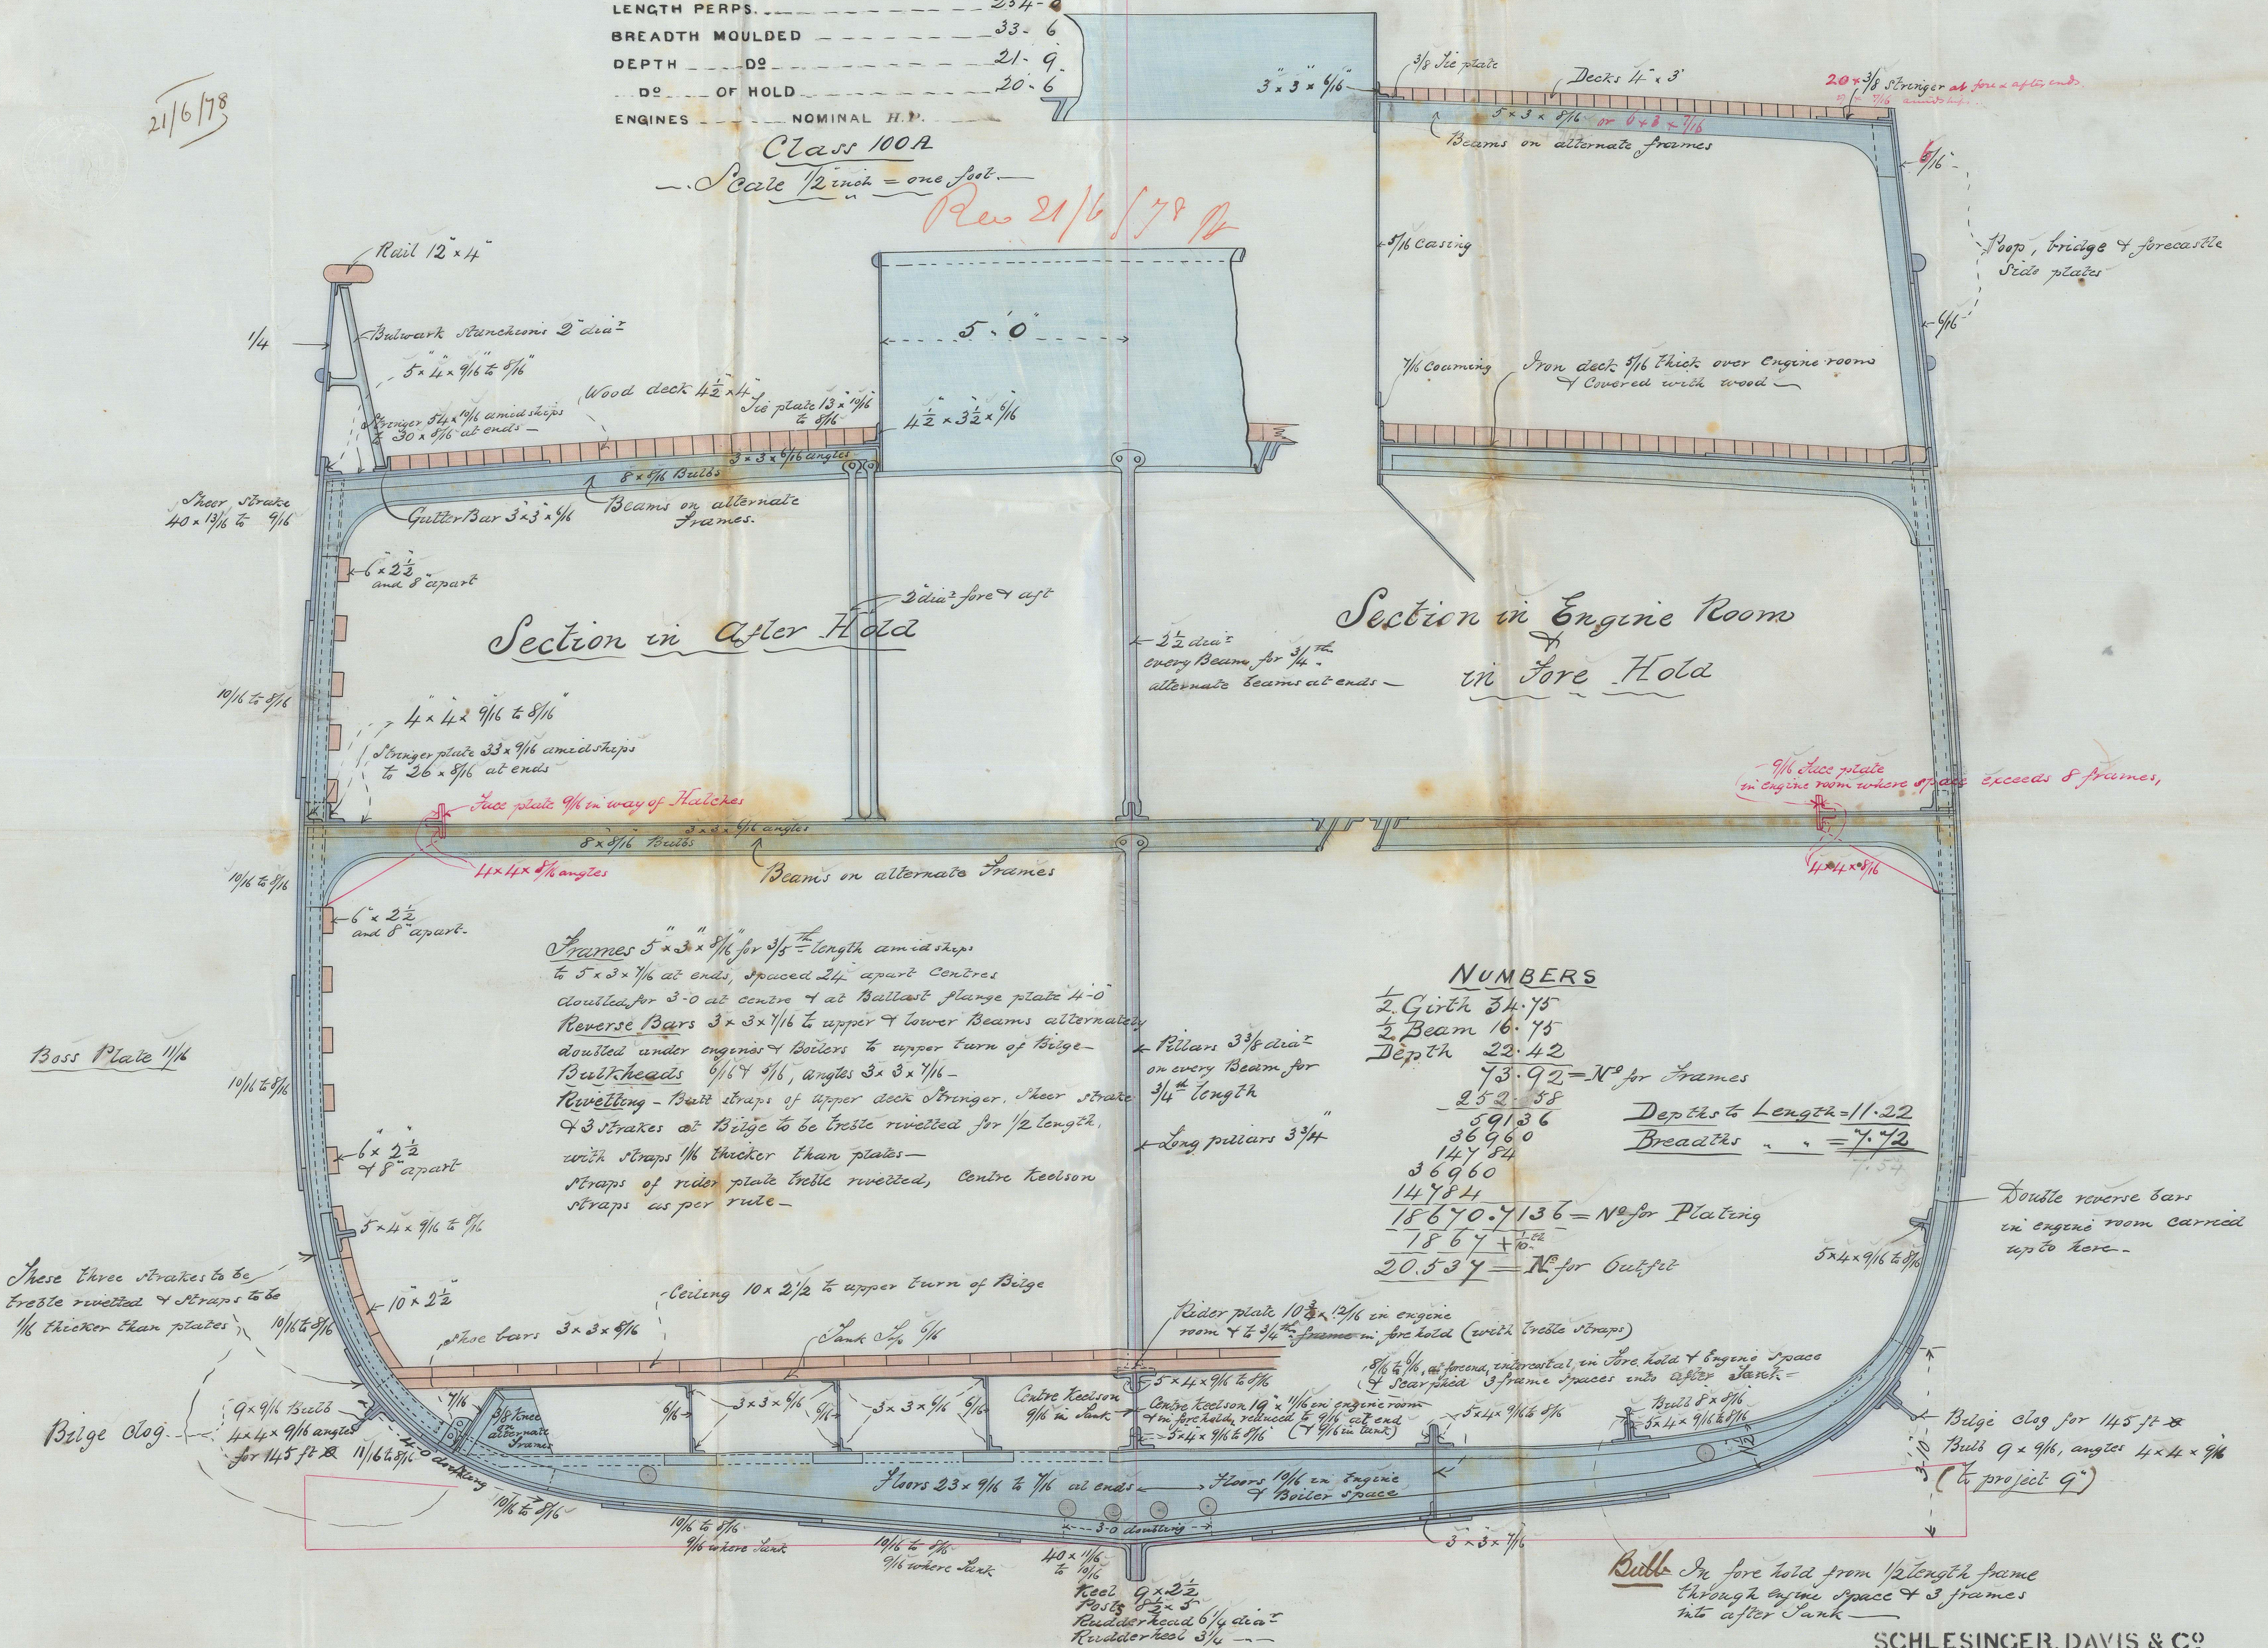

SCHLESINGER, DAVIS & CO
IRON SHIP BUILDERS.
WALLSEND.
NEWCASTLE-ON-TYNE.

21/6/78



18/6/78

Lloyd's Register
Foundation