"Celtic Monarch" – Report No 14311

S.S. No 114

MIDSHIP-SECTION

TO CLASS 100 A.I. AT LLOYDS

FOR A THREE DECK RULE

SCALE ½" INCH = 1 FOOT

14·9 & 10·88 Depths to length

8·2 Breadths to length

11-MAY-78

MWR 13 Apr 78

22/5/78

DIMENSIONS

LENGTH BETWEEN PERPENDICULARS	290-0
BREADTH OF BEAM (MOULDED)	34-9
DEPTH (")	25-8

LLOYDS-NUMBERS

½ BREADTH	17·37
DEPTH	26·50
½ GIRTH	39·00
	82·87
LESS	7·00
	75·87 × 288·42 = 21882·42
	1st No. Length 2nd No.

Rec 20/5/78 & 16/11/78 & 25/11/78

Again 19/2/79

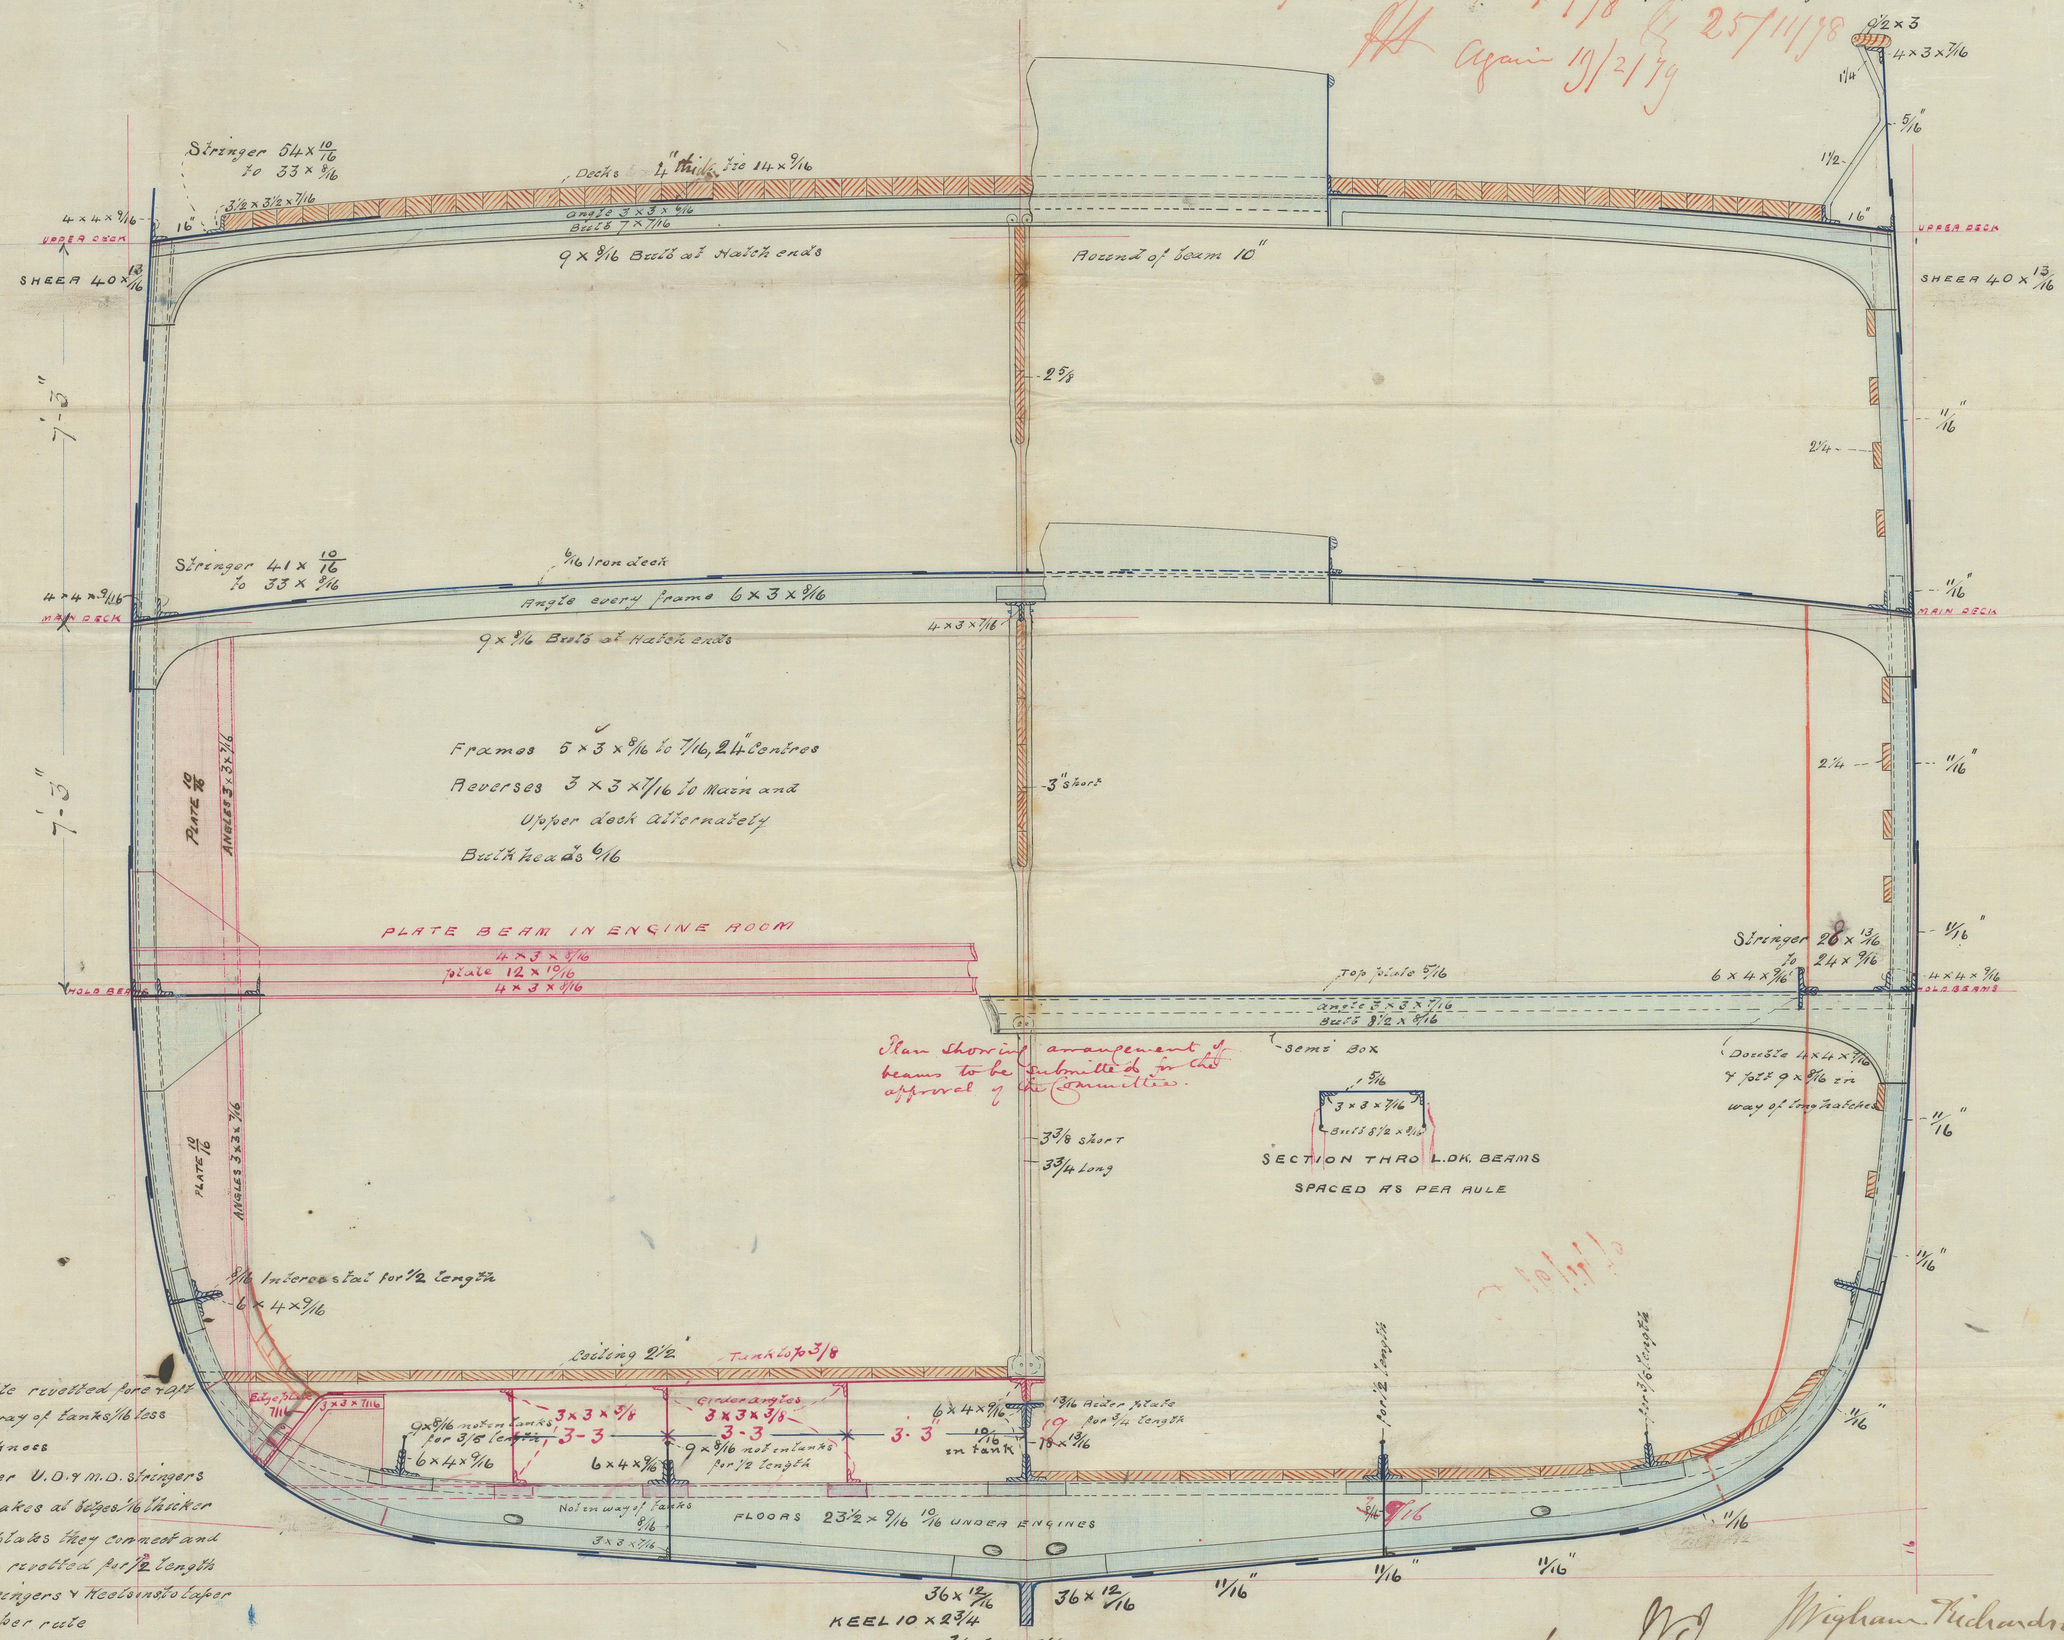

Seams double rivetted fore & aft

Plating in way of tanks 1/16 less thickness

Butts of sheer U.D. & M.D. stringers & 3 strakes at bilges 1/16 thicker than plates they connect and treble rivetted for ½ length

Plating, stringers & keelsons to taper as per rule

J.H. 19/11/78

W.J. 21/5/78

Wigham Richardson & Co

14. May 1878

IRONS33-0164

© 2021 Lloyd's Register Foundation