

"*Allic monarch*" - Report no 14311.

S.S. No. 114

Water Ballast Tank Amidships


Scale of $\frac{1}{4}$ inch = 1 foot

Rev 30/11/98



Elevation

Beams $4 \times 3 \times 7/16$ on every frame

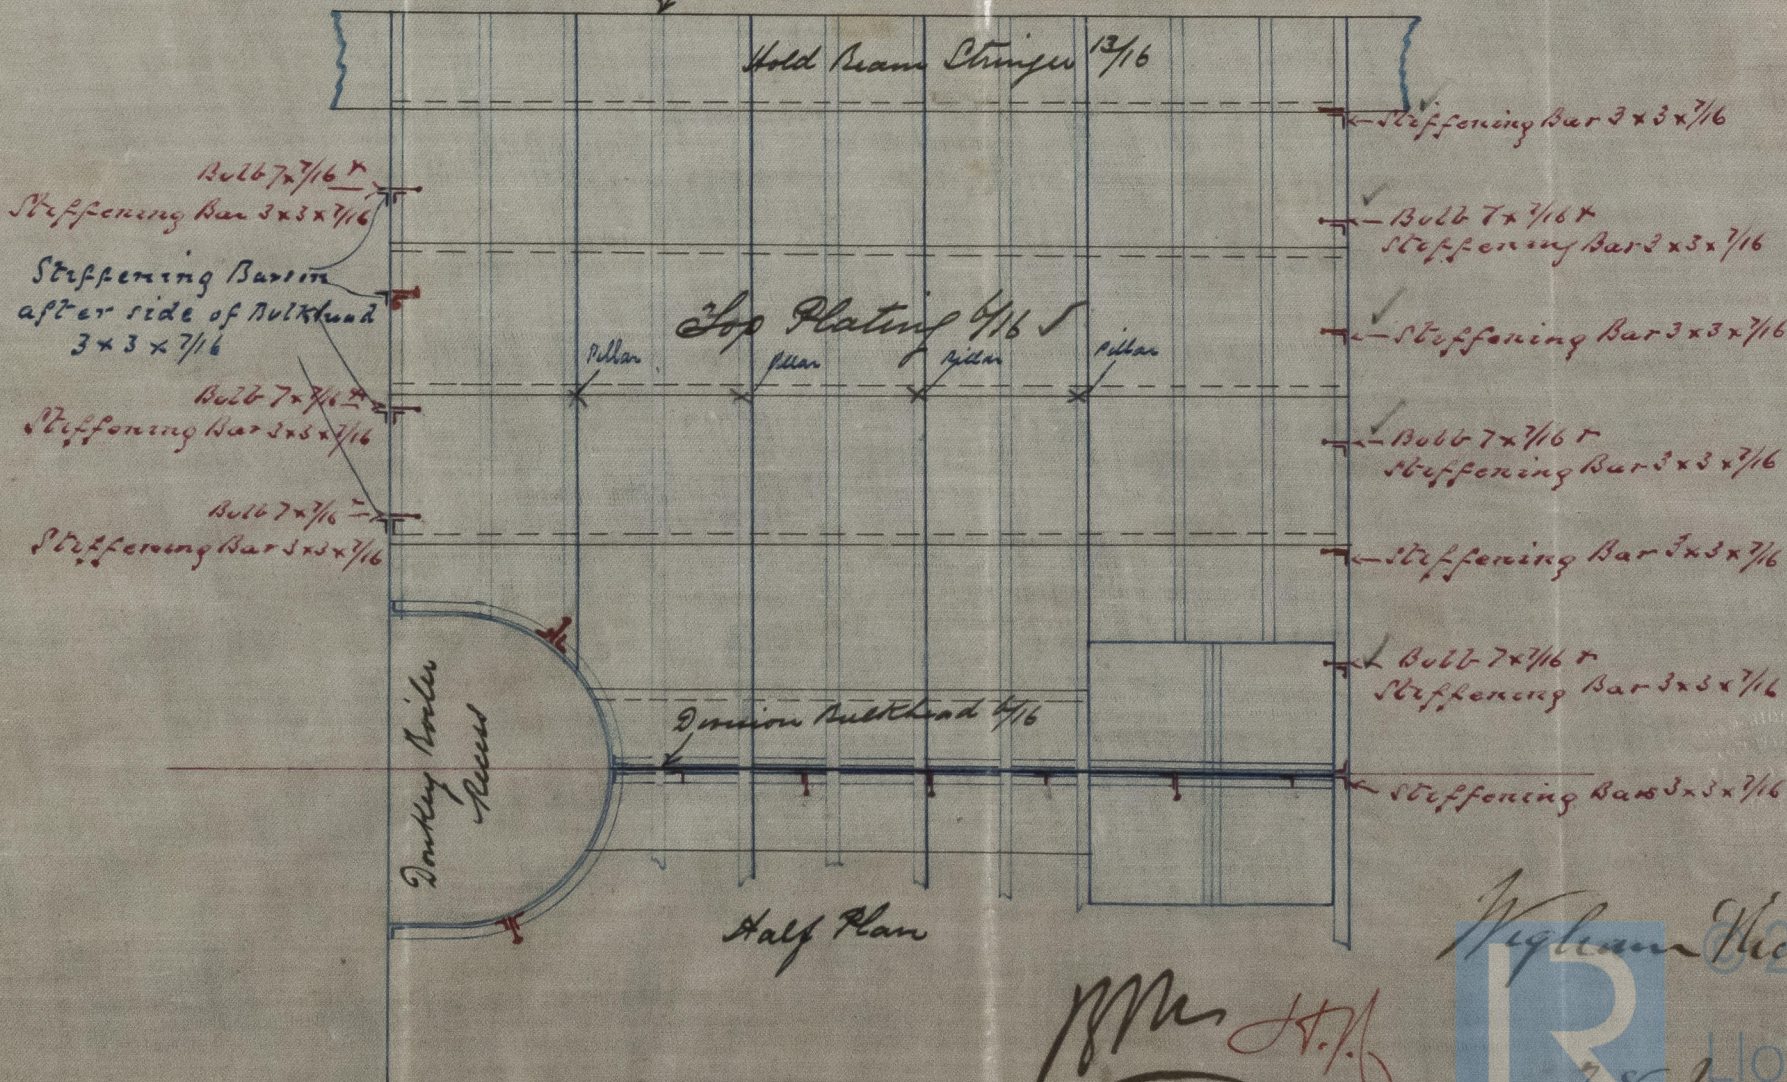

Half Plan

Wm. J. A.
2/11/98

Wigman & Richardson
28 Mar 98