


*"Bellie Monarch" - Port No 14311.*


PLAN SHOWING STRINGERS AND BEAMS

SCALE  $\frac{1}{8}$  OF AN INCH = 1 FOOT

*Rev 16/11/78 & 25/11/78  
# & 30/11/78 & 10/2/79*

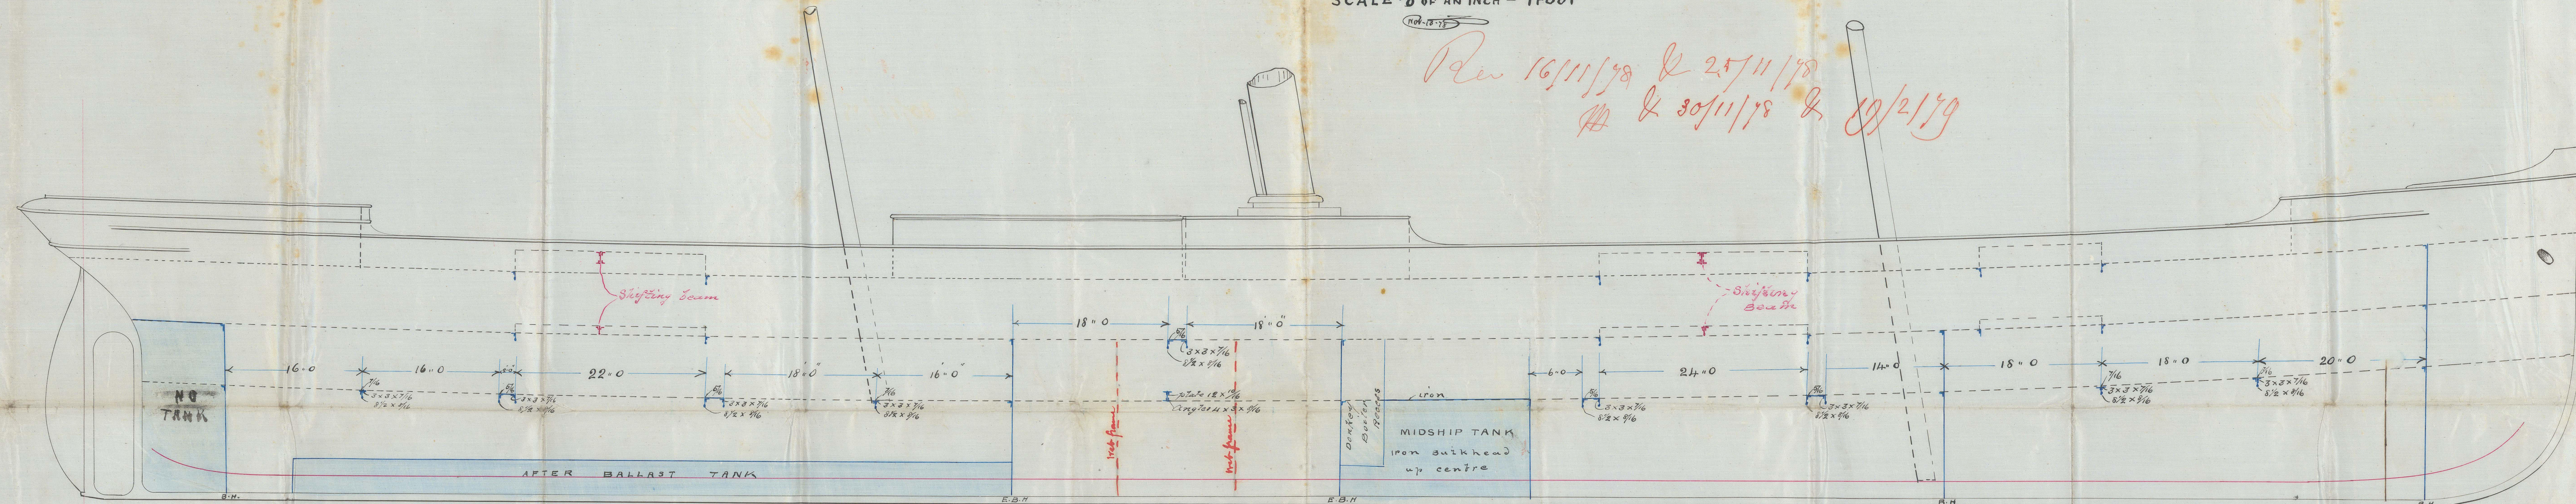

UPPER - DECK

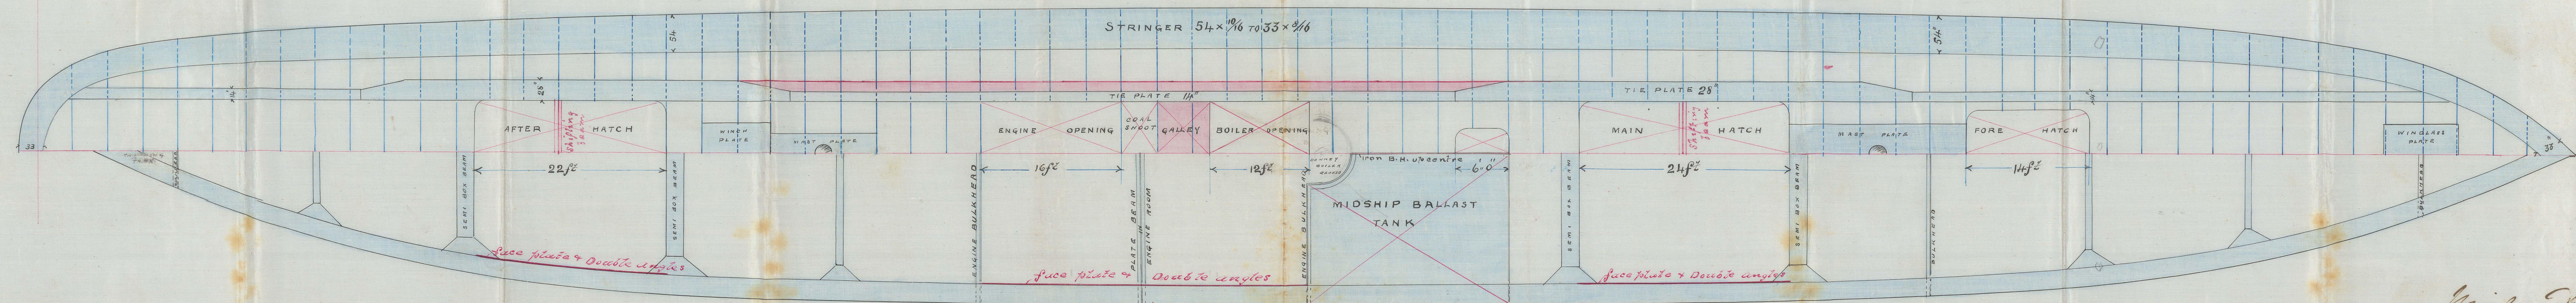

HOLD BEAMS AND STRINGERS

*19/11/78*

*Wigham Richardson  
Newcastle on Tyne  
14th Nov. 1878*

IRONS33-0167