


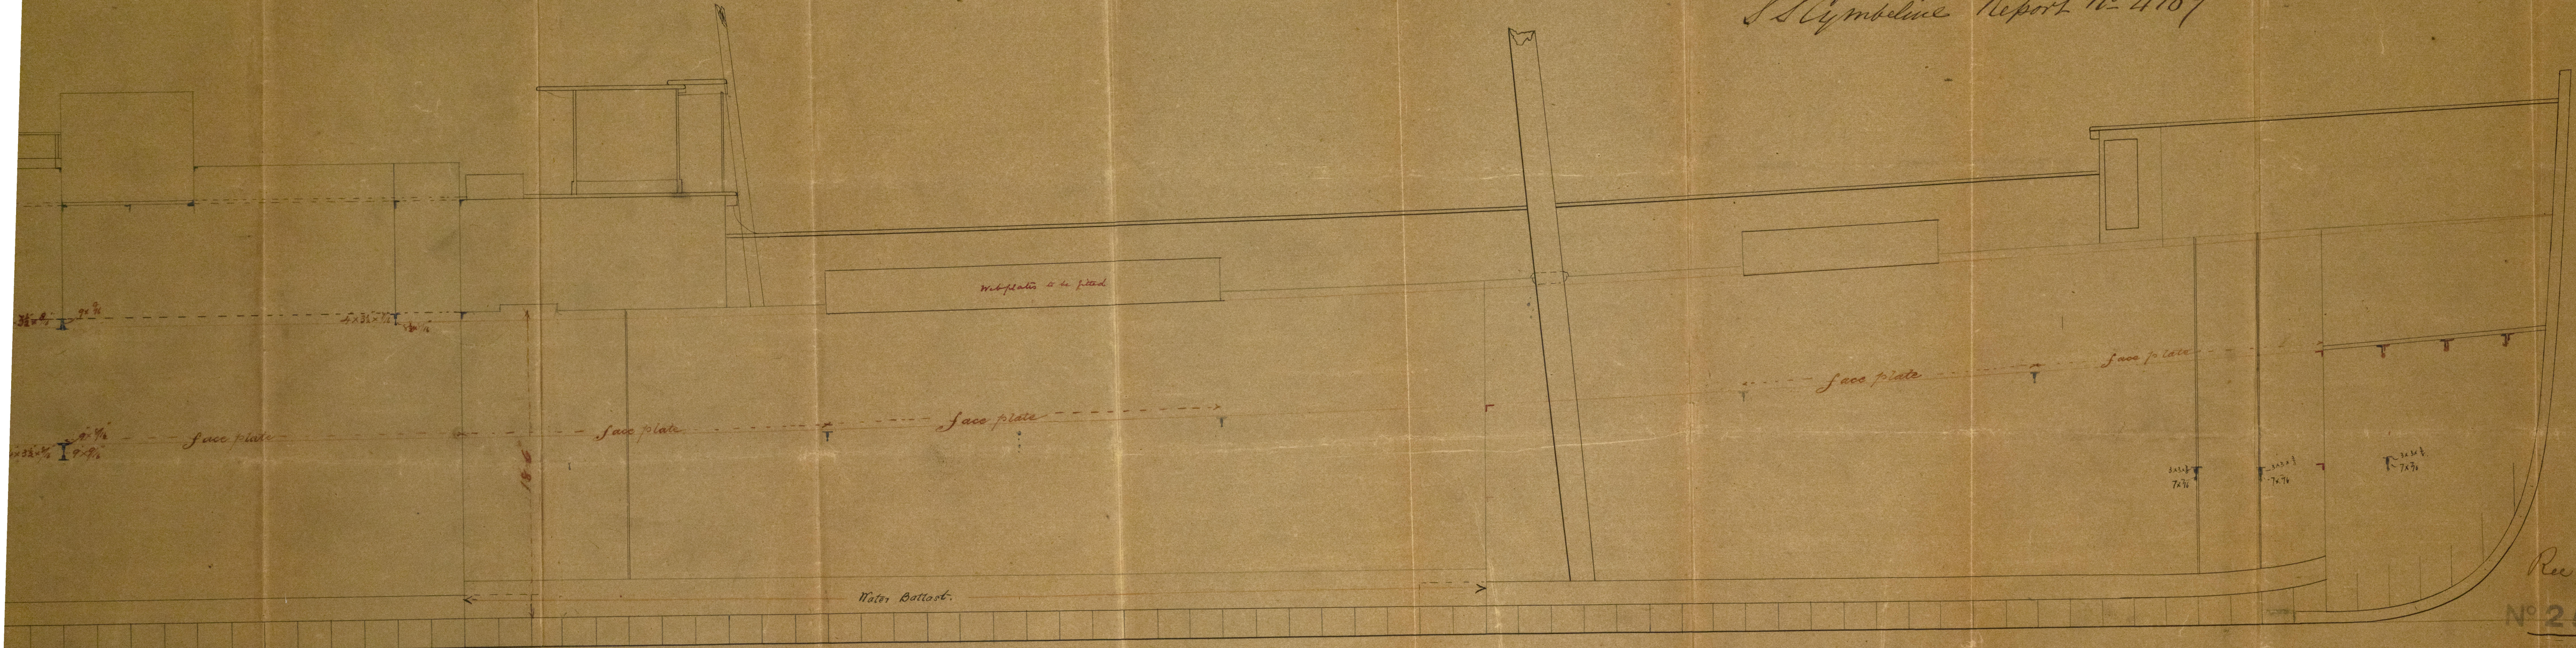

S. S. Cymbeline Report No 4167



SCALE - $\frac{1}{4}$ INCH TO 1 FOOT

Rec 16/8/78
No 252

W.D.
17/8/78

15 August 1878
W.D.