


Iron S.S. Ashburne Sunderland report No 12. 189

Iron Tower Masts for S.S. No 92.

Rev 29/11/78 for Auxiliary purposes.

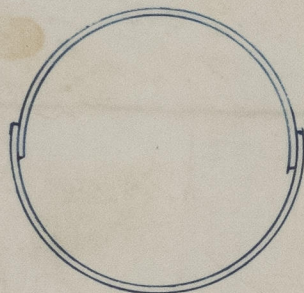

Fore Mast } 85'6"	Partners 26 1/2 x 8/16	Heel 19 1/4 x 6/16	Hounds 20 1/2 x 6/16	Head. 17 1/4 x 6/16
Main Mast } 78'9"	<i>Rule 7/16</i> 24 1/2 x 6/16	<i>Rule 8/16</i> 18 x 5/16	<i>Rule 8/16</i> 19 x 5/16	<i>Rule 8/16</i> 16 x 5/16

Seams double rivetted. Butt straps all treble
above wedging and double below. Butt straps all fitted
on outside of masts and 1/16" thicker than plates.
Doubled for 8 feet at wedging.

SHORT BROTHERS,


Iron Shipbuilders,

SUNDERLAND.

M.A.
30/11/78

27/11/78

28/11/78

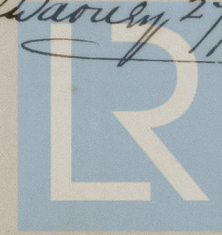

Lloyd's Register
Foundation

IRONS 34-0067















