


Dec 28/11/78

Iron &c. Ashburne Sunderland report Nov. 12. 189.


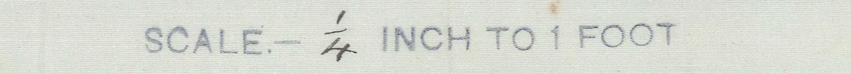


1878
SUNDERLAND.
W. Wainwright 14/5/78

180N534-0070

002/00

118371
Vilron

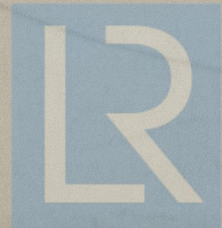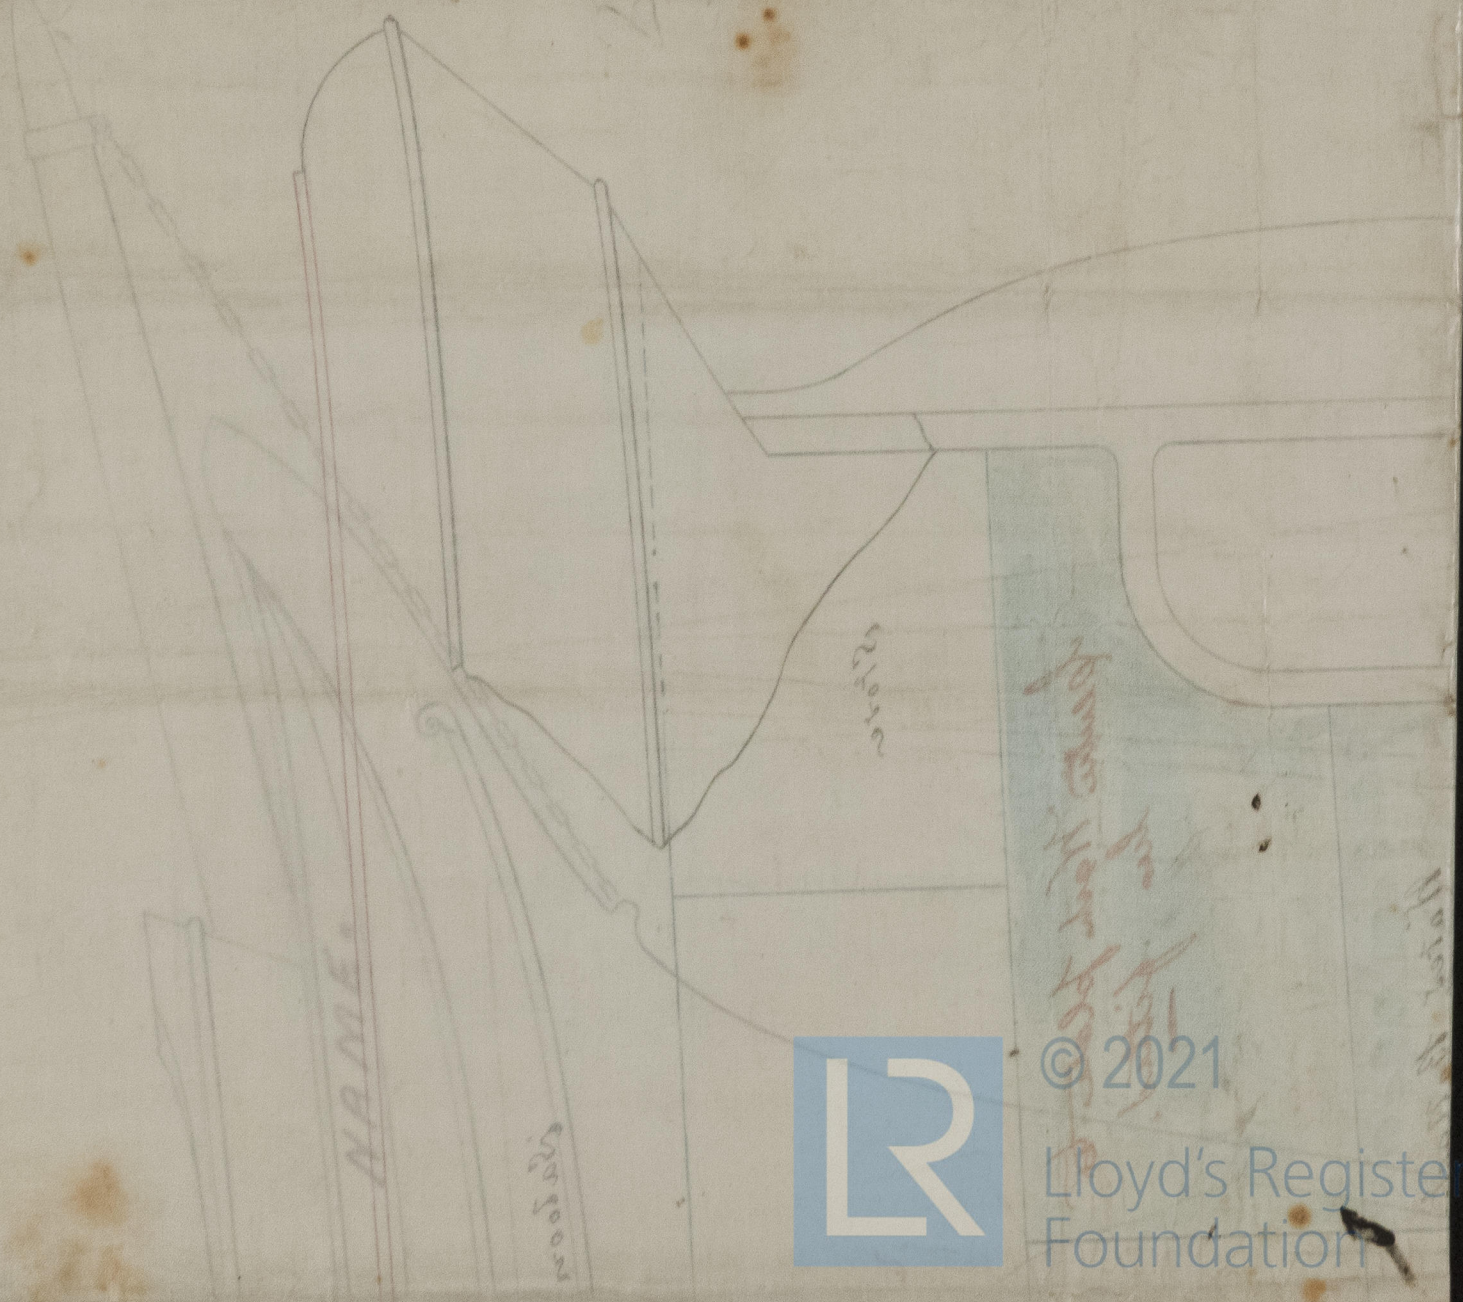

© 2021

Lloyd's Register
Foundation