


Sketches of Steering Gear of "Cairnbulg" & "Brilliant" also mast step of "Cairnbulg"


Scale $\frac{1}{2}$ in = 1 Foot

Brilliant
1613 Tons -

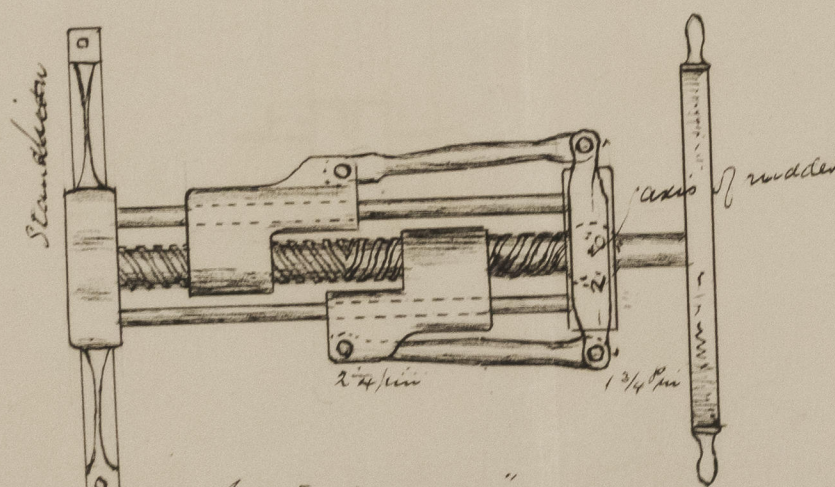


Main Screw - $4\frac{1}{2}$
Spindle - $3\frac{1}{2}$
Side levers $\left\{ \begin{array}{l} 2\frac{3}{4} \\ 2\frac{1}{2} \end{array} \right.$
Guide Rods - $2\frac{1}{4}$
Double Screw - $\left\{ \begin{array}{l} 2\frac{1}{4} \text{ pitch} \\ \frac{1}{2} \text{ thread} \end{array} \right.$

Cairnbulg.
1567 Tons.

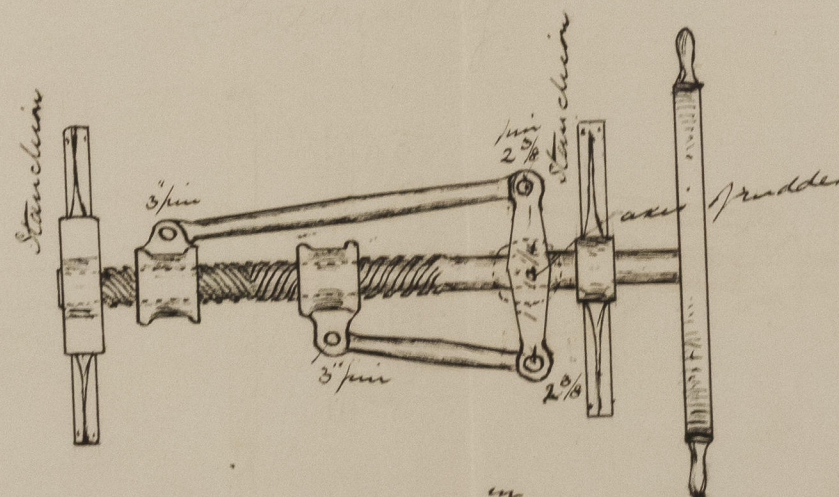

Main Screw - $5\frac{1}{2}$
Spindle $4\frac{1}{2}$
Side levers $2\frac{3}{4}$
Tie Rod Screw - $2\frac{1}{4}$ Pitch
 $\frac{1}{16}$ Thread

Cairnbulg
Keel of Fore & Main Masts.

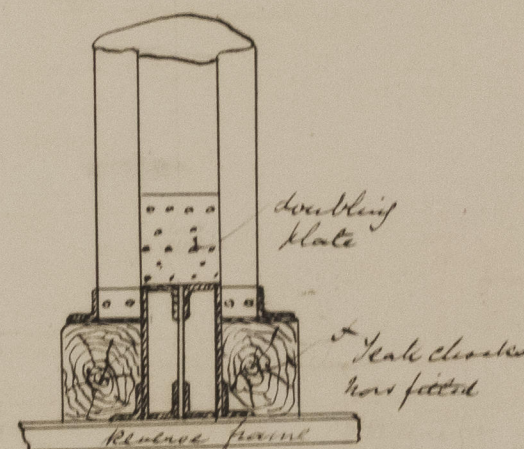

© 2021

Lloyd's Register
Foundation