

Midship Section

OF AN

IRON SCREW STEAMER

DIMENSIONS.

Rec 20/1/79 & 7/3/79

^{20.2.79}
~ N^o, 161, ~

LENGTH OVER ALL

Do. B.P.

133 - 8

BREADTH

129 - 2

DEPTH IN HOLD

20 - 9 1/2

Do. MOULDED

10 - 7

TONNAGE O.M.

11 - 2

HORSE POWER

155

CLASS

50

90 H.P.

1/2 Beam 10.4

Depth 11.8


1/2 Girth 18.4

40.6 x 128 = 5196.8


Depth to length 10.8

Breadth do 6.1

2 Bows used: of stock 5 cut each
1 Stream " " 1 1/2 " "
1 Ridge " " 3/4 " "
135 fathoms 13/16 Stud chain cable
45 " 9/16 Stream chain
75 " 6" Towline
90 " 4" Warp

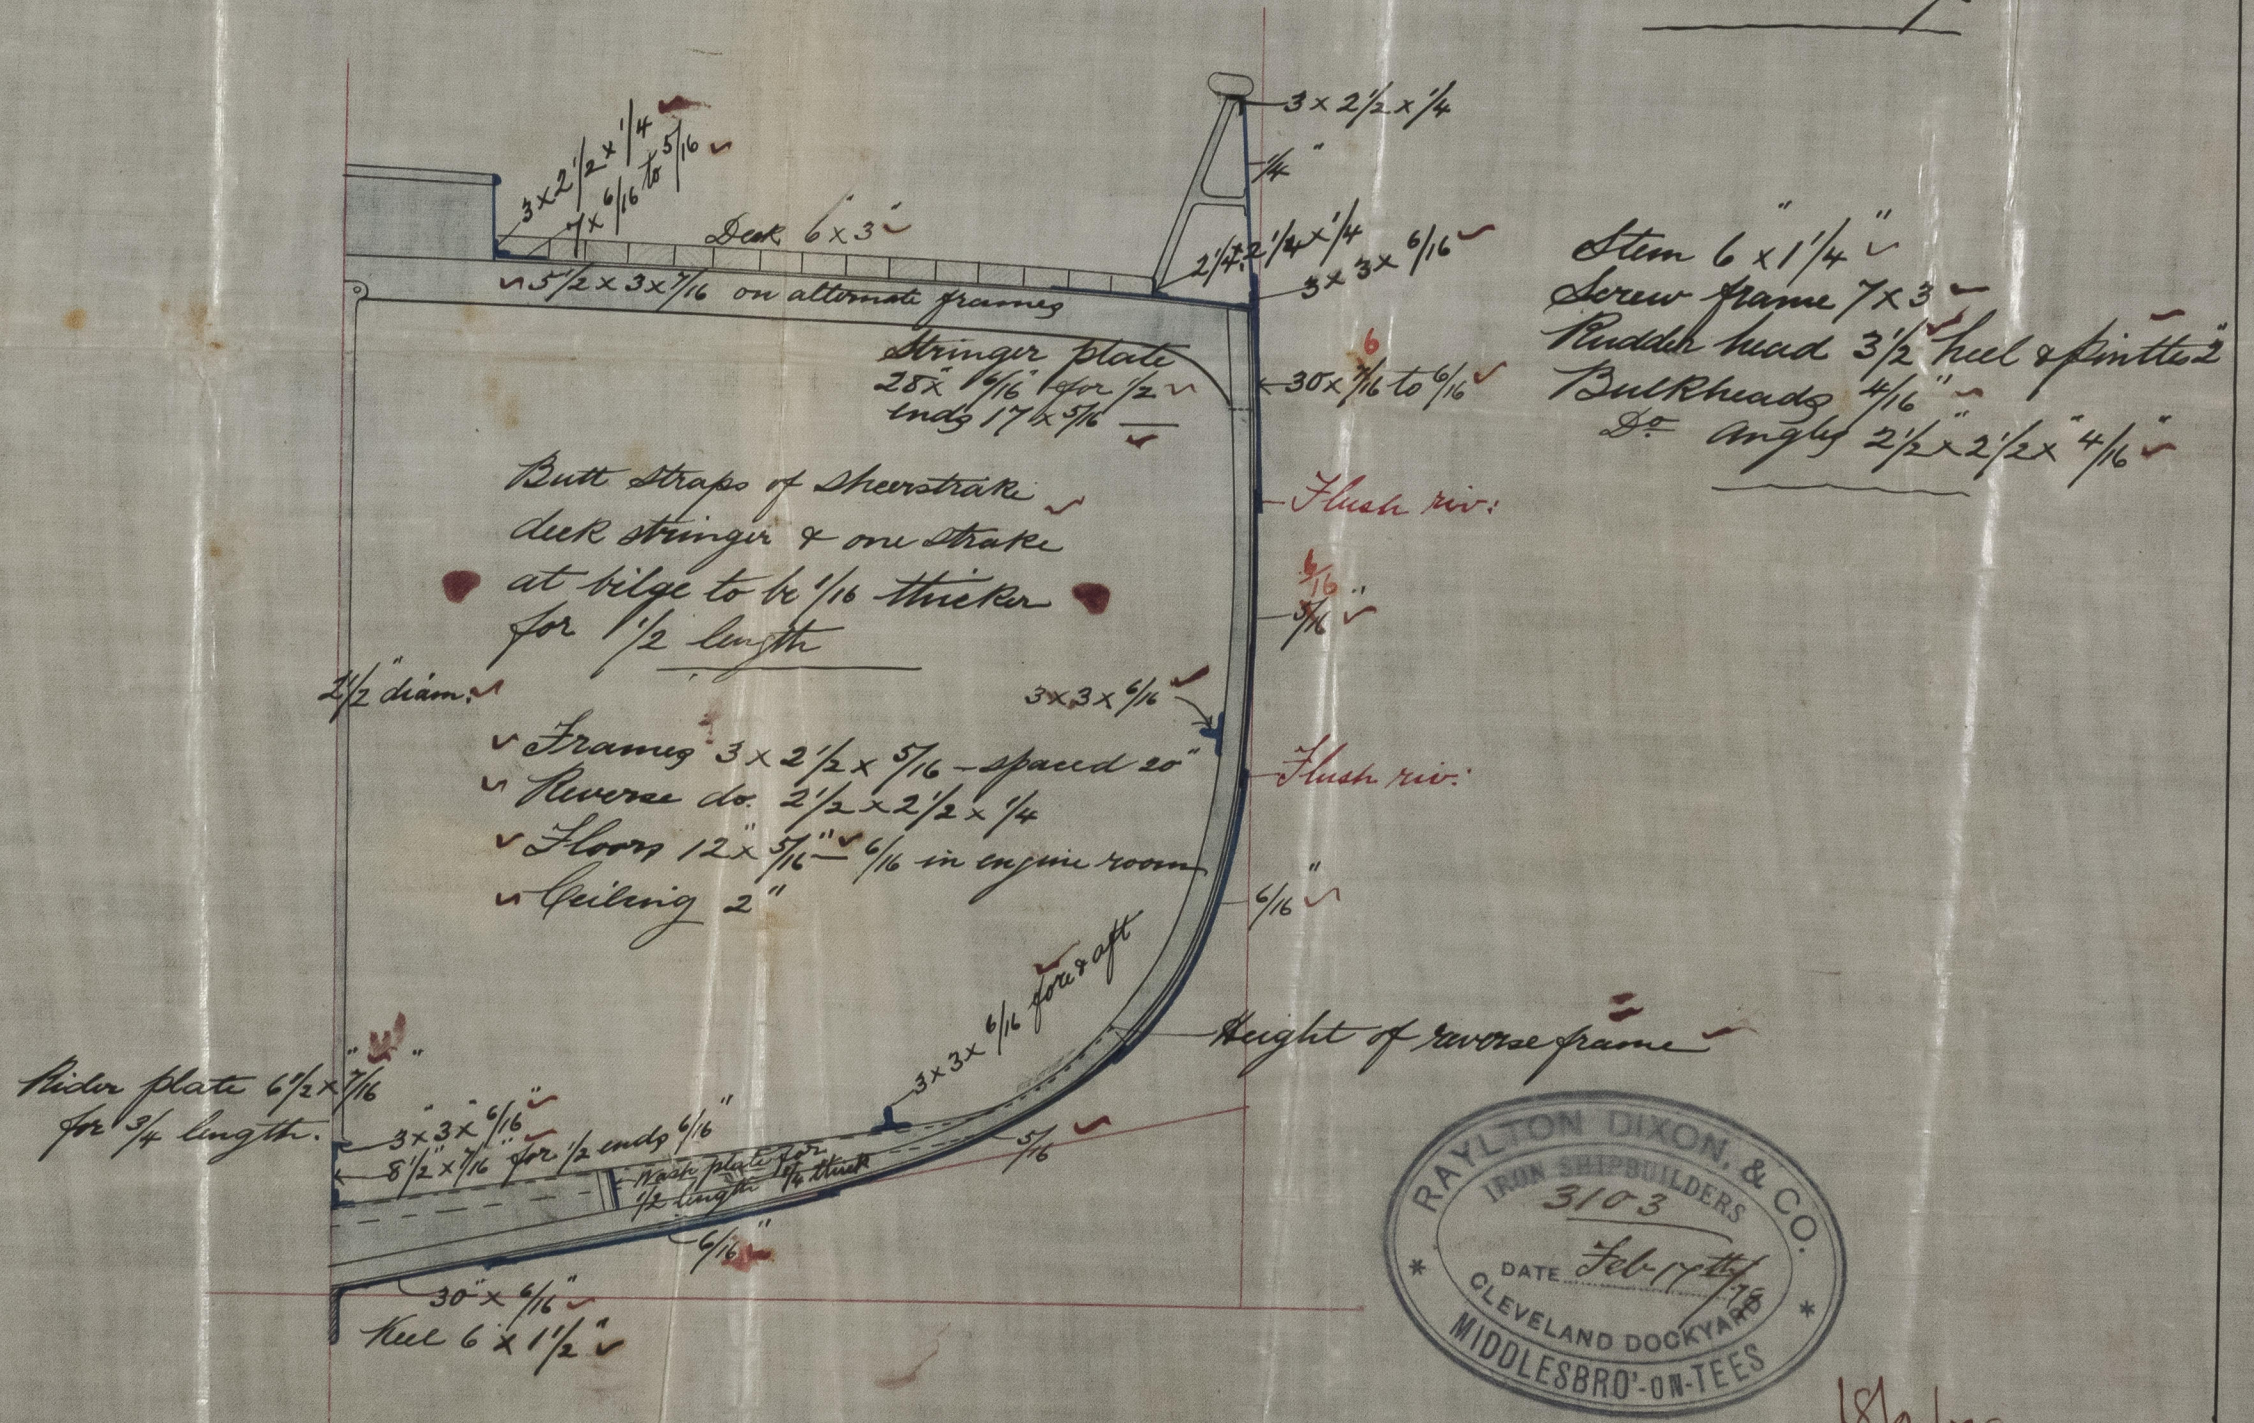

Scale 1/2 = one foot

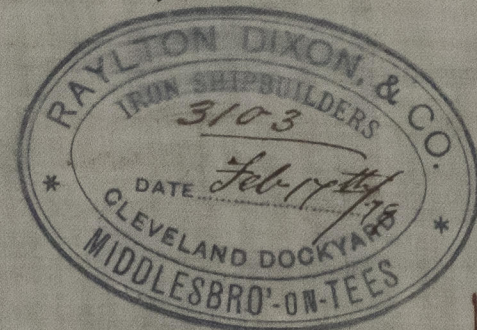

M.D.
7/3/79

18/2/79
John

J.H.
28/1/79