



S.S. "Velocity" Report No. 1213.  
**ELEVATION S.S. 161.**

*Plan 20/2/79 & 7/3/79*  
*HH*

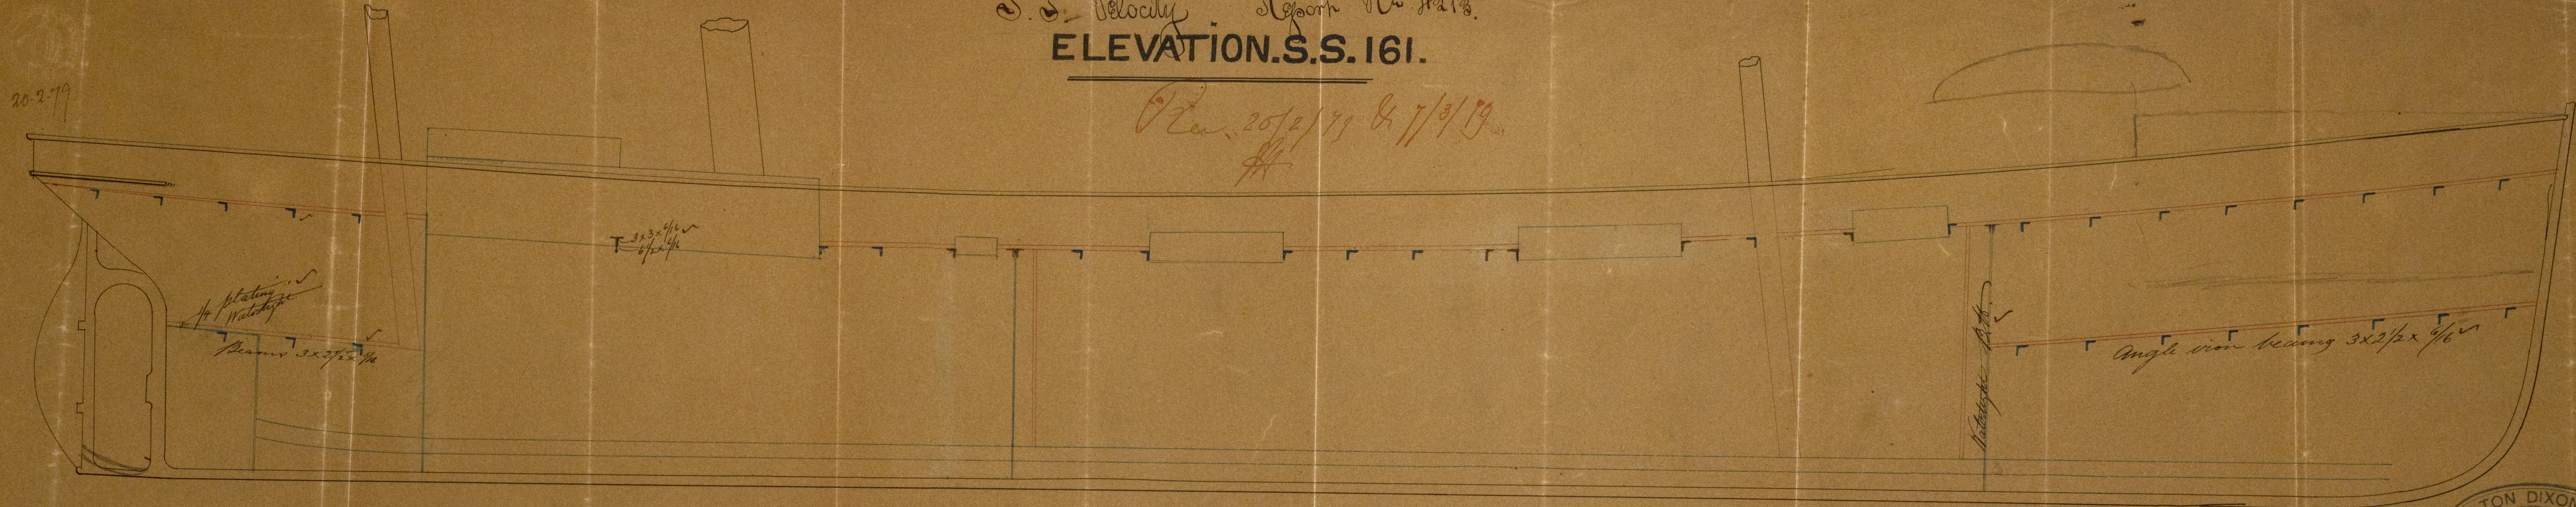

*J.H.*  
*20/2/79*

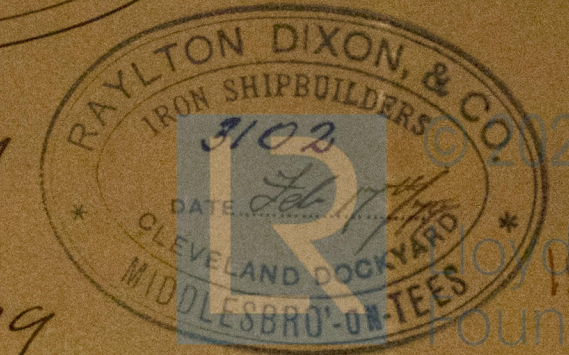

*18/2/79*  
*mm*

180535-0072