
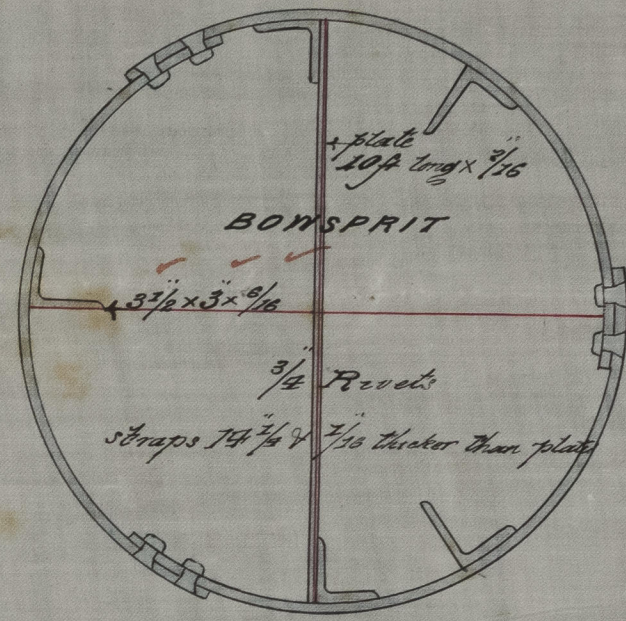
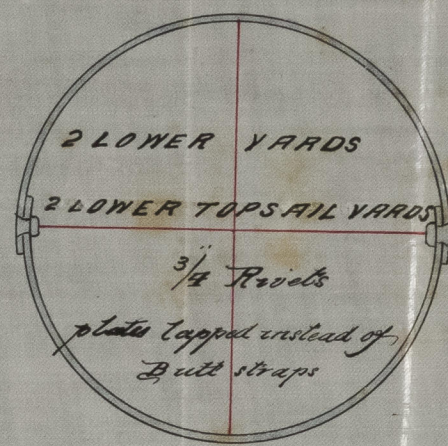


*Lloyds*


BARQUE  
N<sup>o</sup> 98

*Lady Elizabeth*  
Sunderland report N<sup>o</sup> 12.228 (unpublished)

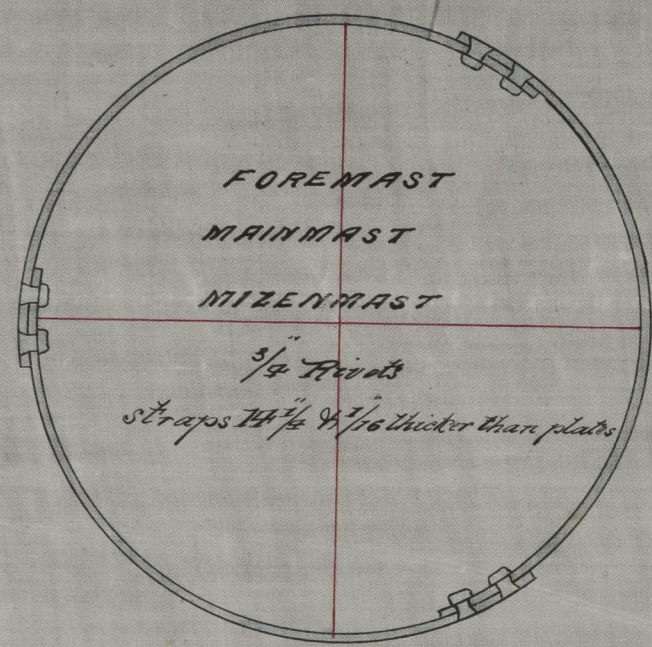

*Barque register*

	LENGTH	PARTNERS	HEEL	HOUNDS	HEAD	CHEENS
Foremast	78'-10"	28' x 7/16 ✓	20' x 9/16 ✓	22' x 9/16 ✓	18' x 9/16 ✓	9/16 ✓
Mainmast	80'-8"	28' x 7/16 ✓	20' x 9/16 ✓	22' x 9/16 ✓	18' x 9/16 ✓	9/16 ✓
Mizzenmast	83'-6" ✓	23' x 9/16 ✓	17' x 9/16 ✓	18' x 9/16 ✓	15 1/2' x 9/16 ✓	9/16 ✓
		CENTRE	1st QUARTER	2nd QUARTER	3rd QUARTER	ENDS
2 Lower Yards	76'-0"	19' x 9/16 ✓	18 1/2' x 9/16 ✓	17 1/2' x 9/16 ✓	14 1/2' x 9/16 ✓	9 1/2' x 9/16 ✓
2 Lower Topsail do	65'-0"	16' x 9/16 ✓	15 1/2' x 9/16 ✓	14 3/8' x 9/16 ✓	12' x 9/16 ✓	8' x 9/16 ✓
	LENGTH outside BED	BED	HEEL	CAP		
Bowsprit	21'-10"	27' x 9/16 ✓	22' x 9/16 ✓	17 1/2' x 9/16 ✓		

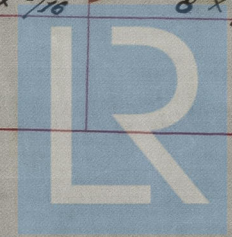

© 2021  
Lloyd's Register  
Foundation

MAN 535-0128