


21/12/78

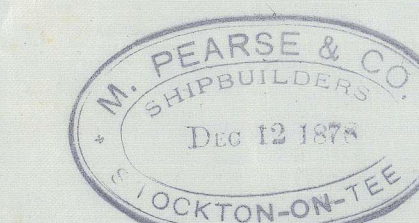

Rec 21/12/78
JH

Length from After part of Stern to Fore part of Stern post 265.7
Breadth Moulded 33.10
Depth Moulded 23.9
Depth to top of Floors 22.0
10 to 11 Decks to Length from Upper Deck
14 to 15 " " Middle Deck
7 to 7 1/2 Breadths to Length

ELEVATION

of


No 170 SS

Wylmores Report No 182347

Scale 1/4 Inch to one Foot

265.0" x 33.0" x 22.0"


Class 100A 3 1/2" Rule

 

I
as many beams fitted
as Engines & Boiler will admit

Wylmores Report 25th Dec 78
182347
Lloyd's Register
Foundation

1RONS35-0151

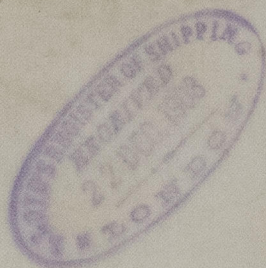




© 2021

Lloyd's Register
Foundation