

3/10/78


*S. S. "Lurene" of Barrow*  
*Guano Report No. 167*

**DIMENSIONS**

Length between Perpendiculars -- 245.0  
Breadth Moulded -- 36.0  
Depth in Hold -- 22.9

**WILLIAM HAMILTON & CO**

**Shipbuilders**  
**PORT GLASGOW**  
*11/10/78*

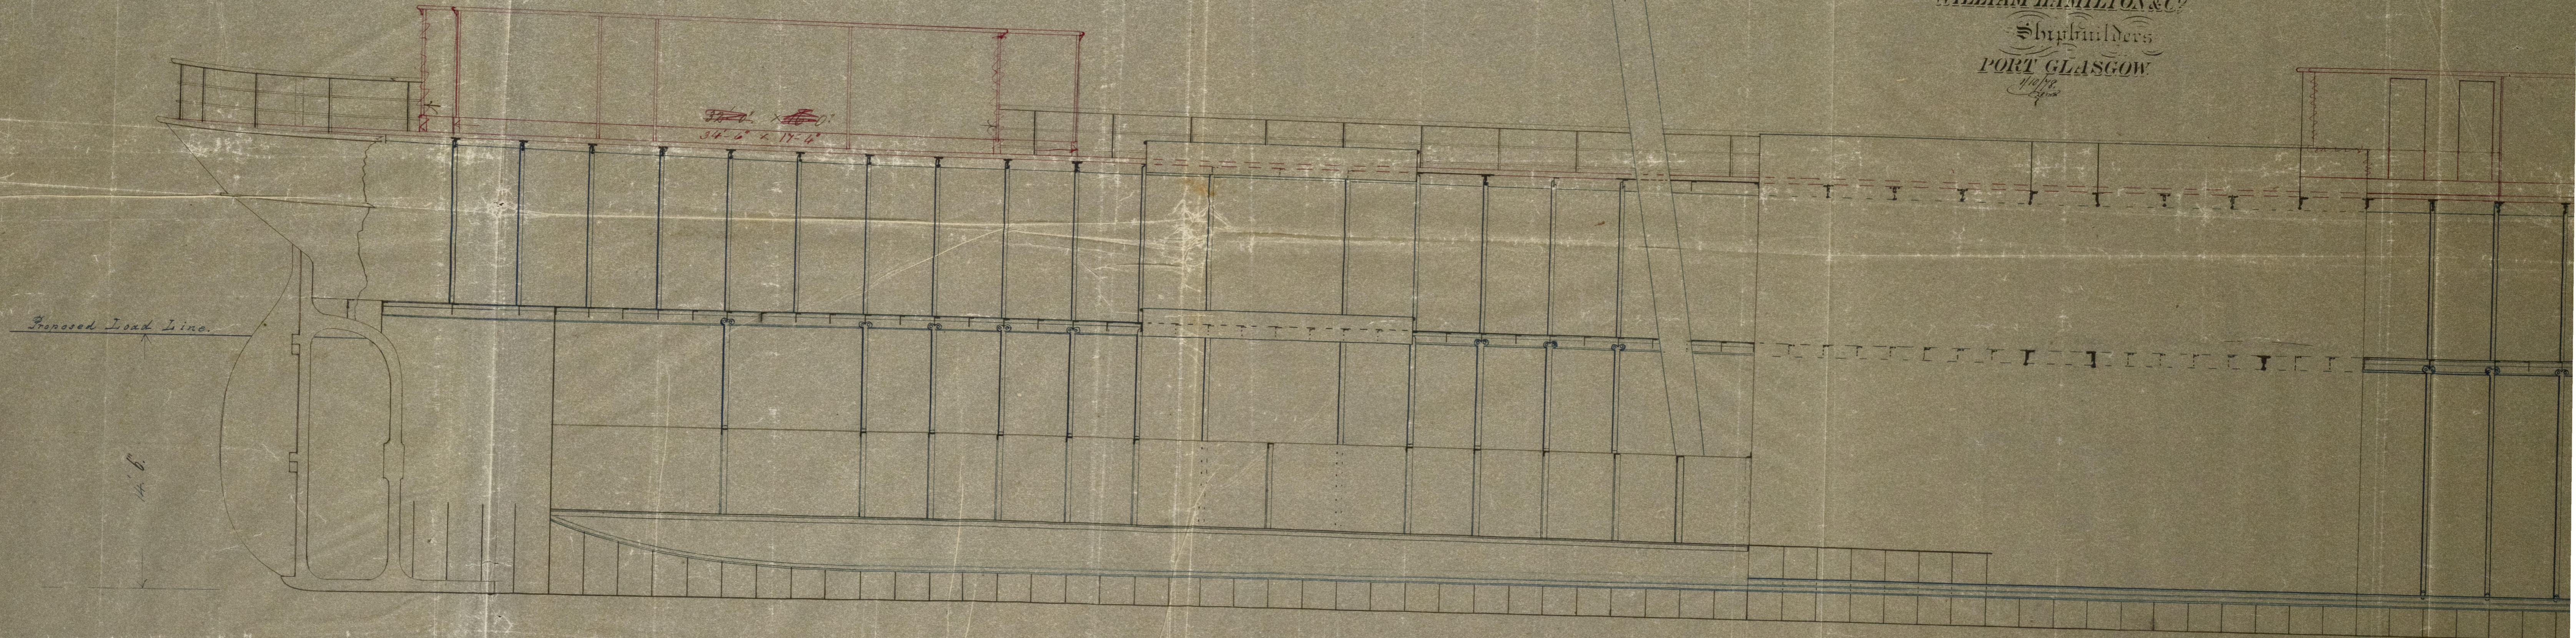

**S. S. N° 47.**


**LONGITUDINAL**

**SECTION**


Length between Perpendiculars	-- 245. 0
Breadth Moulded	-- -- 36. 0
Depth in Hold	-- -- 22. 9

Shipbuilders  
PORT GLASGOW.  

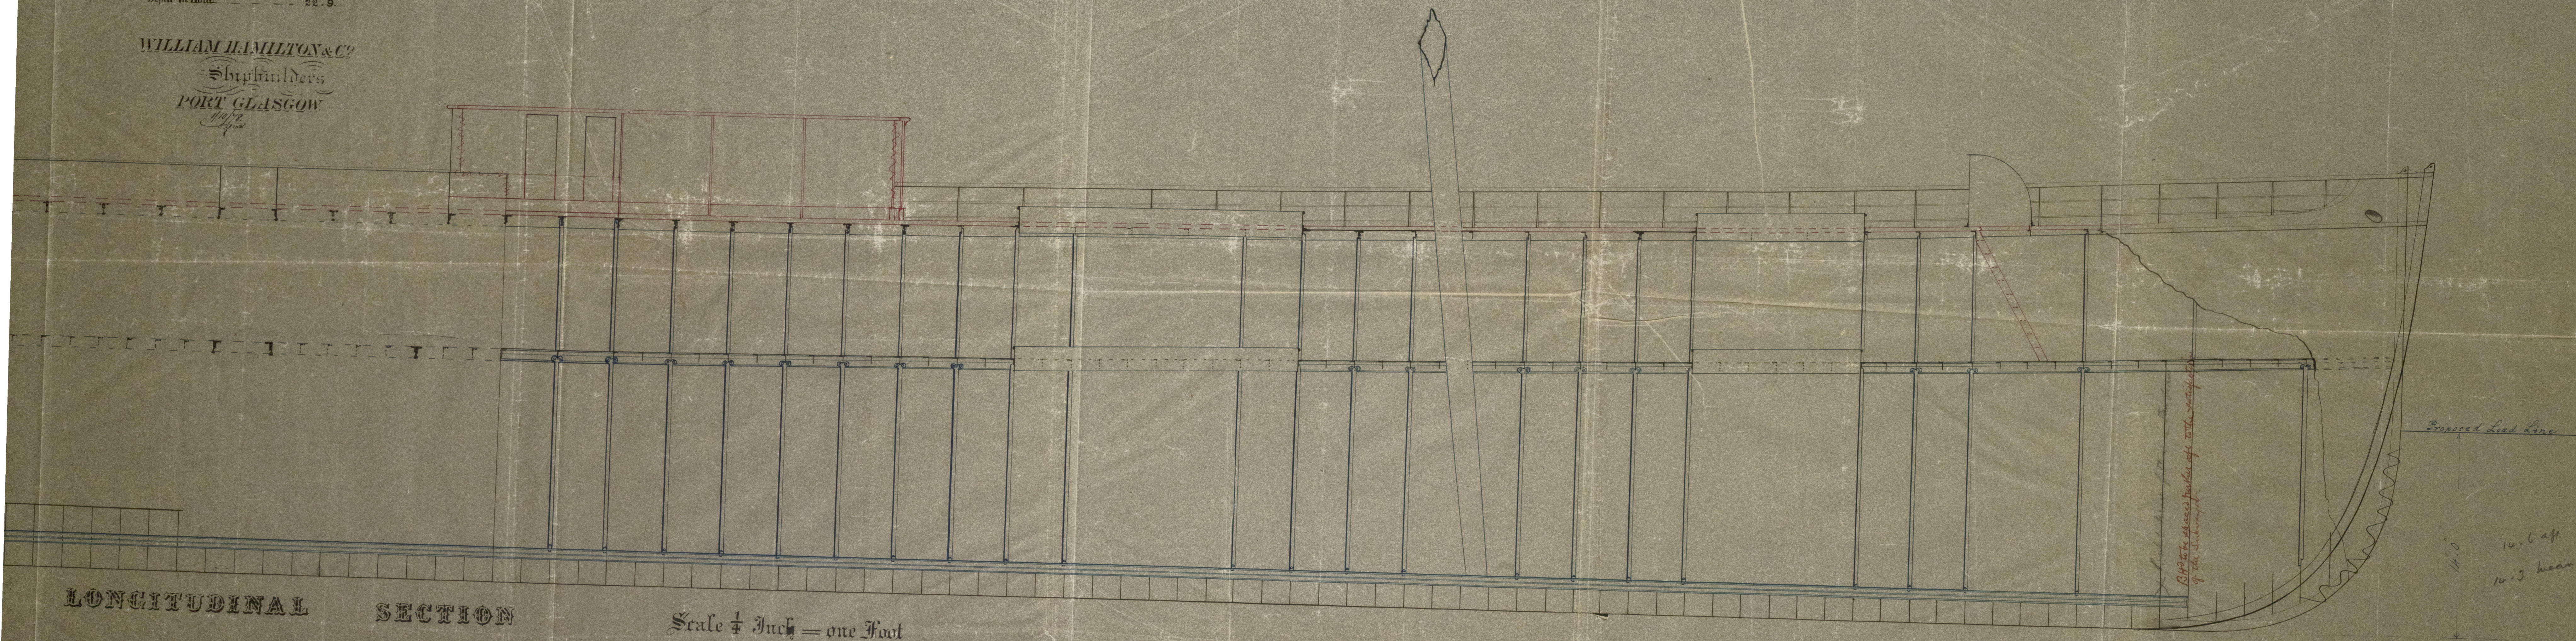

## SECTION

Scale  $\frac{1}{4}$  Inch = one Foot

J.M.  
3/10/78

IRON 536-0031