

S. S. "Potaro"
 Reprob No. 4246

Length over all 238' 9"
 Length B.P. 230' 0"
 Breadth extreme 31' 6"
 Breadth moulded 31' 4"
 Depth moulded 18' 1"
 Depth of hold to floors 17' 6"
 Tonnage 0.22

Scale $\frac{1}{2}$ " = one foot

Class 100 A. 1 at Lloyd's

Section thro Engine Room


Section thro Hold

Section thro Quarter Deck

Rec 15/2/79

11' 4" under 12 depths in length
 7' 1" under 7 1/2 breadths

187479

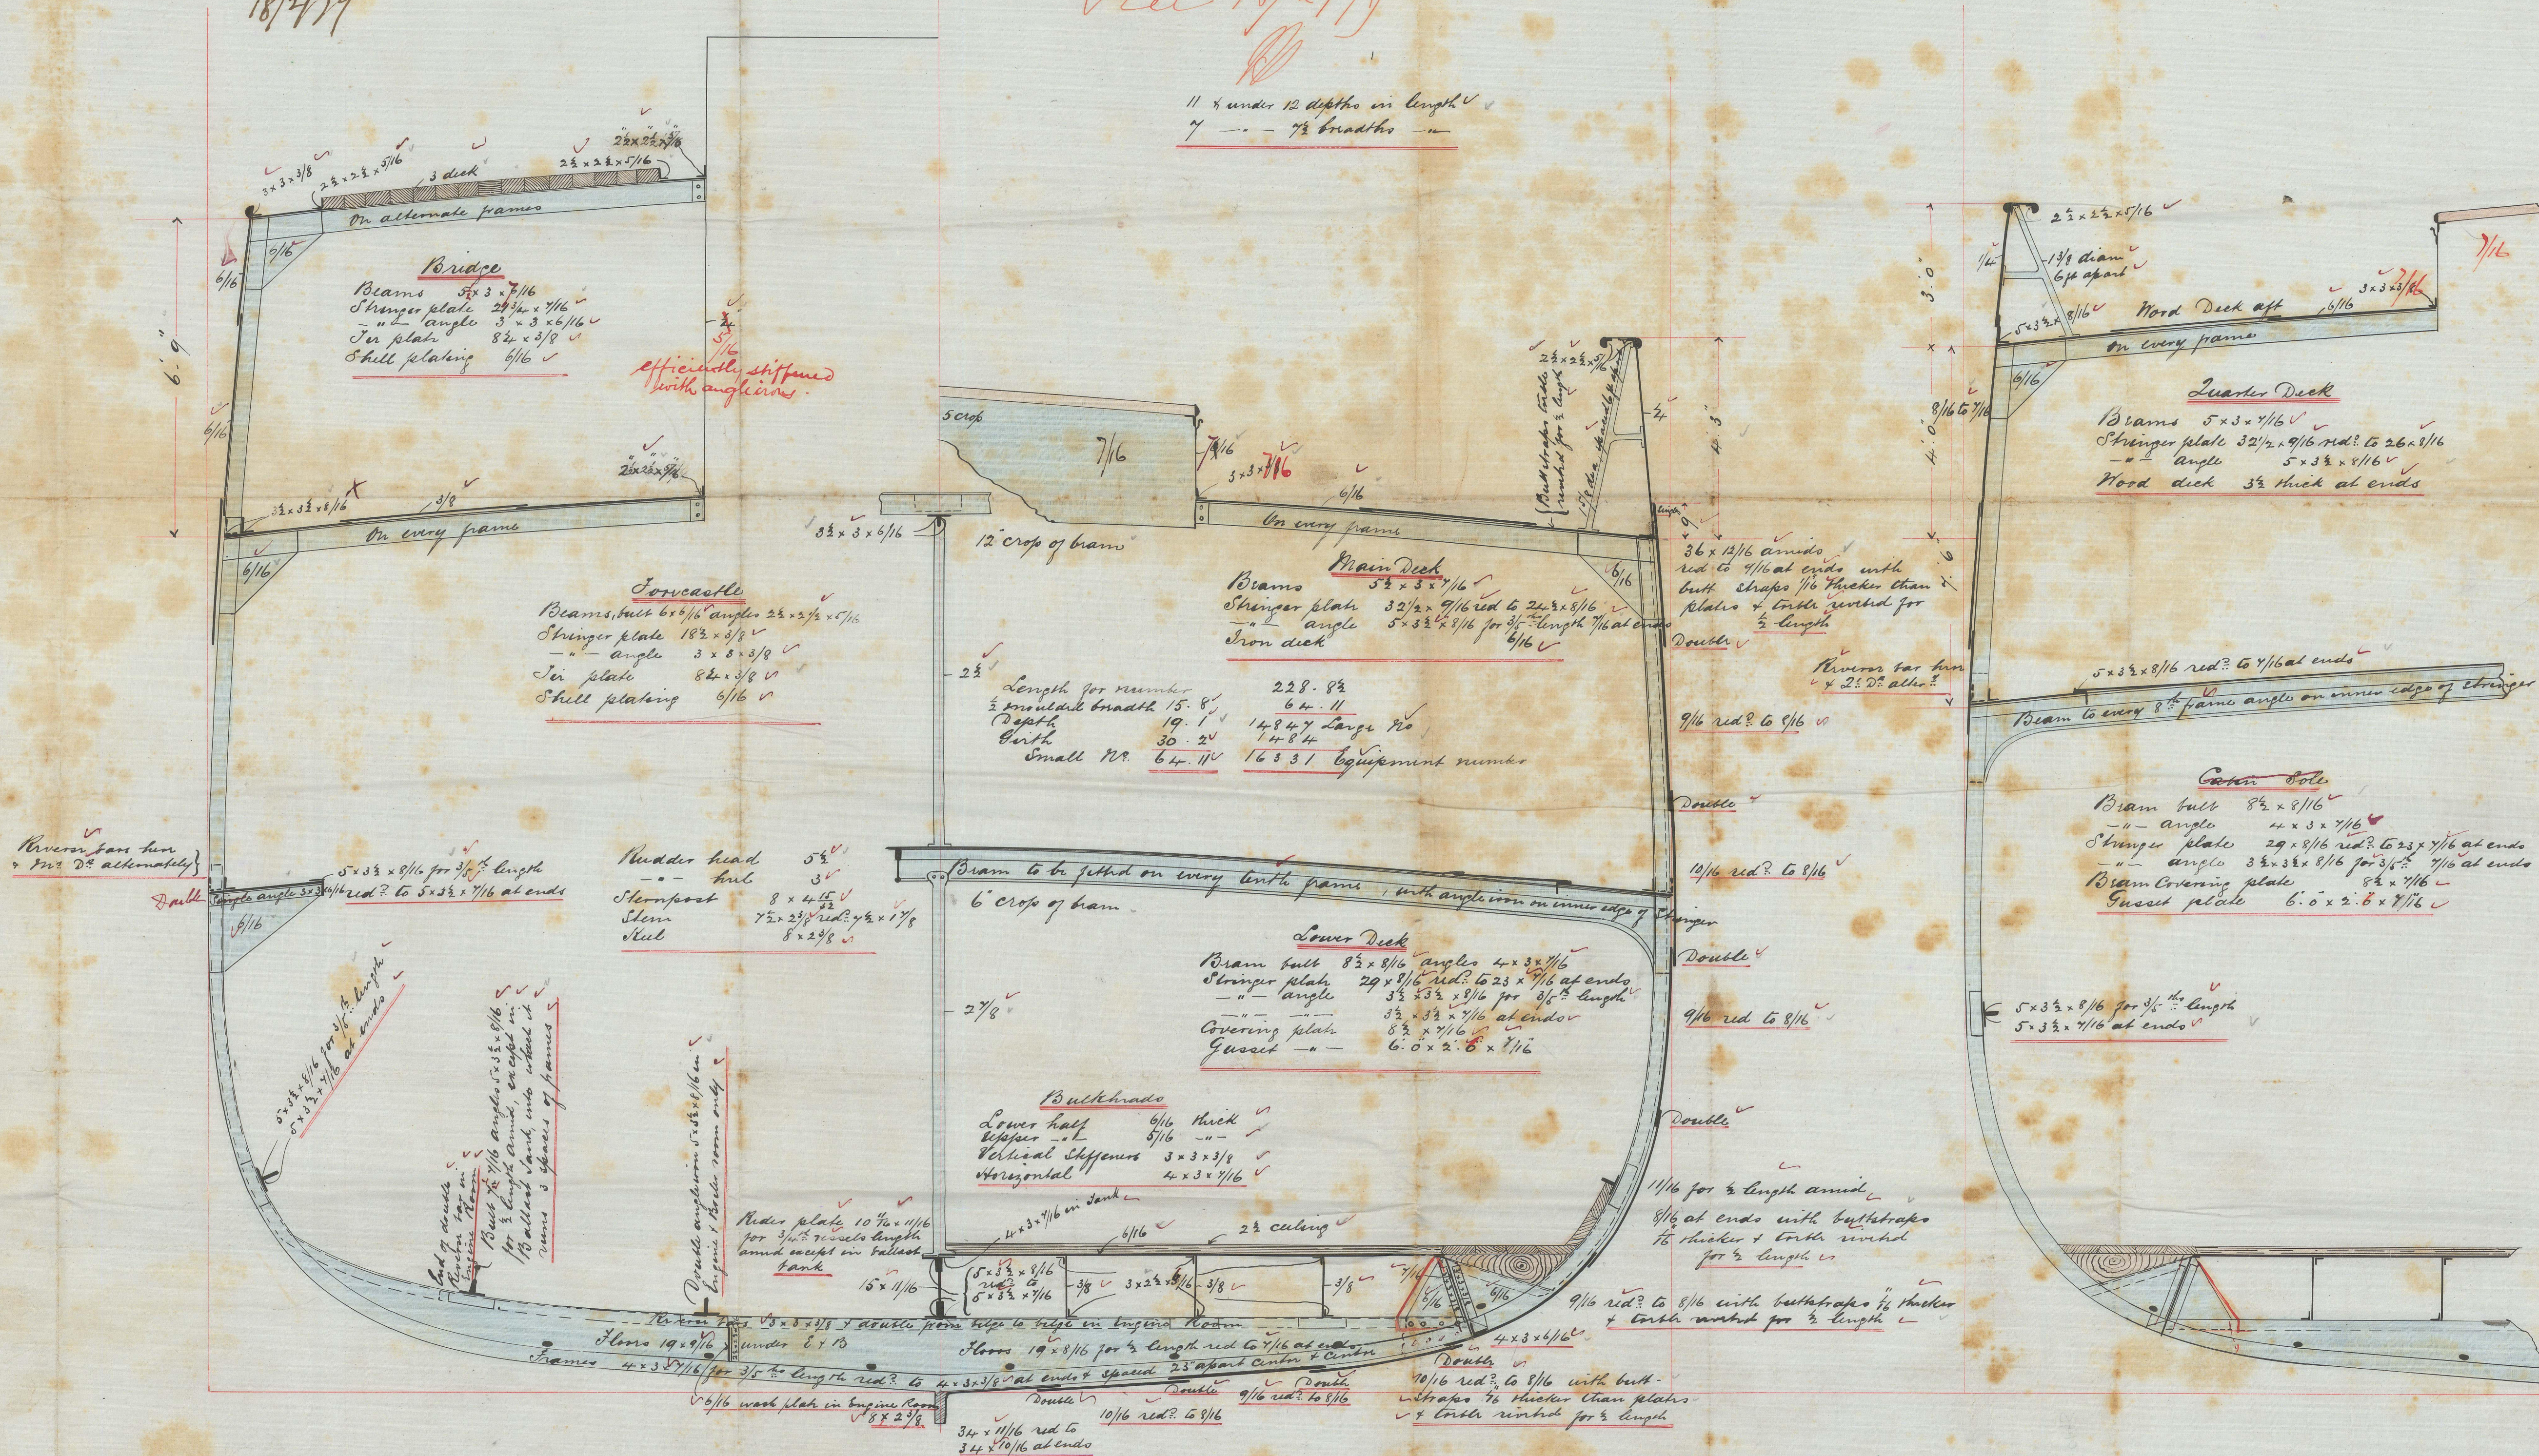

Nº 82 SS.

Shell Plating in way of double bottom
 $\frac{1}{16}$ thick red to $\frac{1}{16}$

17/2/79

14/2/79

EDWARD WITHEY & CO

IRON SHIPBUILDERS

HARTLEPOOL

Henry Withey

100's Register

13.2.79

IRON 536-0145