

S.S. "British Crown." Belfast report N^o 2646.


S. S. N^o 127

410' 0" x 39' 0" x 29' 0" (fold)

To class 100 A1 at Lloyds

scale $\frac{1}{2}'' = 1000$ ft.

Rev. 9/1/79

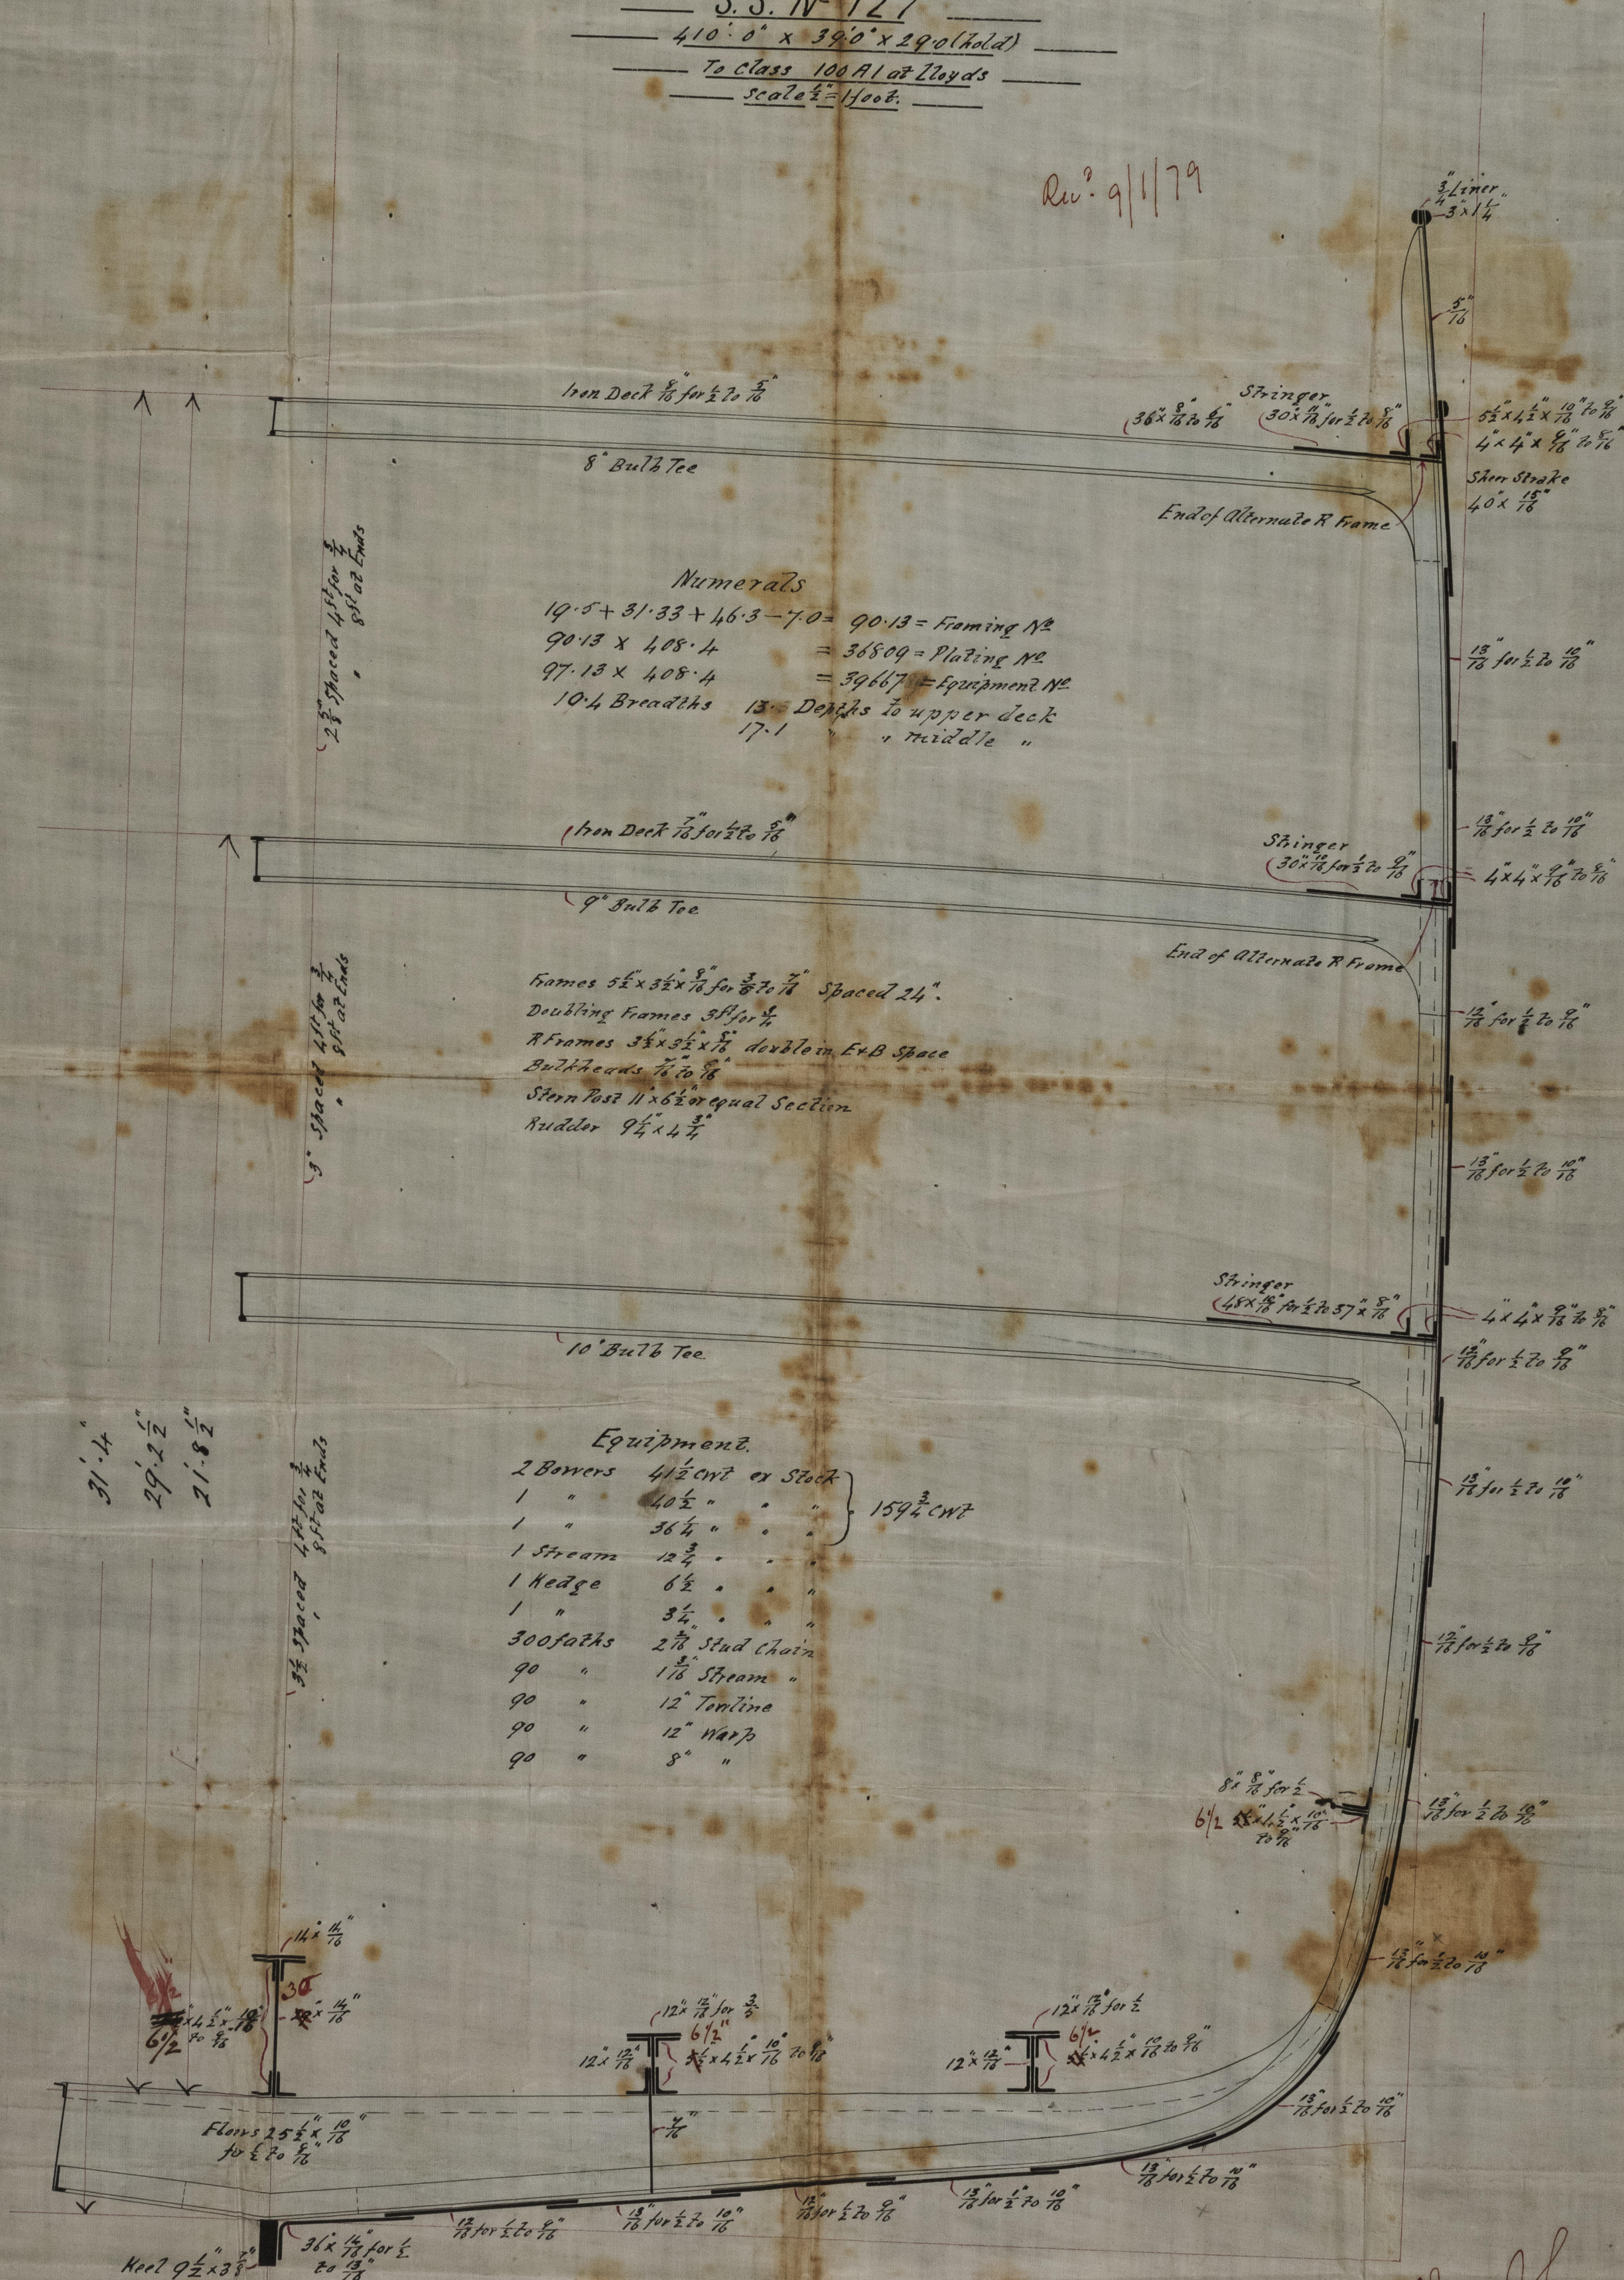

~~copy~~
J.W.S.
11/1/79

Jan 7th

1879



Lloyd's Register
Foundation

IRONS37-0090