

Letter to Hartlepool
10th July 1879



Pumping arrangements
No 83 S.S.
Scale 1/8 = One foot

W
7.2.79

S. S. "Gracie"

Report on Hull No 4280
- Engines No 235

J. B. 1.4.4PL
7.7.79

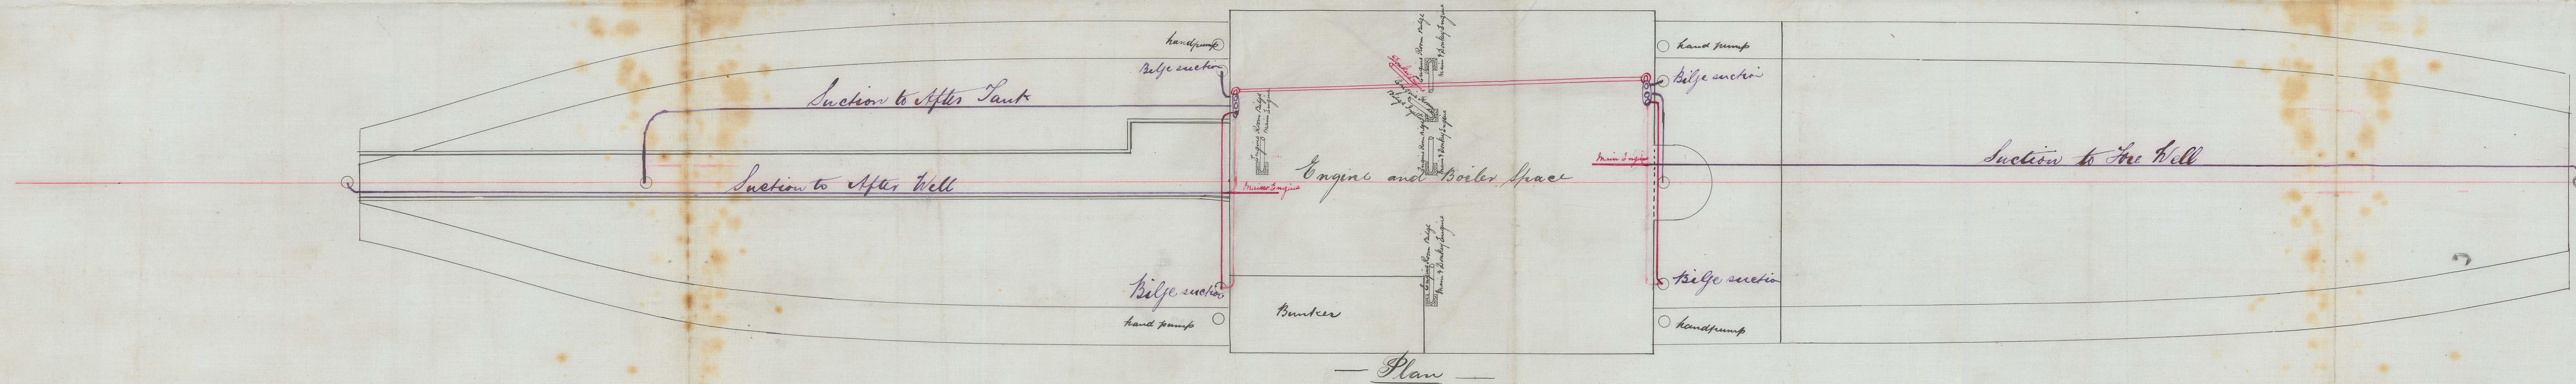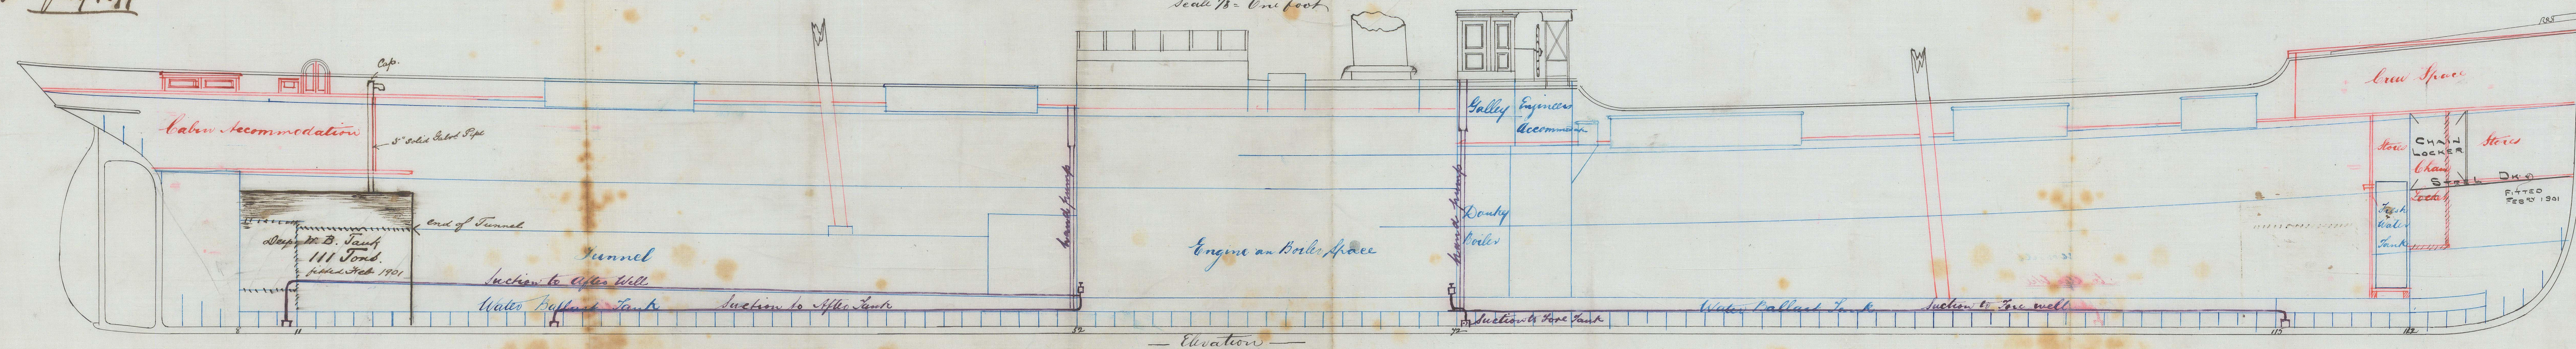

EDWARD WITHEY & CO
IRON SHIPBUILDERS
HARTLEPOOL

July 1st 1879
Henry Withey