


29/5/79

PROFILE N^o 238.9 S.S. "MALAFA" Glasgow Report No 4975
SCALE 1/8 INCH TO A FOOT

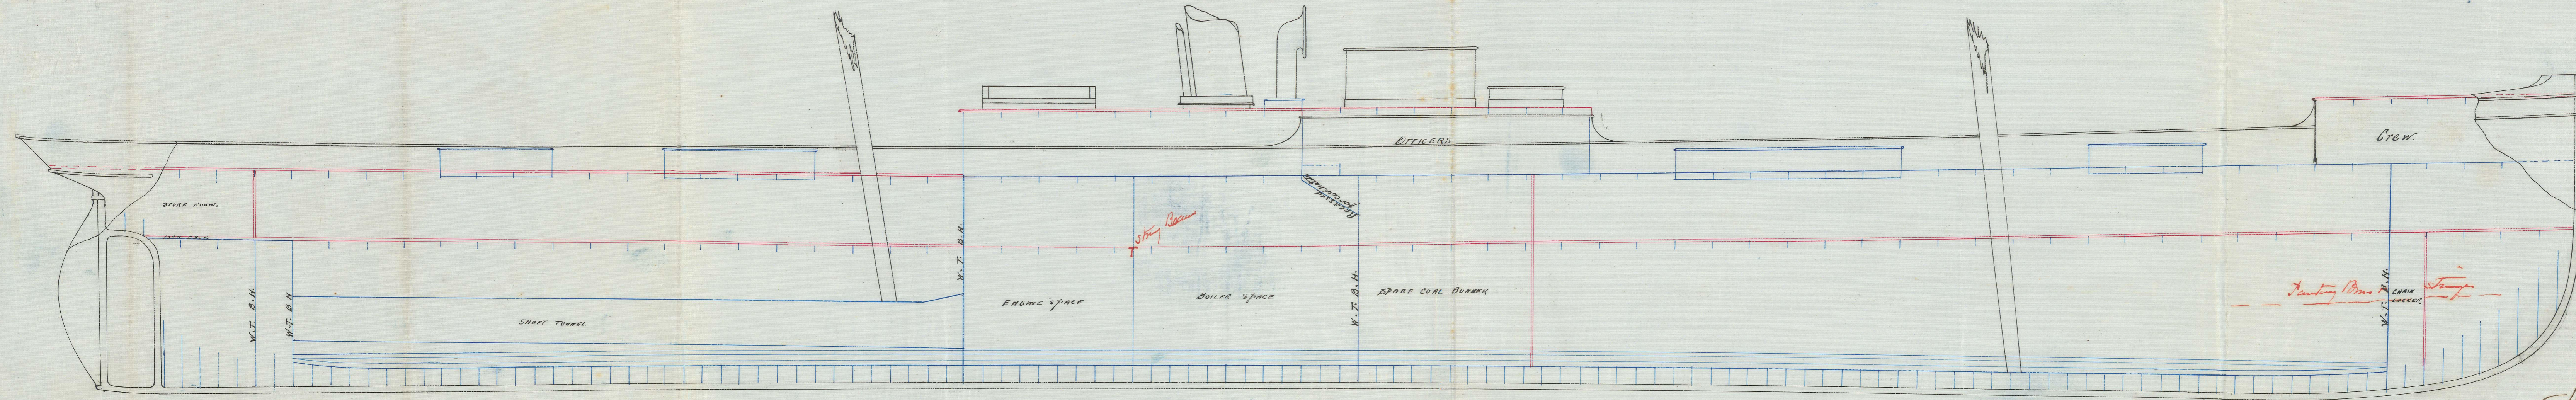

28/5/79

ALEX STEPHEN & SONS
SHIPBUILDERS AND ENGINEERS
GLASGOW

29/5/79

DRAWING No 1339
29/5/79
© 2021
R
Register
Foundation

IRONS38-0056