

Letter to Dundee
27 Oct 1879

= Scale $\frac{1}{4}$ " = one foot =


S.S. James Hall

24 Oct 1879

Y.S.

M

27.10.79

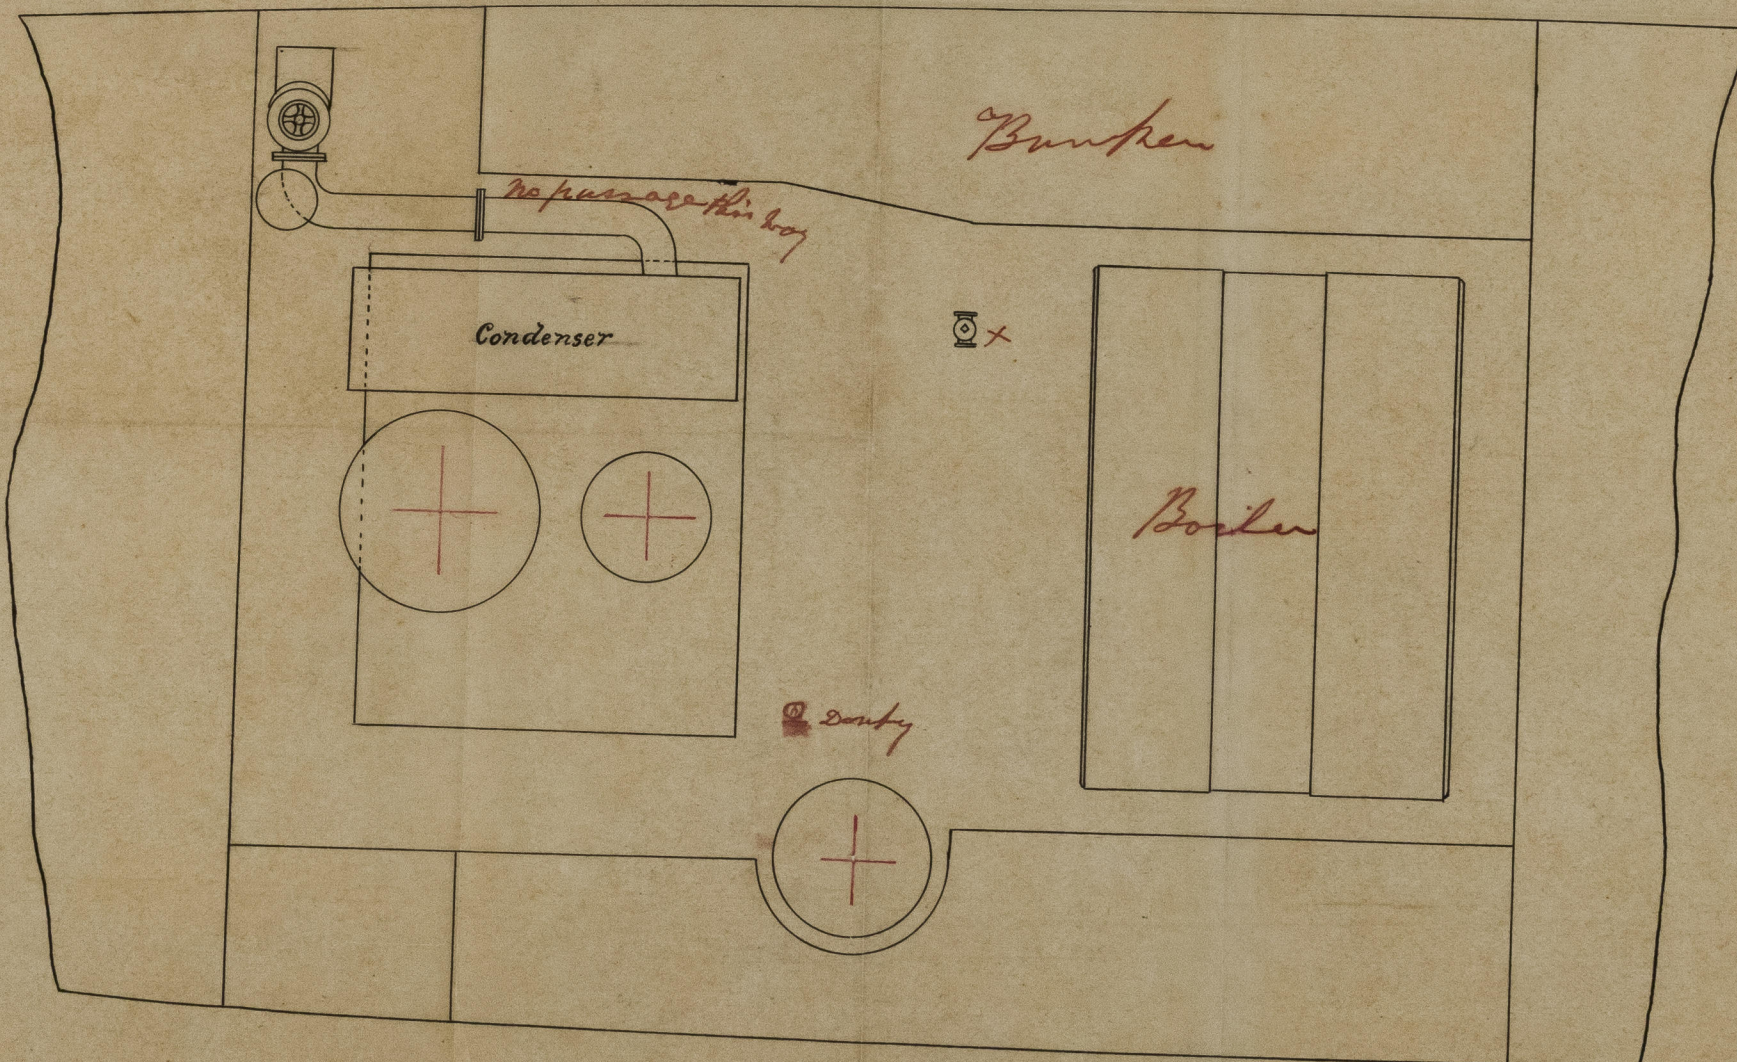

© 2021

Lloyd's Register
Foundation

IRONS38-0089