

Letter to W. Hartlepool
10 April 1879

2 hand pumps on deck
no. 1 & 2 on deck

10 4.17


N^o 206720755.
Sketch showing pipe arrangement
Scale 1/8" = 1 foot

Engine & Boiler Space.

Report on Halcote 4291
" " Engines - 241
S. S. "Whistler"

Report on Halcote 4290
17. 11/66 - Report N^o 229 on engines
S. S. Hartville

S.B
17. 11/66
8/4/79

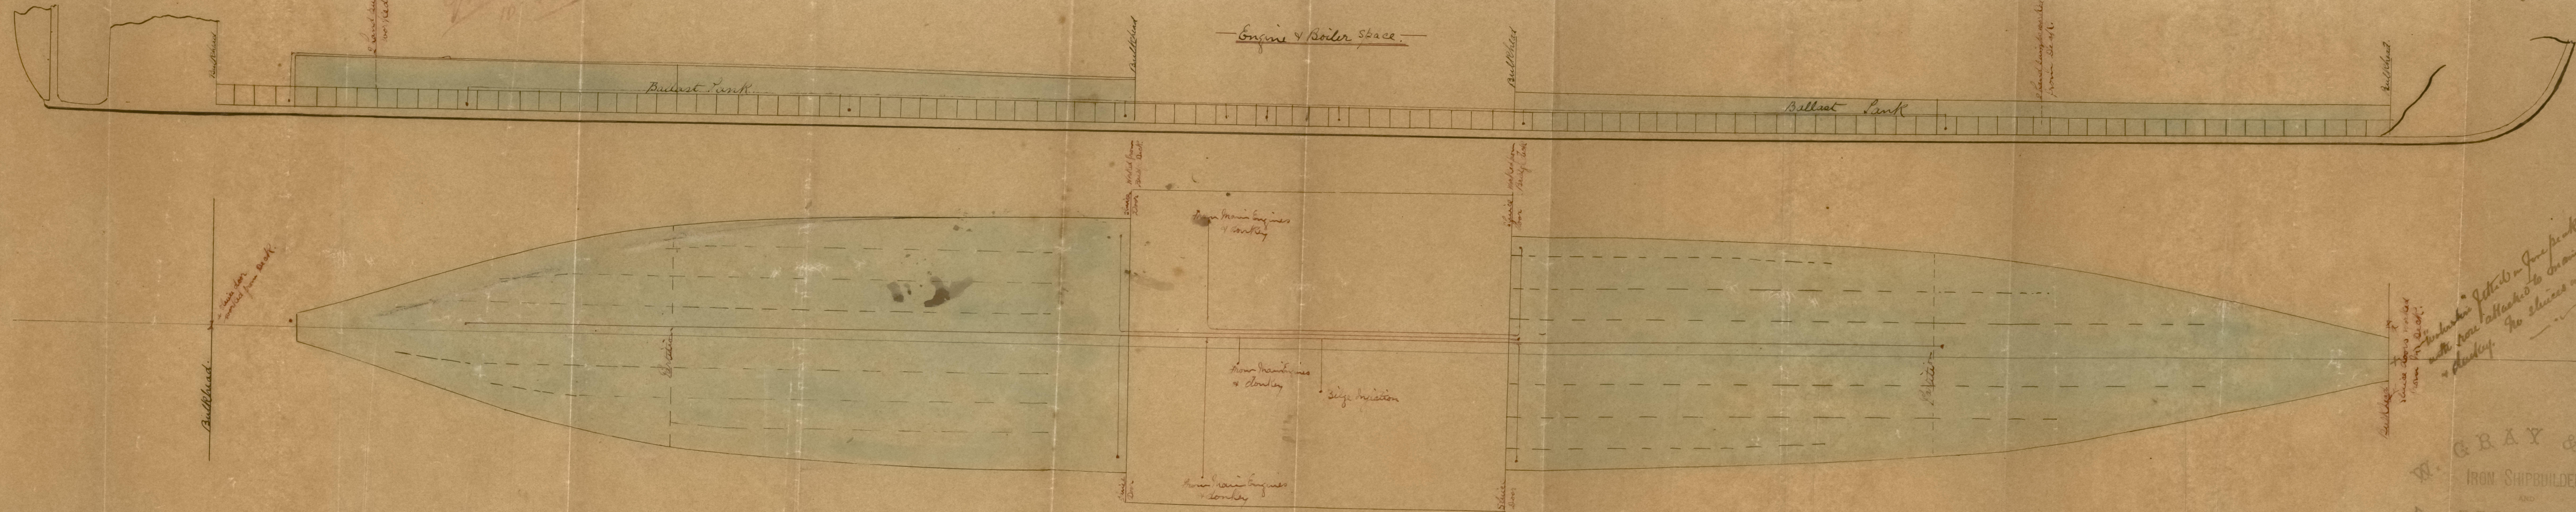

Hand pump on deck

Main Engines & Boilers

Main Engines & Boilers

Stern

Hand pump on deck

Hand pump on deck
no. 1 & 2 on deck

W. GRAY & CO.
IRON SHIPBUILDERS
AND
REPAIRERS,
WEST HARTLEPOOL.

© 2021
Lloyd's Register
Foundation