

S. "Lord Dufferin" Belfast report N^o. 2654.

N^o 129

SAILING SHIP 256.0' x 38.0' x 23.3' hold

TO CLASS 100A1 AT LLOYDS

SCALE $\frac{1}{2}'' = 1 \text{ FOOT}$

NUMERALS


$$19.0 + 25.5 + 39.1 = 83.6 \quad \text{FRAME NUMBER}$$

83.6 x 254.5 = 21276 PLATING "

21276 + 1418 = 22694 EQUIPMENT "

6.69 BREATHS 9.98 DEPTHS "

Diagonal tie plates to be fitted on the beams abreast of the fore & main mast-portainers, where the masts are wedged; and in addition to these four pairs of diagonal tie plates are to be fitted on the upper deck beams, and the breadth of the upper deck stringer plate may be reduced by half the breadth of the tie plates.

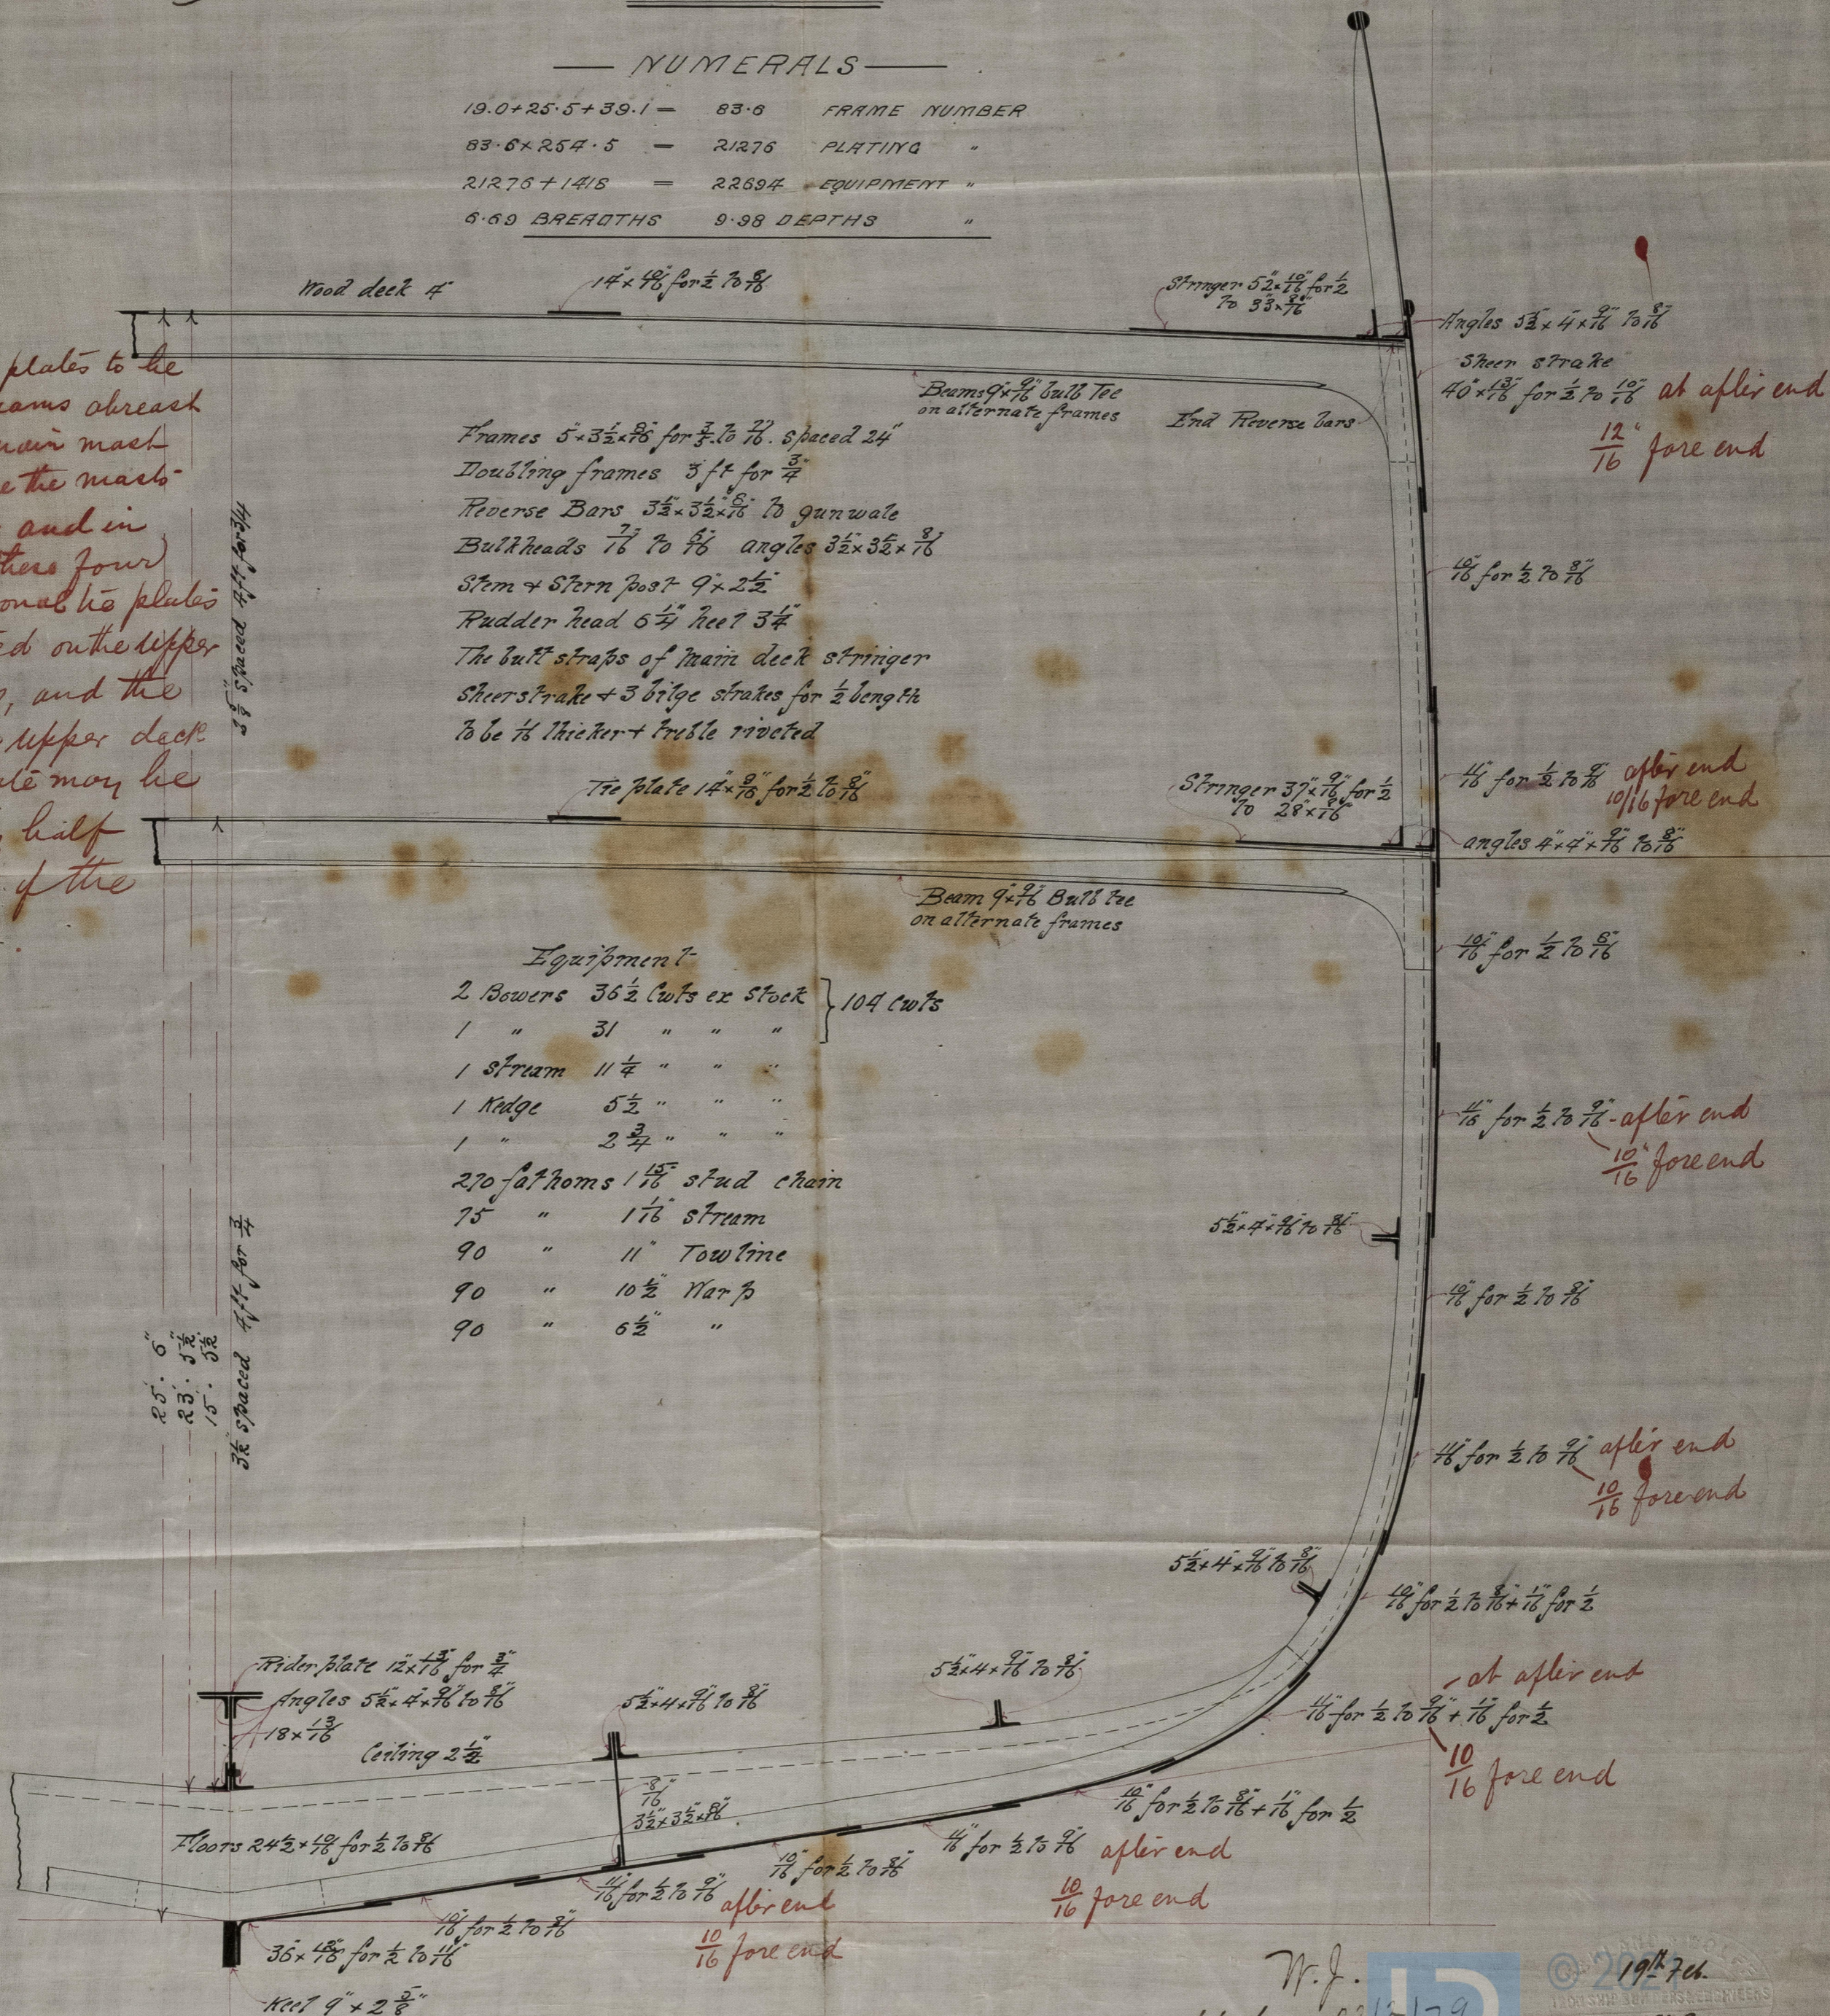

W. J. 2
D. H. K.
19/6/79

2/2/79

© 1977-706.
1879
Lloyd's Register
Foundation

IRONS38-0116