

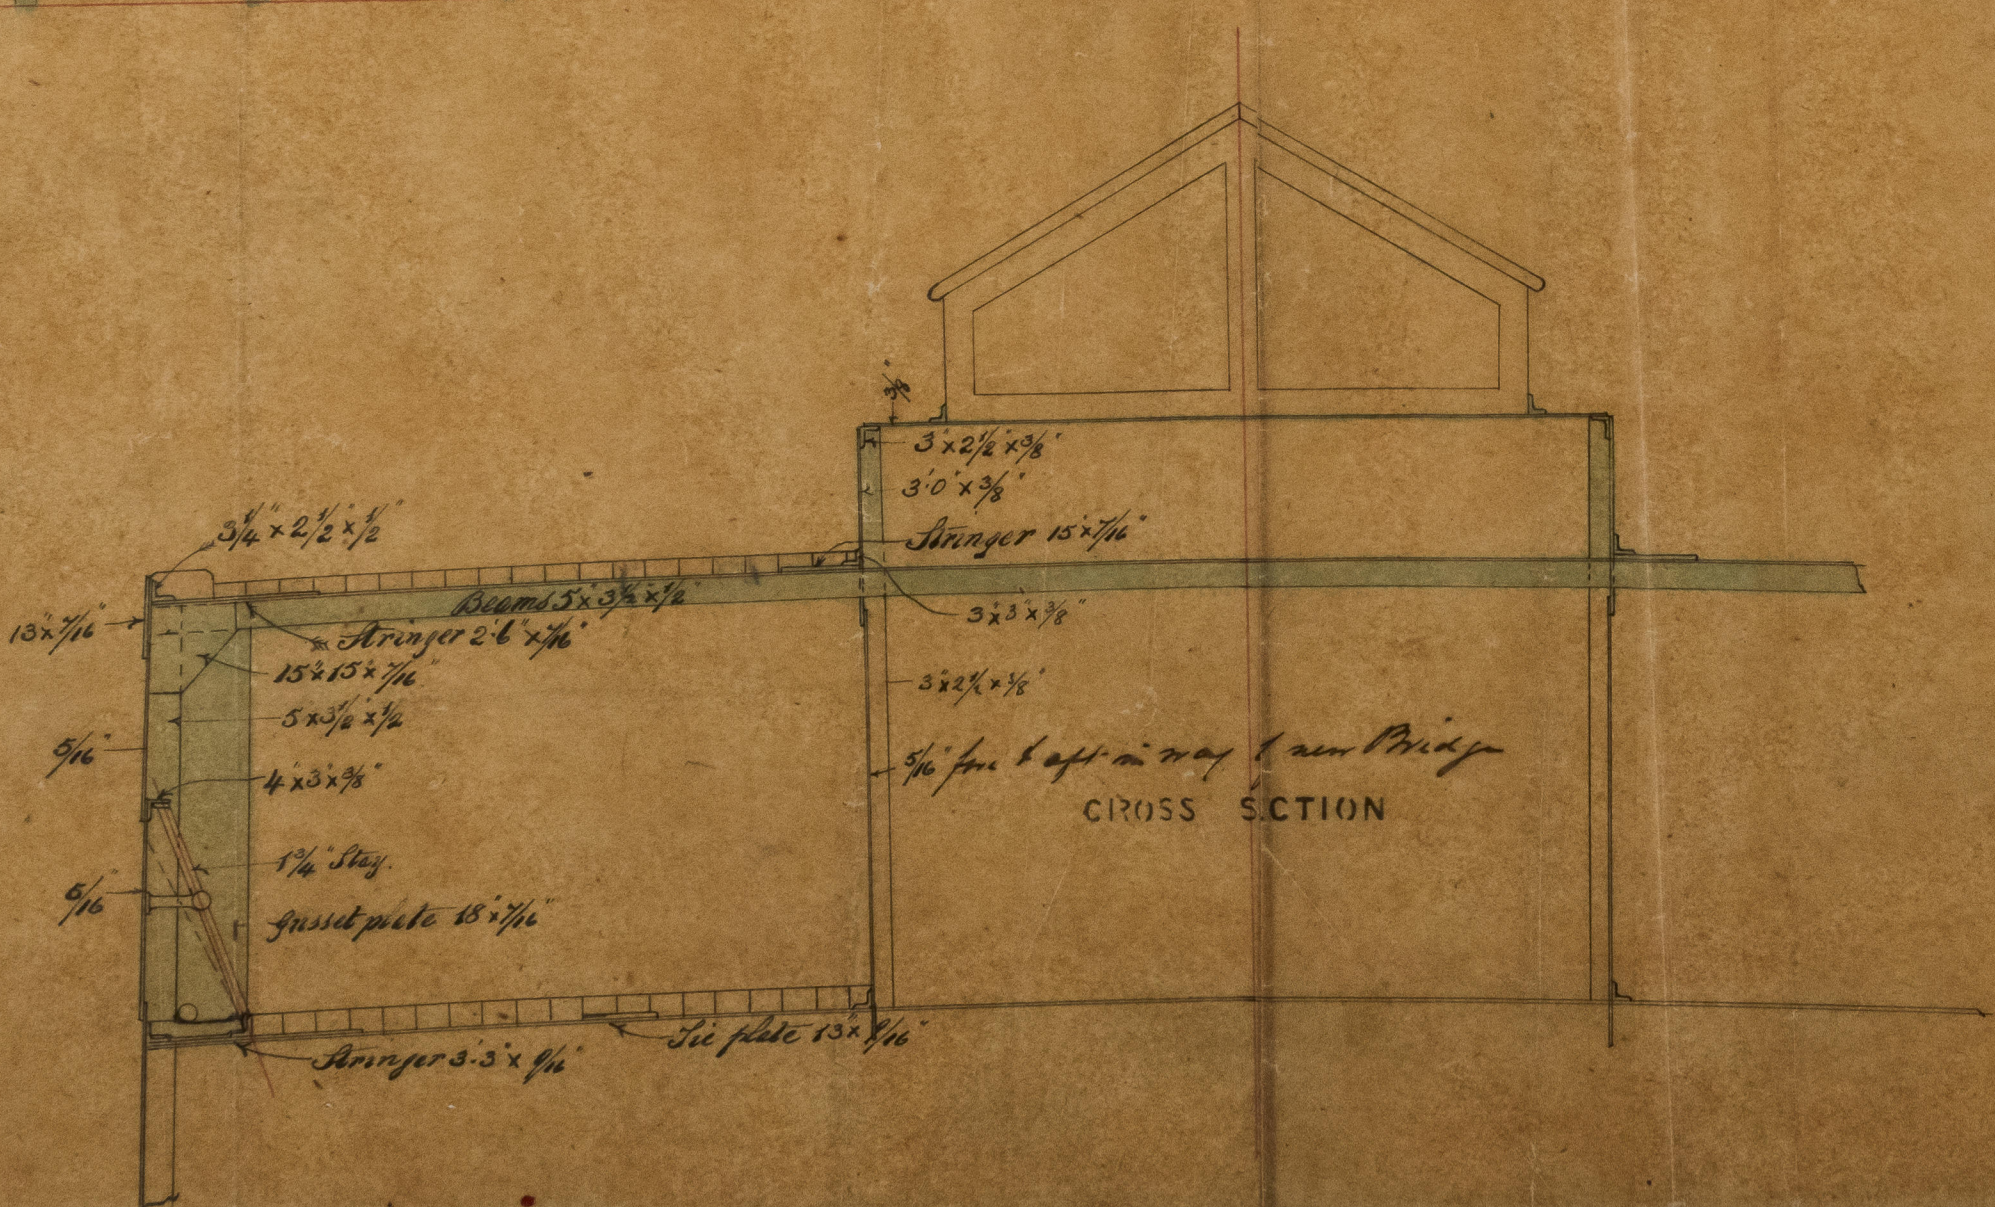


2100

Old bridge.

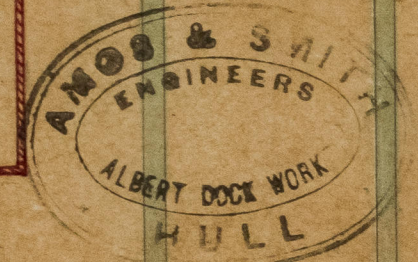

Note. All the new work is tinted.

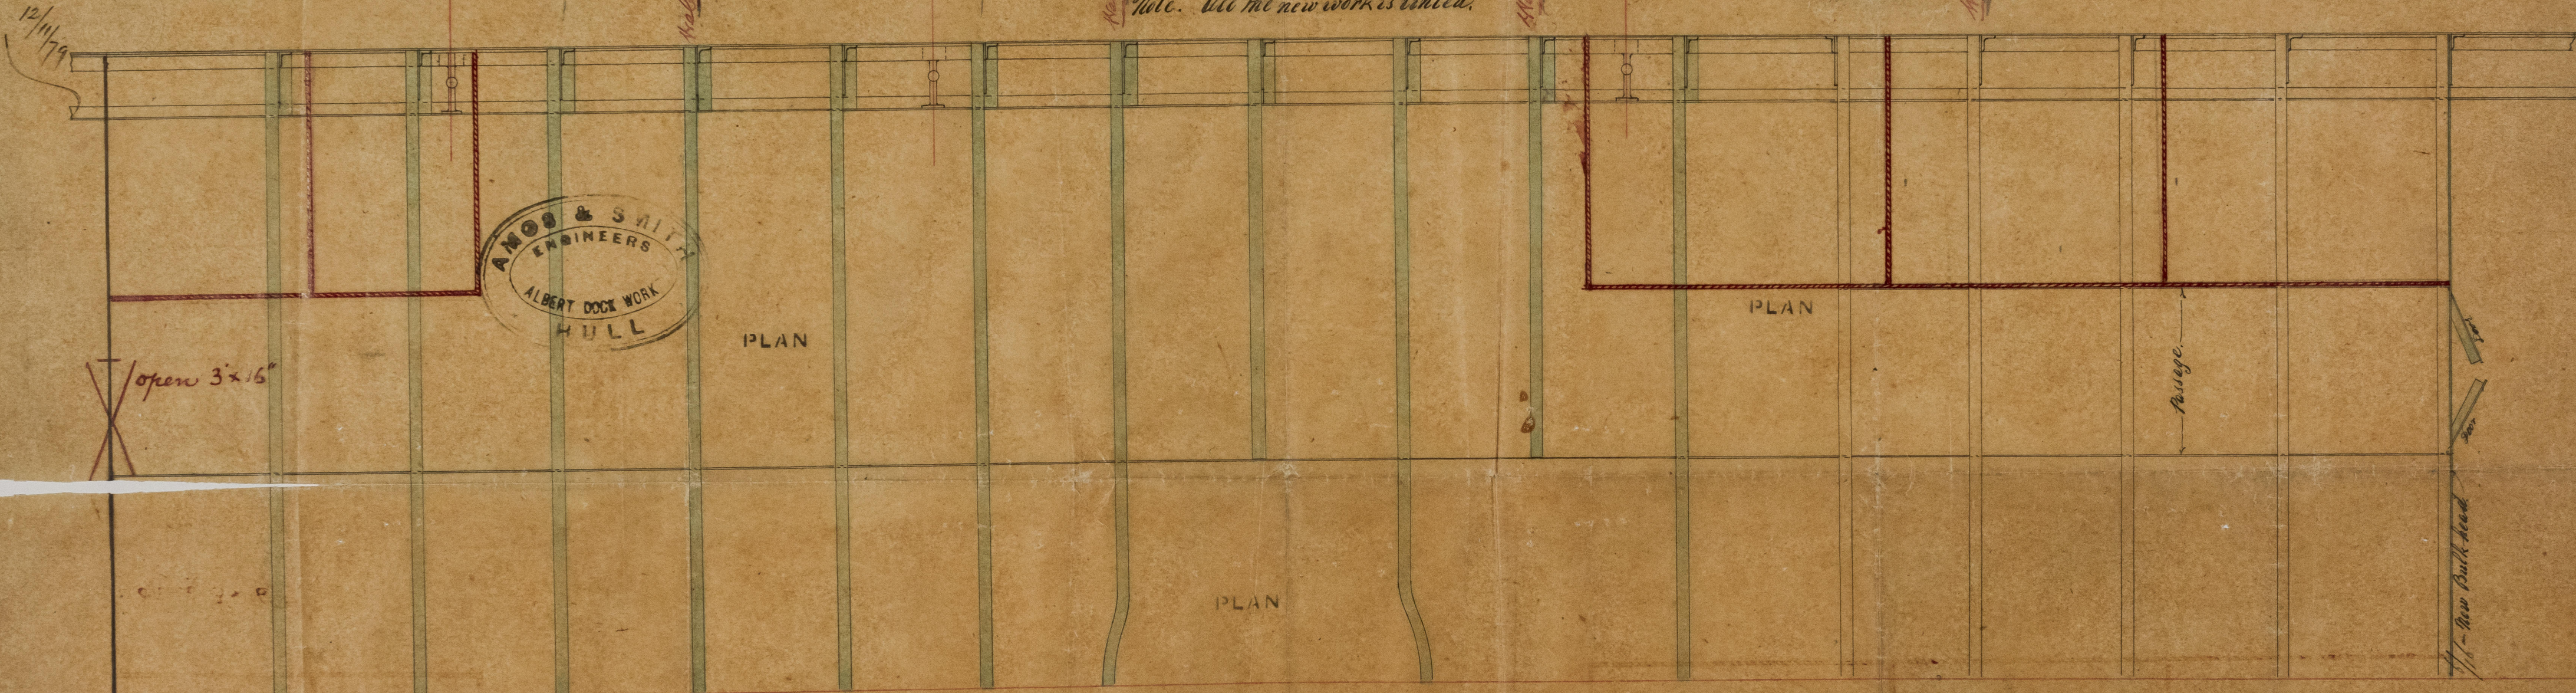

New Deck for S.S. "Bassano."

3/8" Scale.

