
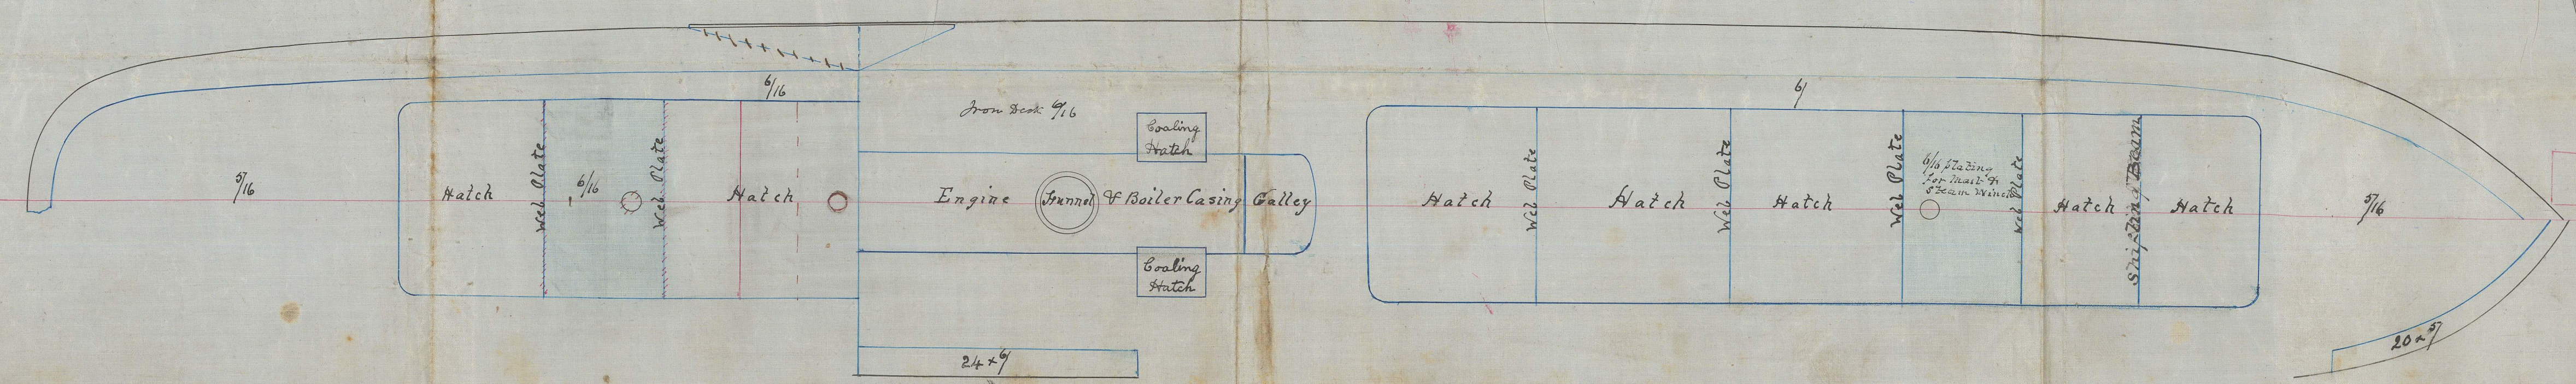



10/7/78

PROFILE AND PLAN No 36
 Scale 1/2" = ONE FOOT.
 CLASS 90 A1

Rev 8/7/78

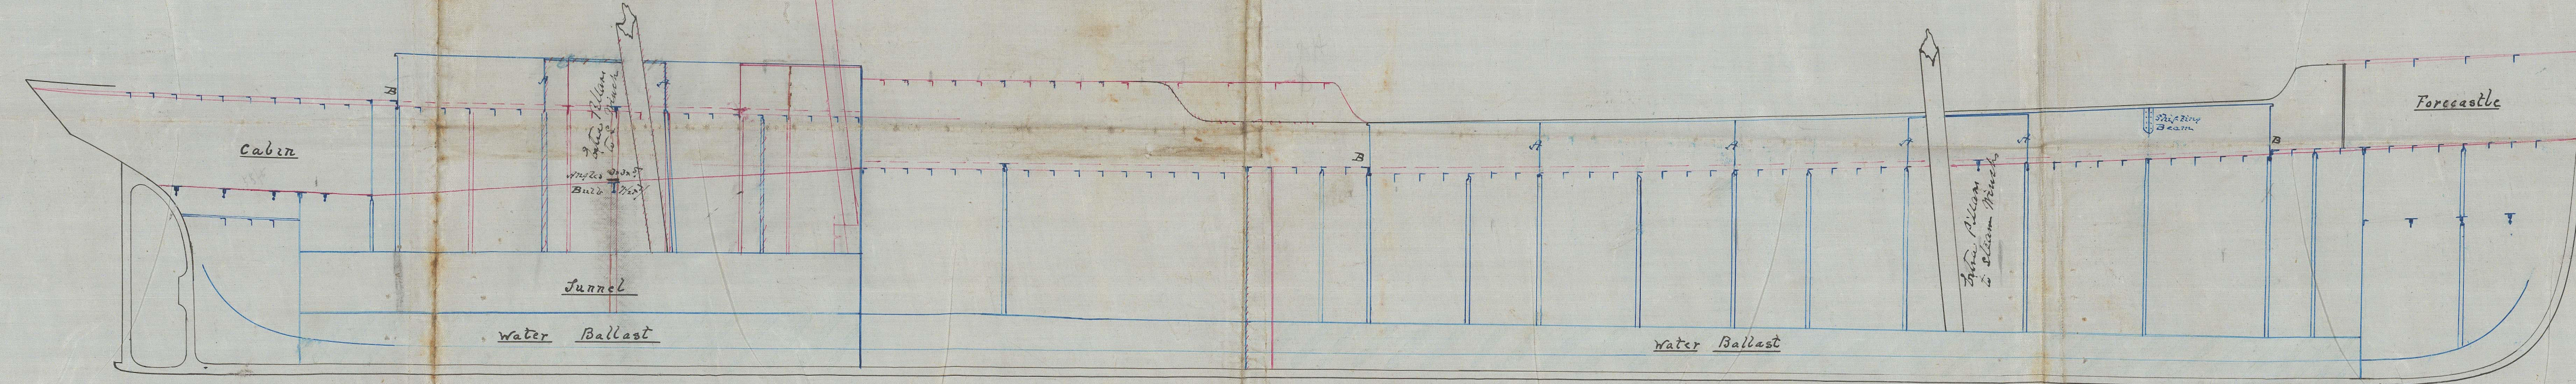

Section of SS No 36
 Scale 1/2" = ONE FOOT.
 185' x 28' x 14'

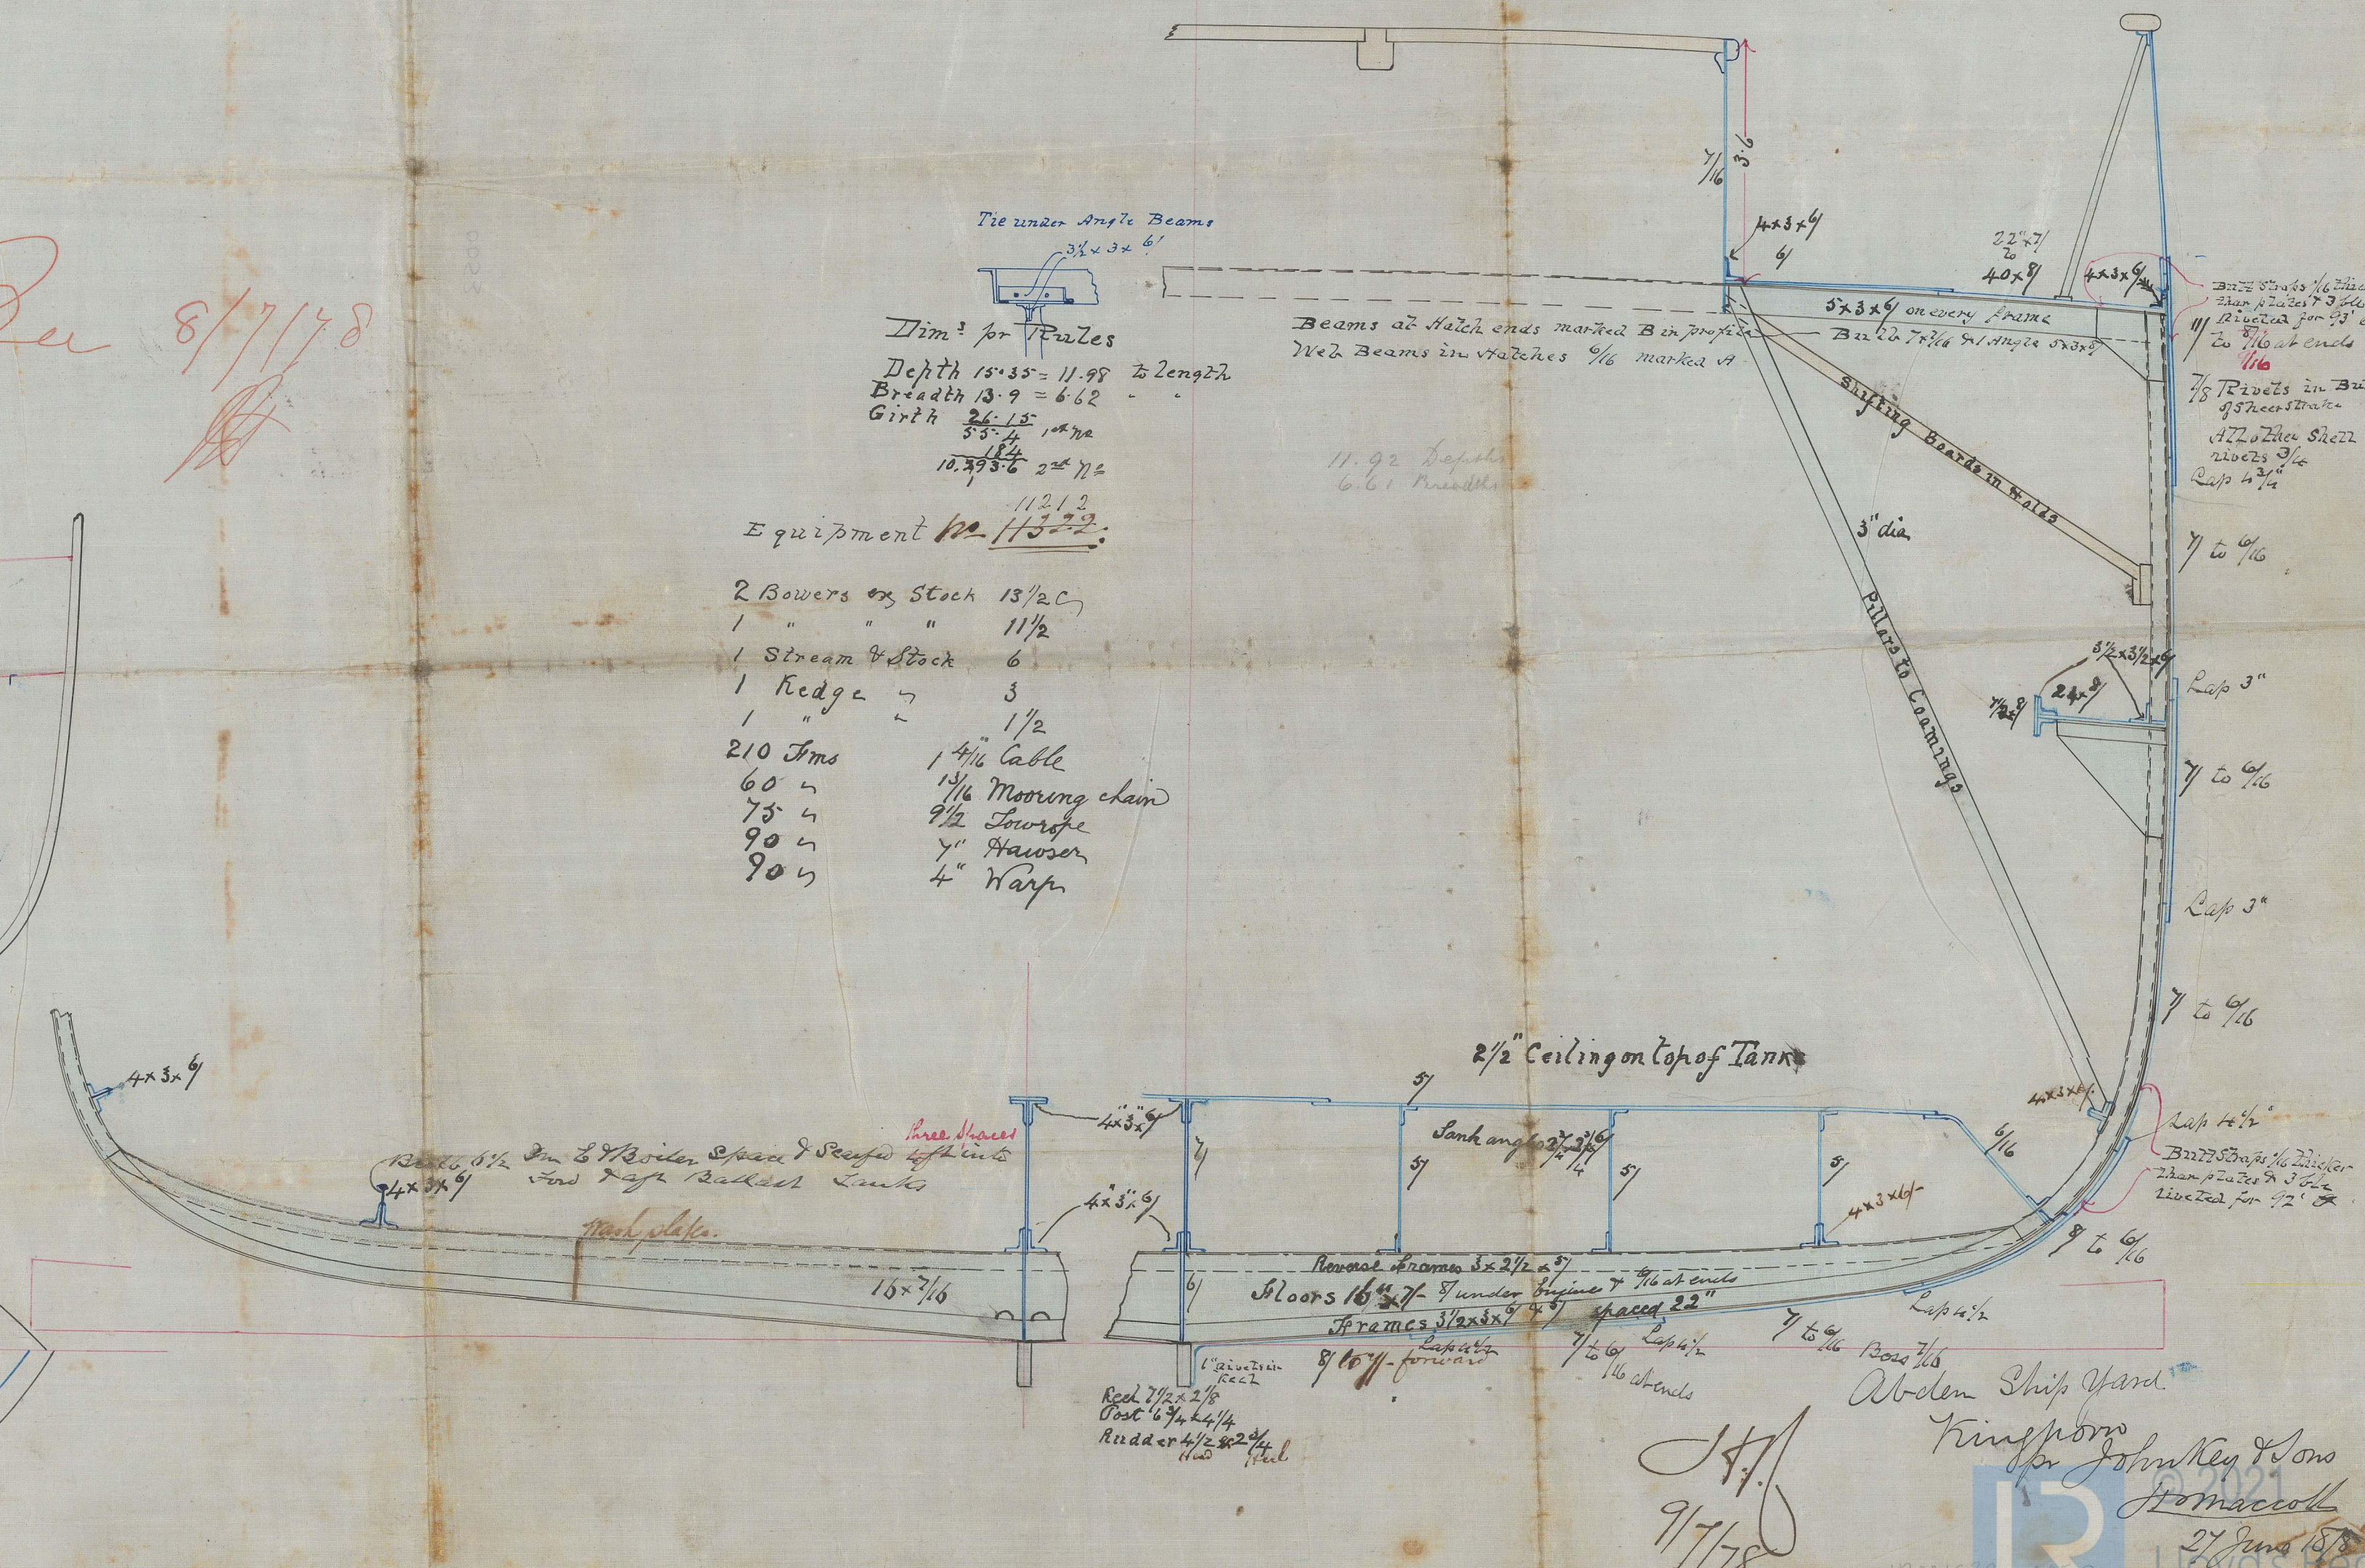

 Depth 15.35 = 11.98 to length
 Breadth 13.9 = 6.62
 Girth 26.15 = 10.74
 10.3956 2nd 11.2

Equipment per 11.2
 1 " " 11/2
 1 Stream & Stock 6
 1 Hedge 3
 1 " 1/2
 210 fms 1 1/4 cable

14/7/78
 9/7/78
 King for John Key & Son
 Homacoch
