


Scale $\frac{1}{2}$ " inch = 1 Foot

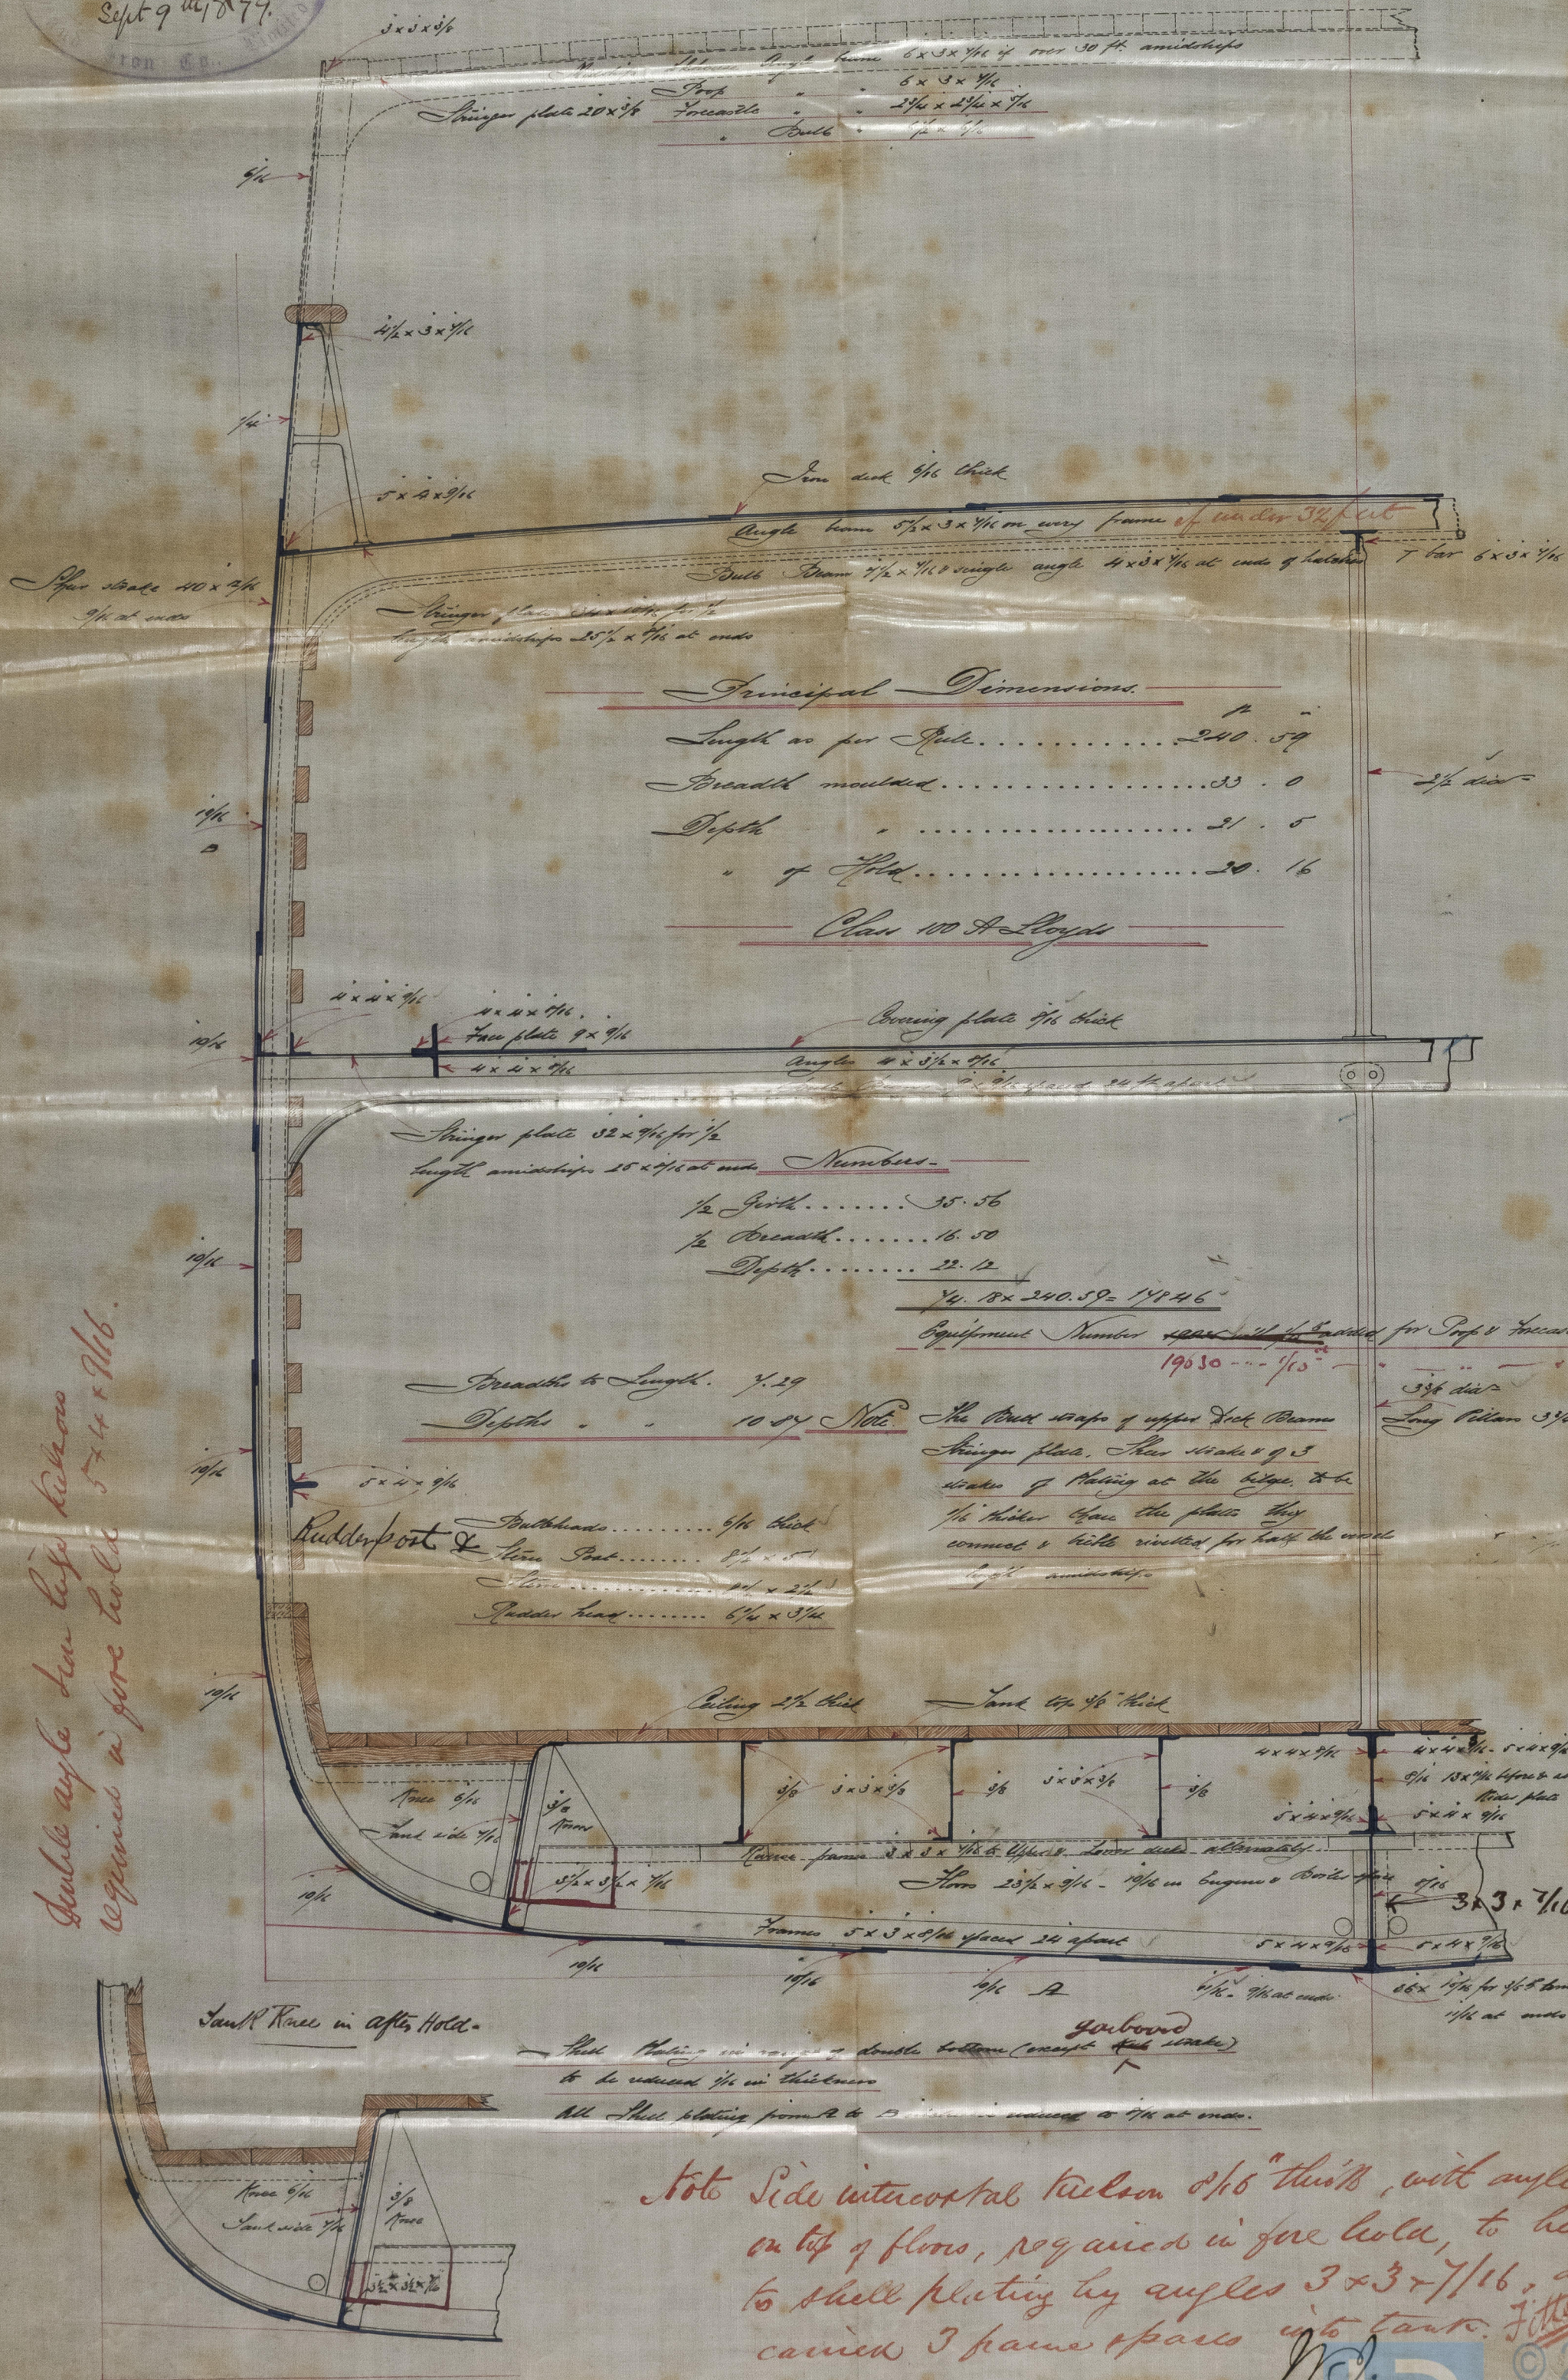

Double angle from large kitchen
required a good hold 5' x 4' x 11/16.

Note Side intracostal trilem $2\frac{1}{2}$ "thick, with angles $5 \times 4 \times 9\frac{1}{8}$
on top of flms, regained in fore hold, to be attached
to shell plating by angles $3 \times 3 \times 7\frac{1}{16}$, and
carried 3 frame spars into tank. Fitted R.J.R.

11/9/1

© 2021

1079174