

No 203. - "Maugerston". - Report no 14519.
 No 204. - "J. Lubaton". - Report no 14621.

No 203 & 4.


MIDSHIP SECTION

for an Iron Screw Steamer

100A Three Decks at Lloyds

Principal Dimensions feet
 Length between perps 285.00
 Beam moulded 35.00
 Depth of hold 24.50
 Scale 1/2" = 1.0 foot

Rec 2/12/78

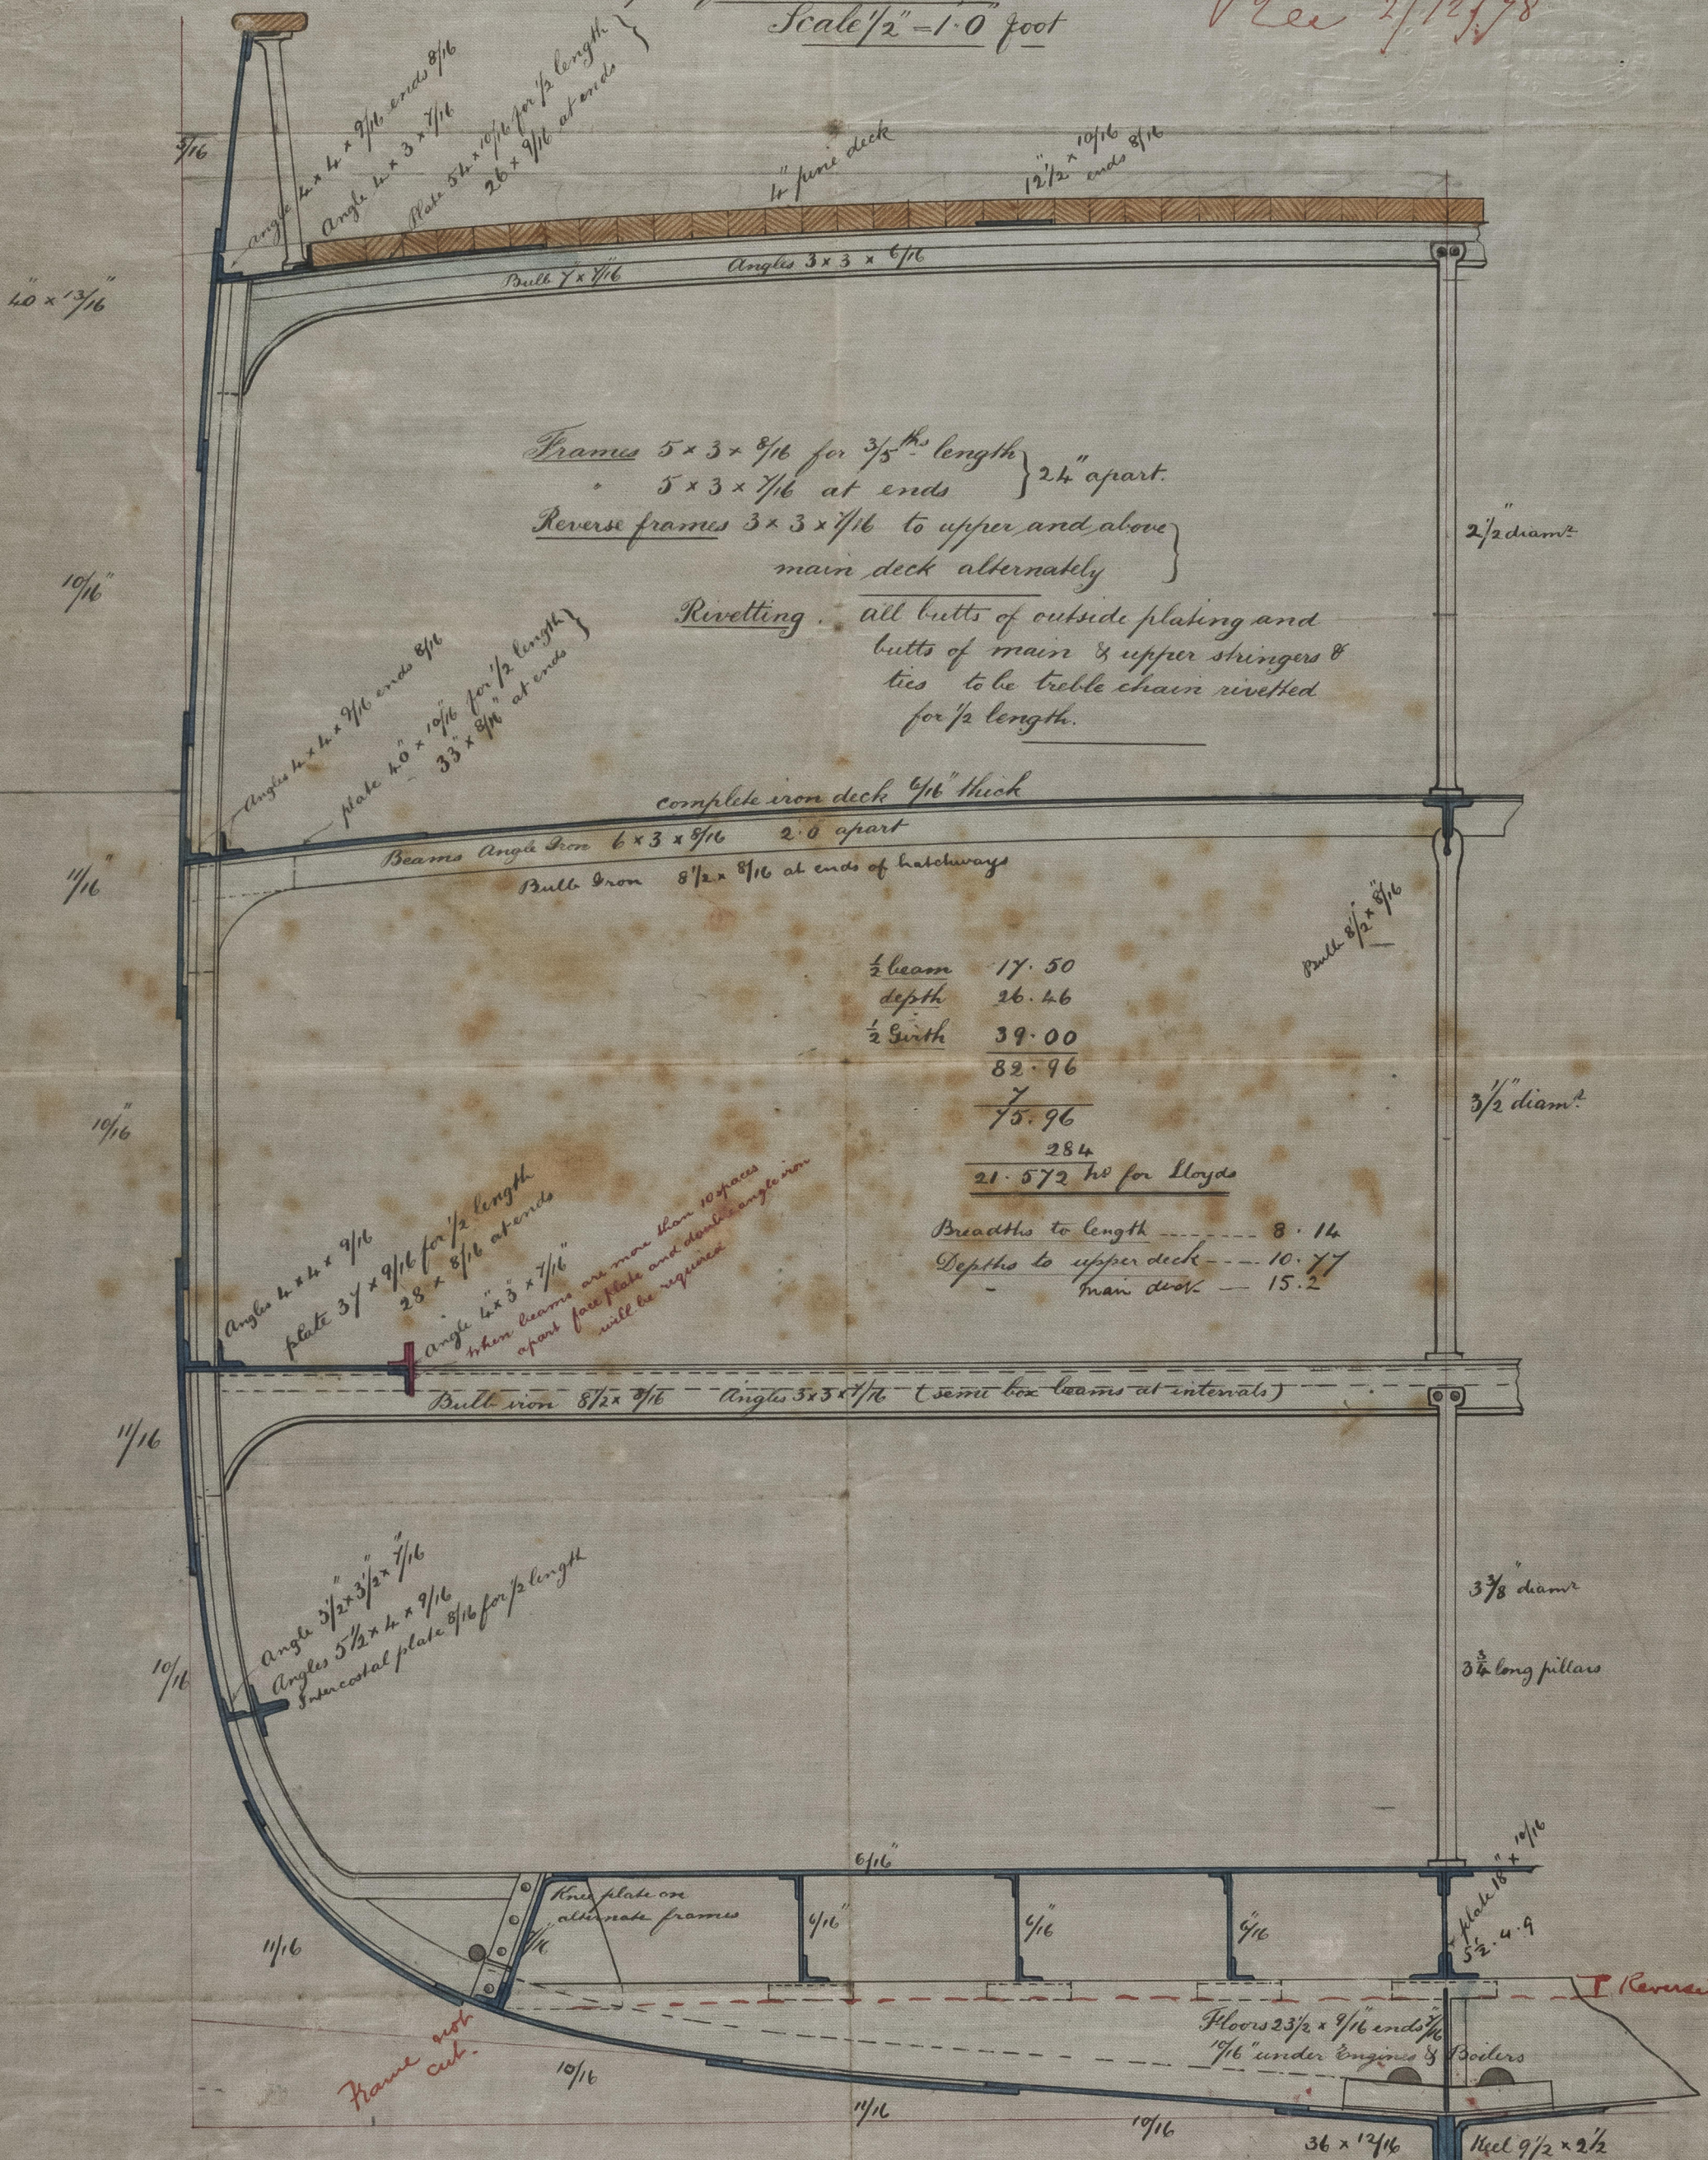

1/2 beam	17.50
depth	26.46
1/2 breadth	39.00
	82.96
	75.96
	284

21.572 for Lloyds

Breadths to length 8.14
 Depths to upper deck 10.77
 main deck 15.2

2 1/2 diam

3 1/2 diam

3 3/8 diam

3 1/2 long pillars

(Revised frame)

18M

2/12/78

© 2021

Lloyd's Register Foundation

TRANS 40-0109