


No 203: "Mangerton" - Report No 14519.  
 No 204: "Tantallon" - Report No 14621.

LONGITUDINAL SECTION FOR IRON SCREW STEAMERS Nos 203 AND 204

To Class 100A Three Decks at Lloyd's

Scale  $\frac{1}{8}$ " = 1.0' Foot.

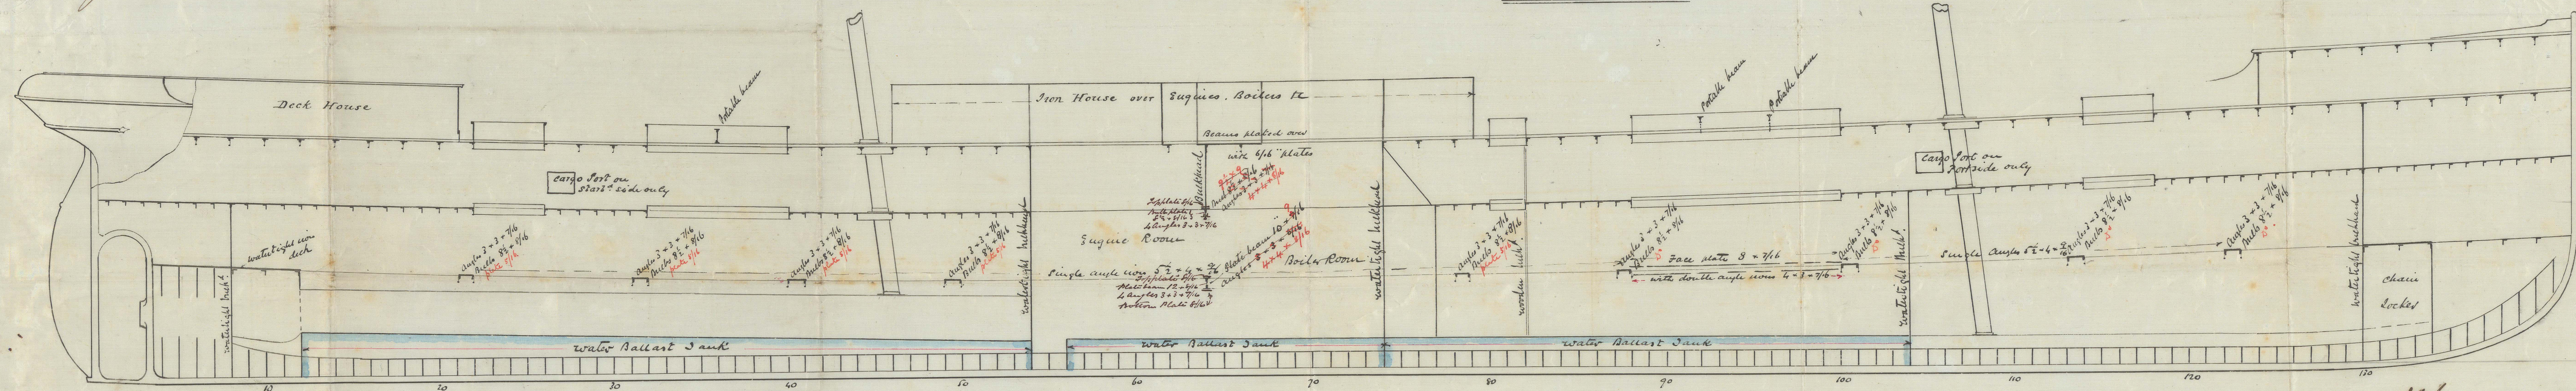

14/1  
 2/5/79