


No 203 - "Maugenton" - Report No 14519.  
 No 204 - "Jambellon" - Report No 14621.

Letter to N Shlds 6/5/79

# No 203 & 4 PLAN OF SUCTION PIPES.

Scale 1/8" = 1.0 Foot.

MD 5.5.79

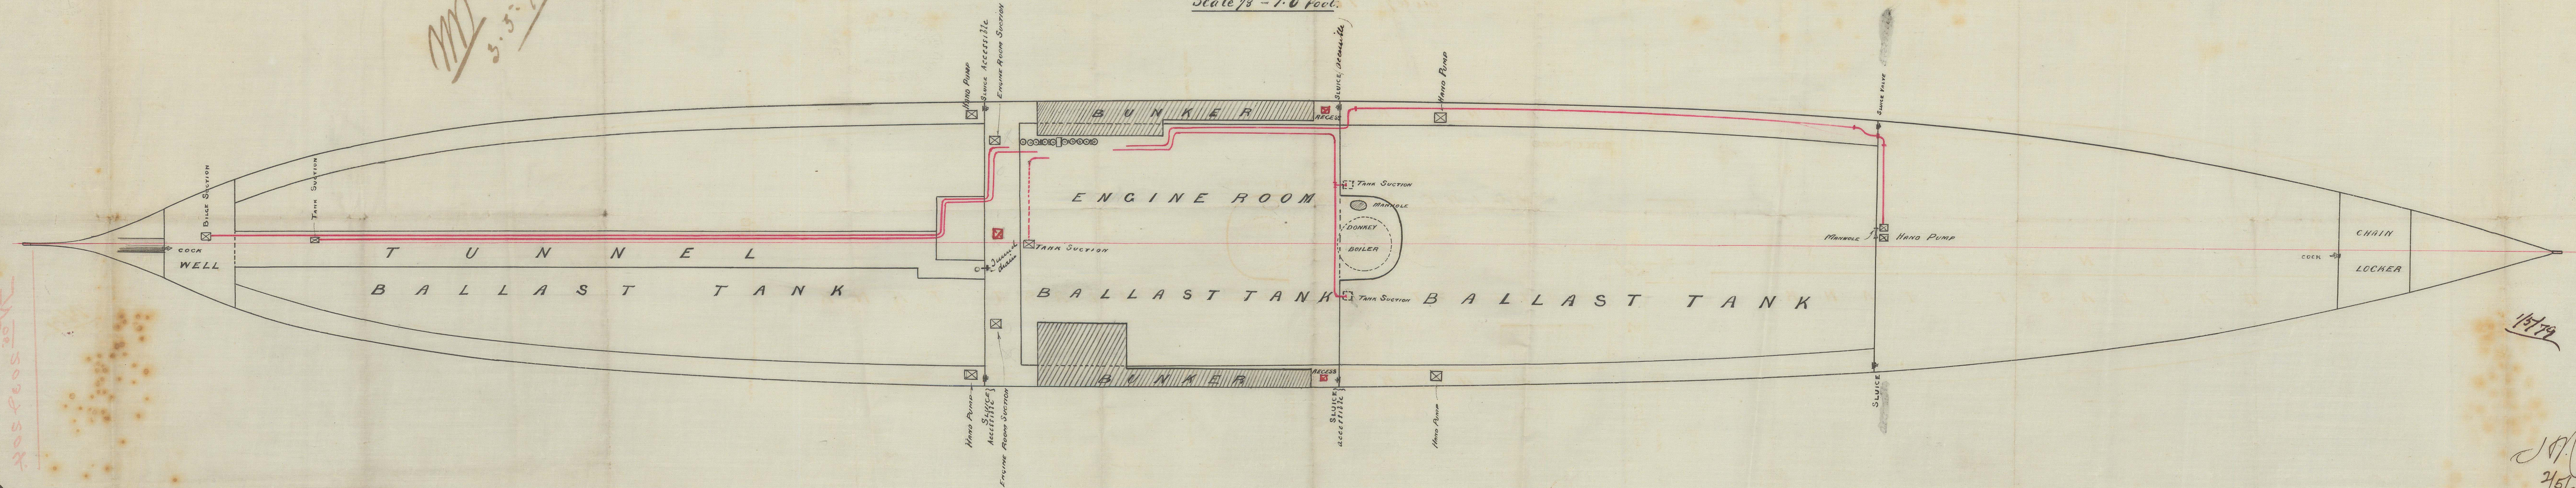

No 203 & 4

180540-011

180540-011

1/5/79


J.M.  
2/5/79



Leslie 20384

Trans. A. Leslie & Co

20384-20384

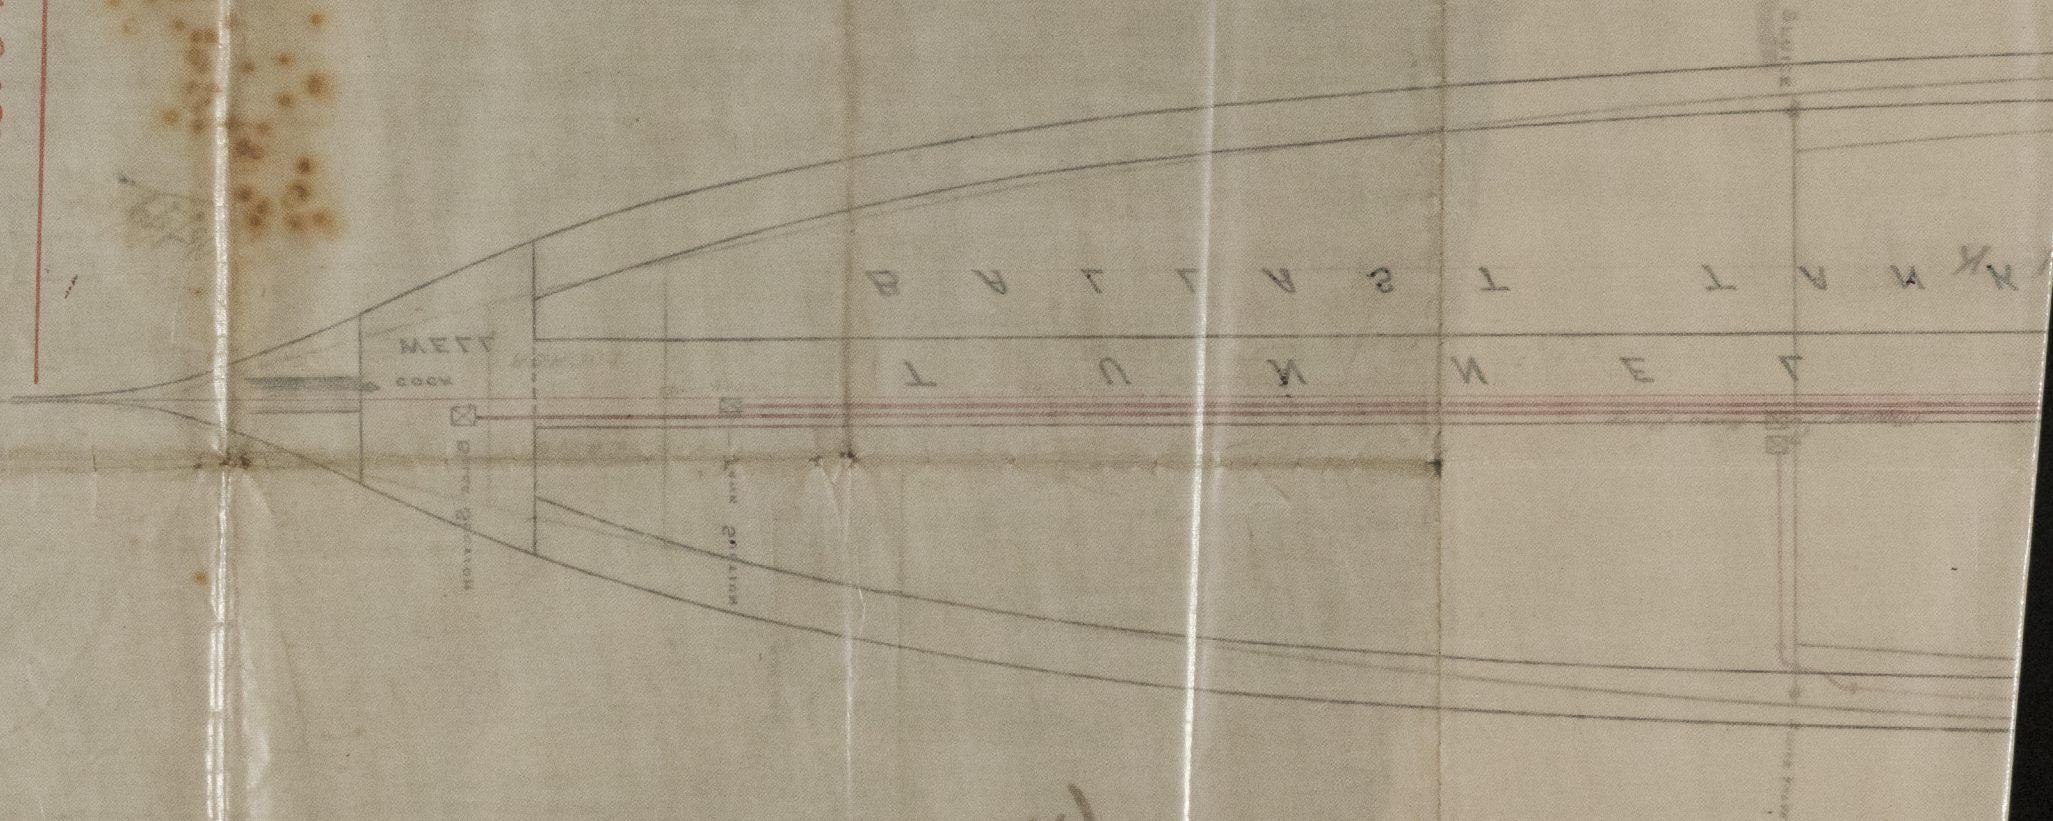

W. A. Leslie

PT 2/10 1882 W. A. Leslie



© 2021

Lloyd's Register  
Foundation