


Table Boat

Aug 15  
1879.

Iron  $\frac{3}{4}$ . Grappler Sunderland report N<sup>o</sup> 12343.

SCALE.— $\frac{1}{8}$  INCH TO ONE FOOT.

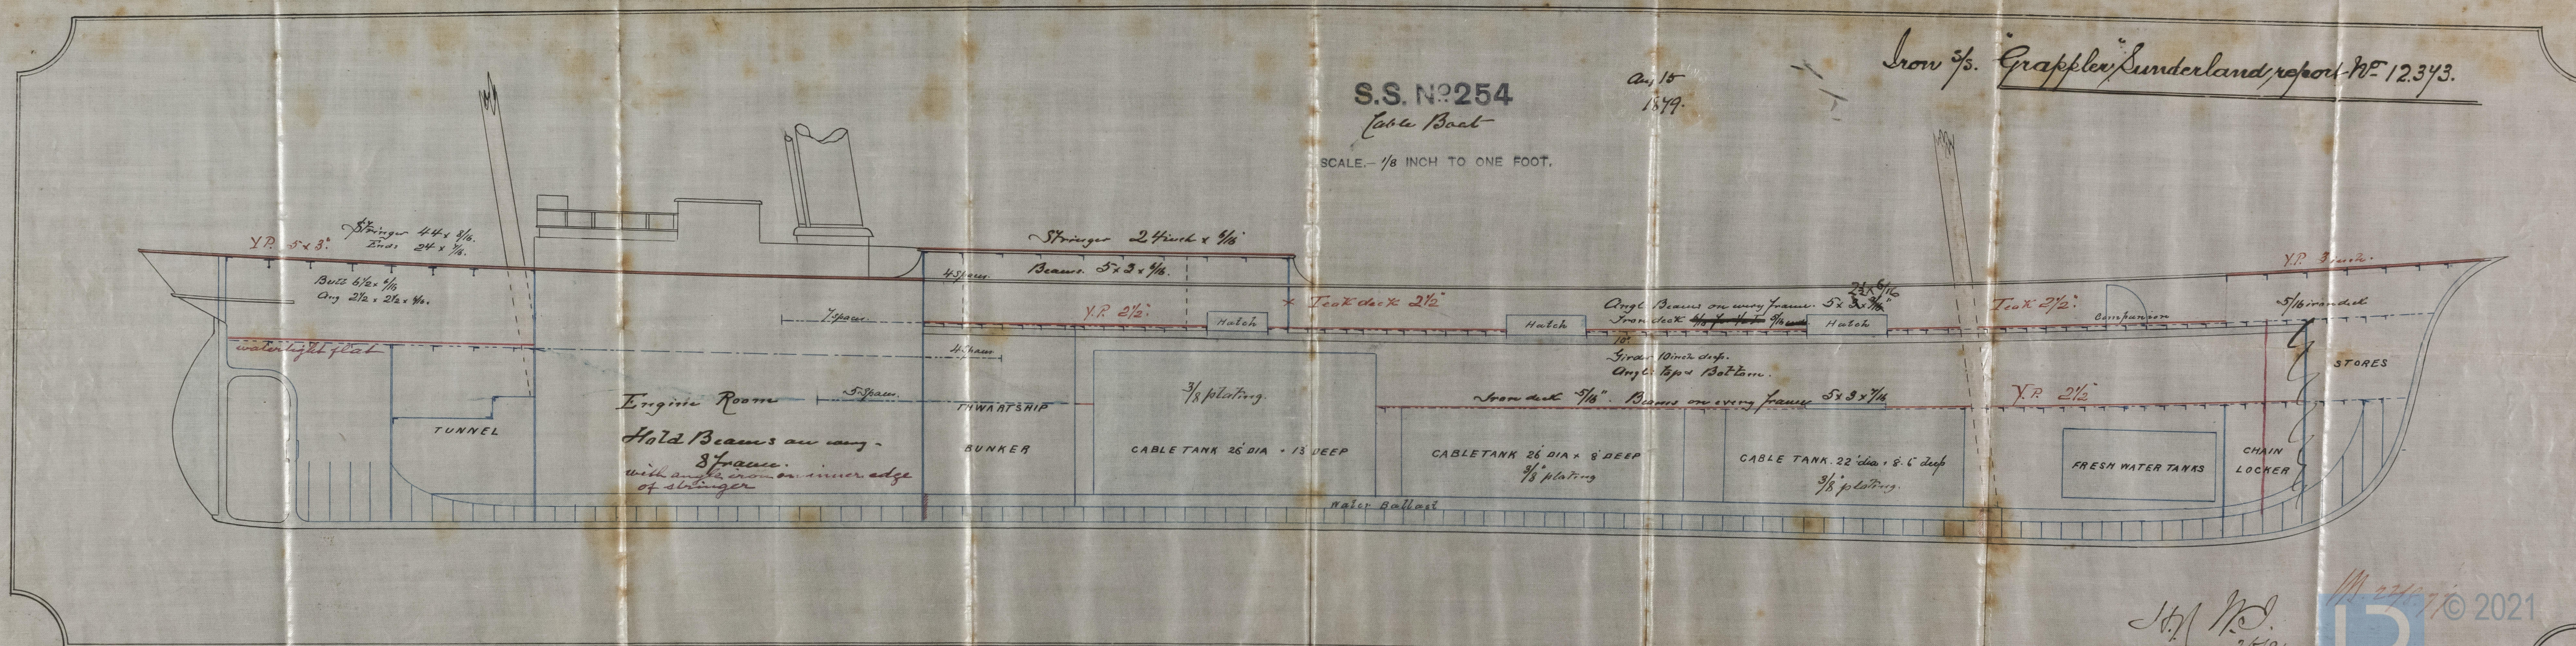

16.11.79  
28/10/79

140

MS. 2748.77

© 2021

LR

Lloyd's Register  
Foundation

0510-04152071