



Letter to Sunderland  
11 Novr: 1879

S.P. No 2514.

Iron s/s. Grappler Sunderland report No 12.373.

Pumping Arrangements  
M 10.11.79  
Scale 1 inch = 1 foot.

Oct 24<sup>th</sup>  
- 1879 -

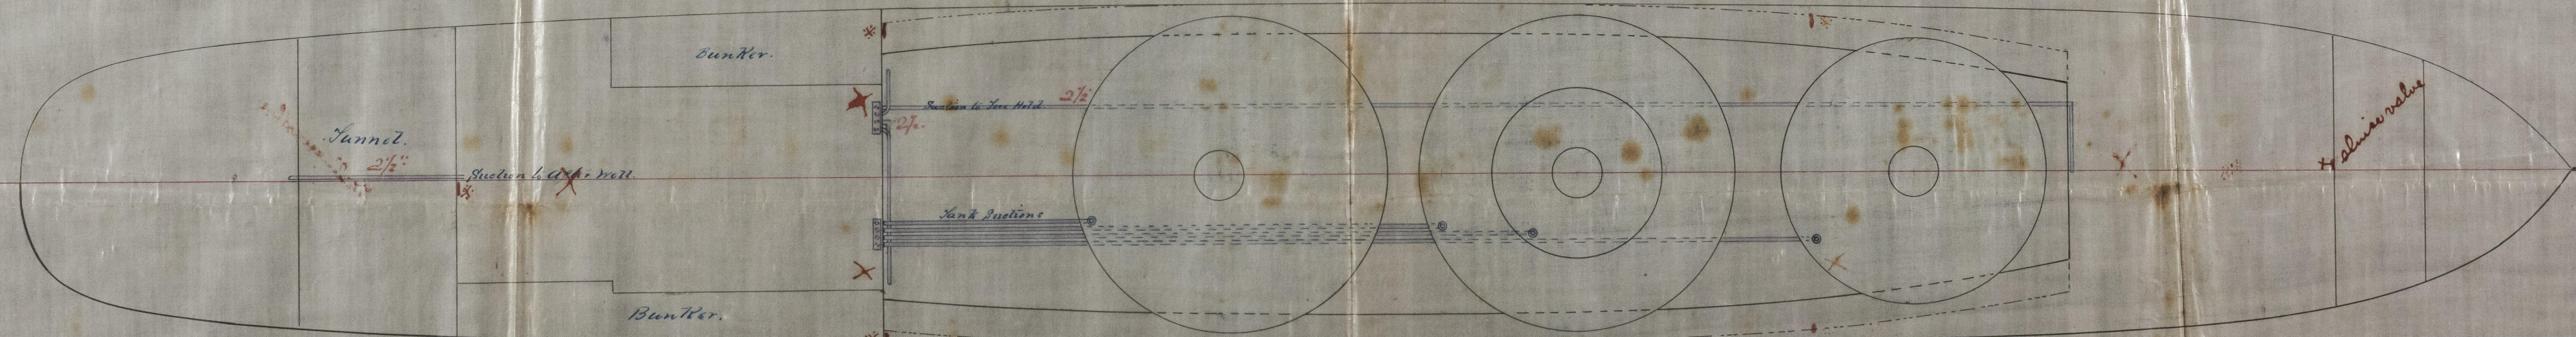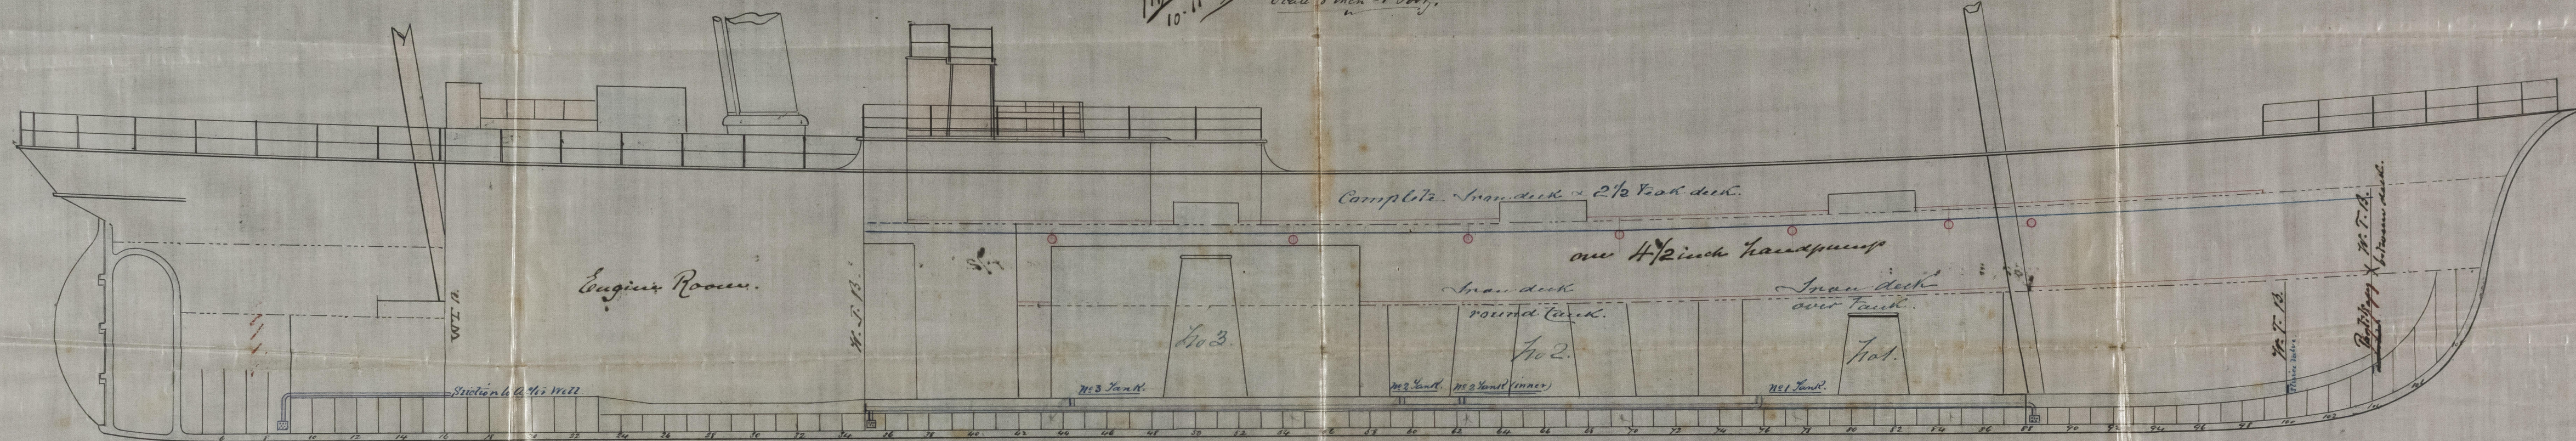

\* Slice Valves