

Iron s/s. Grappler Sunderland report N^o 12343

Aug 15.
1879.

Screw Steamer N^o 254

Midship Section

199-0" x 29-0" x 16-4 hold

Class no-A Lloyds


1/2 Girls	28.67	
1/2 Breadth	14.50	
Depth	17.78	
Building	60.95	× 199.00
Nos	12/20	

12250

Proportions

11. ~~2~~ ² Depths in Length

6.8 Breadths in Length

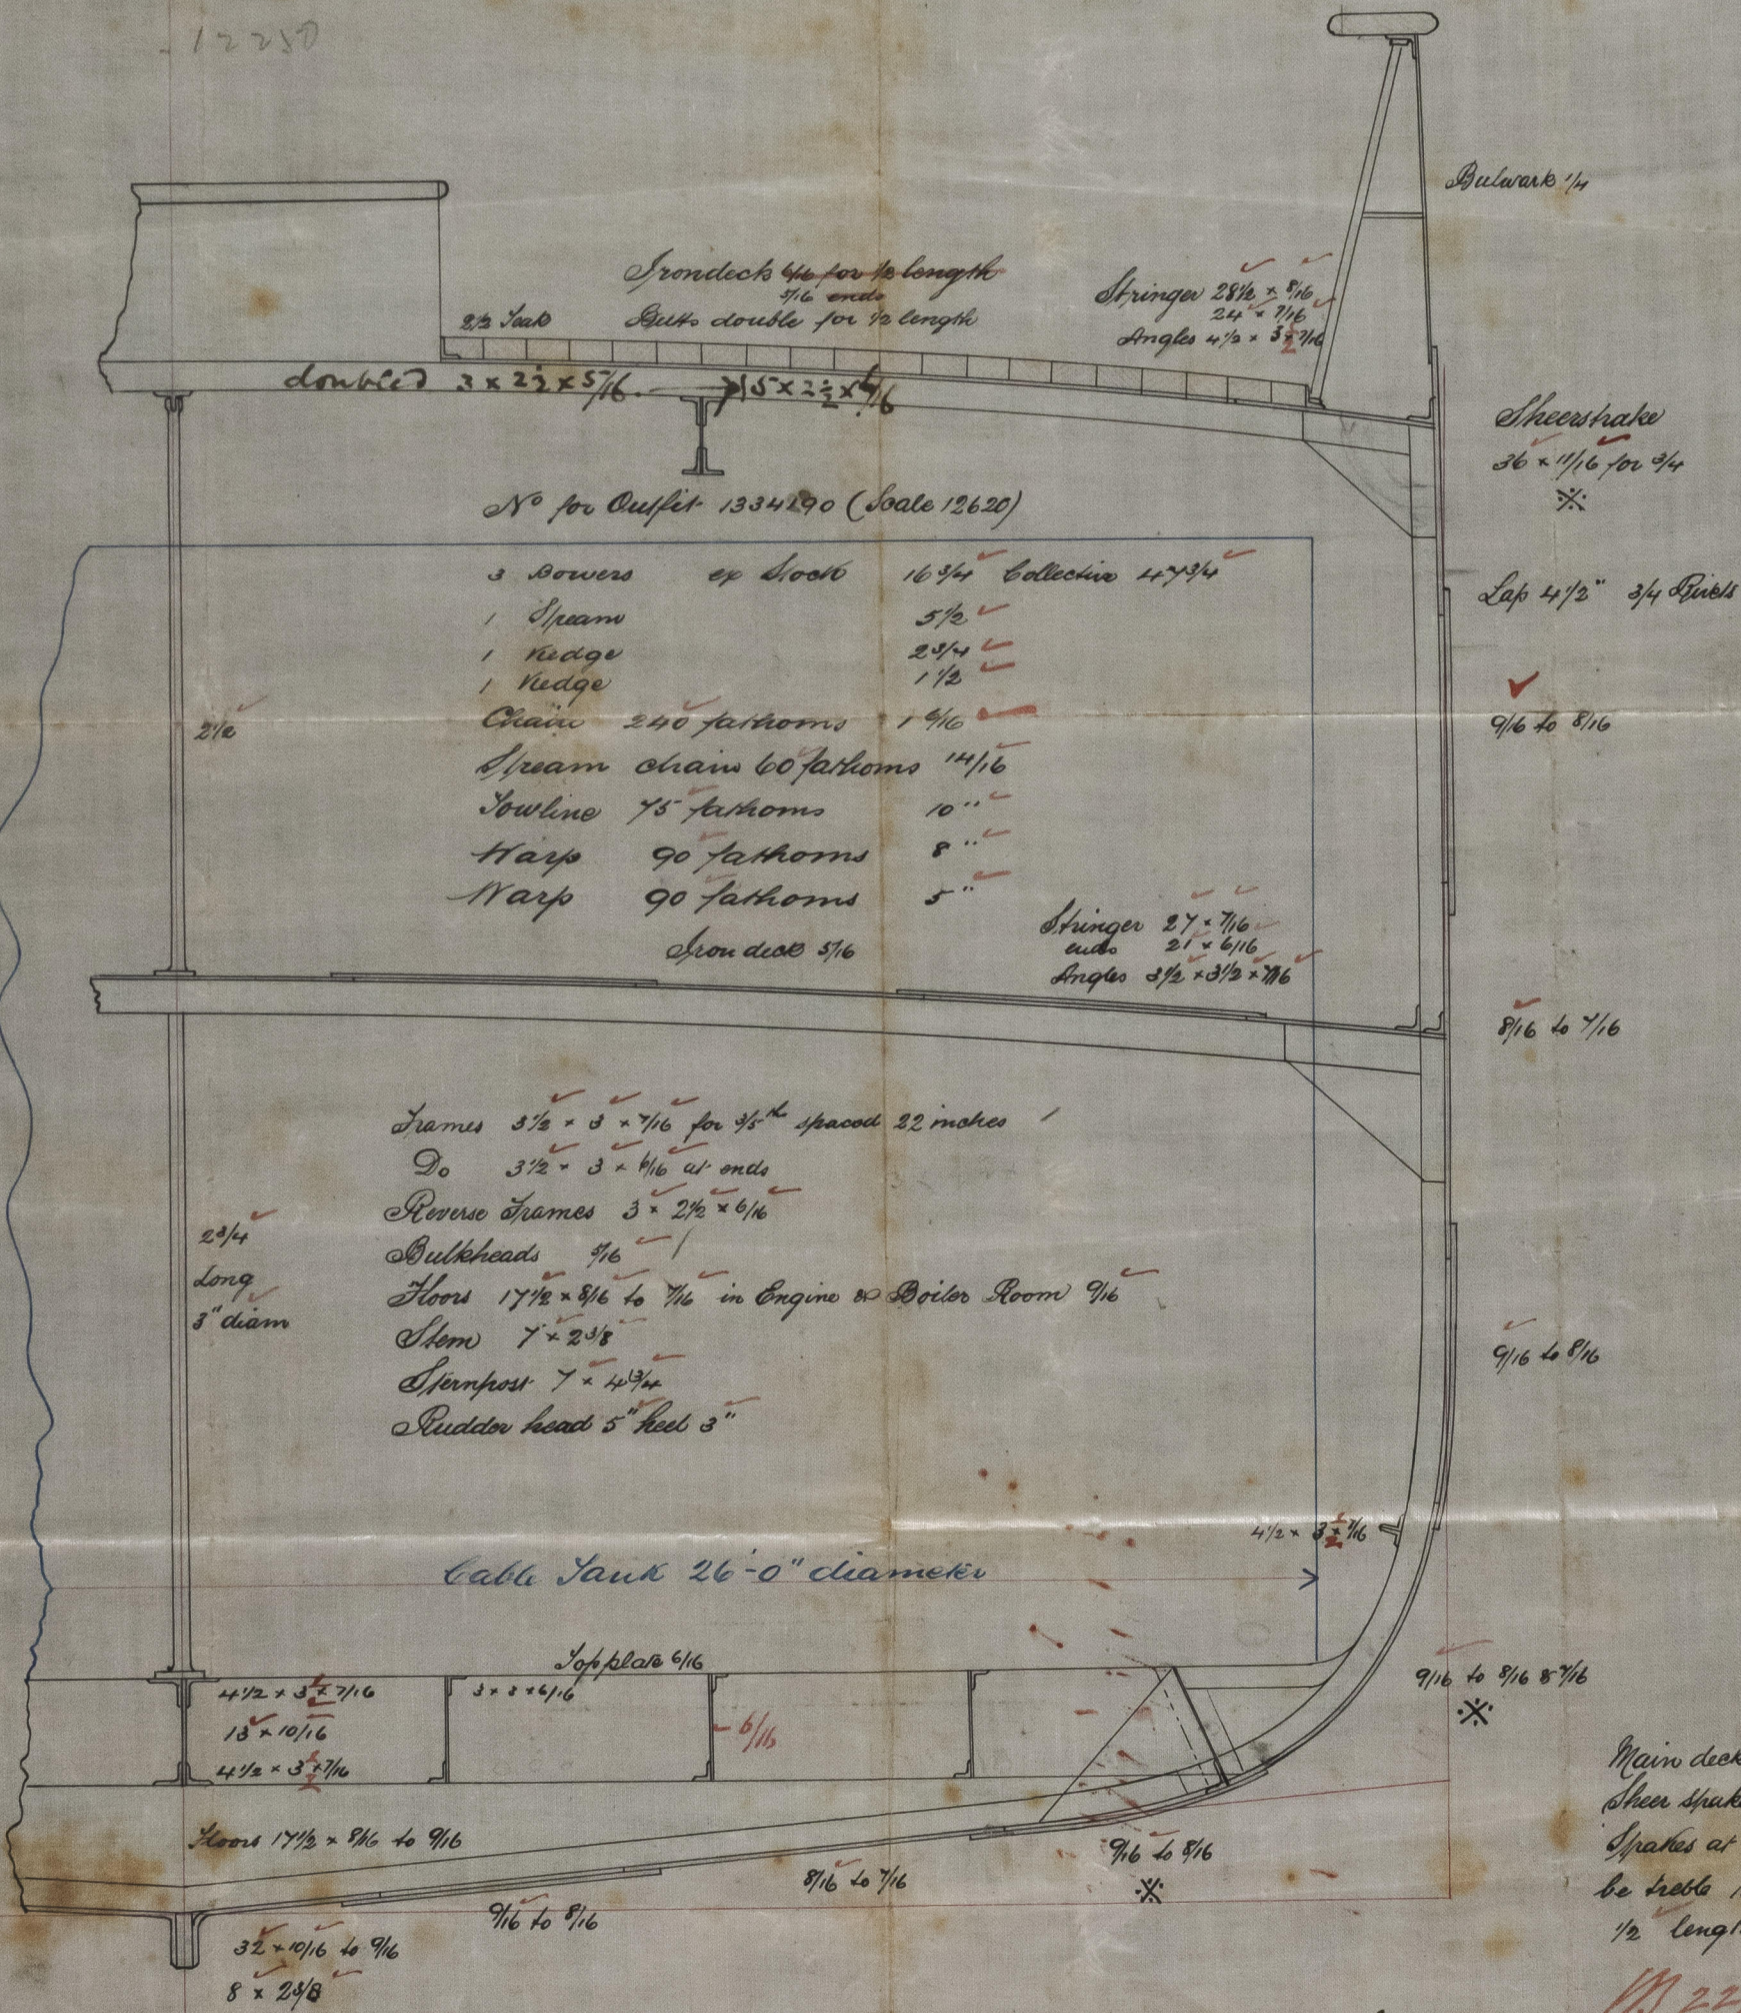

Main deck Stringer
Sheer stake and 2
Spikes at bilge to
be treble rivetted for
 $\frac{1}{2}$ length

H.D.
26/8/79

187. 28/8/79

120N540-0152