
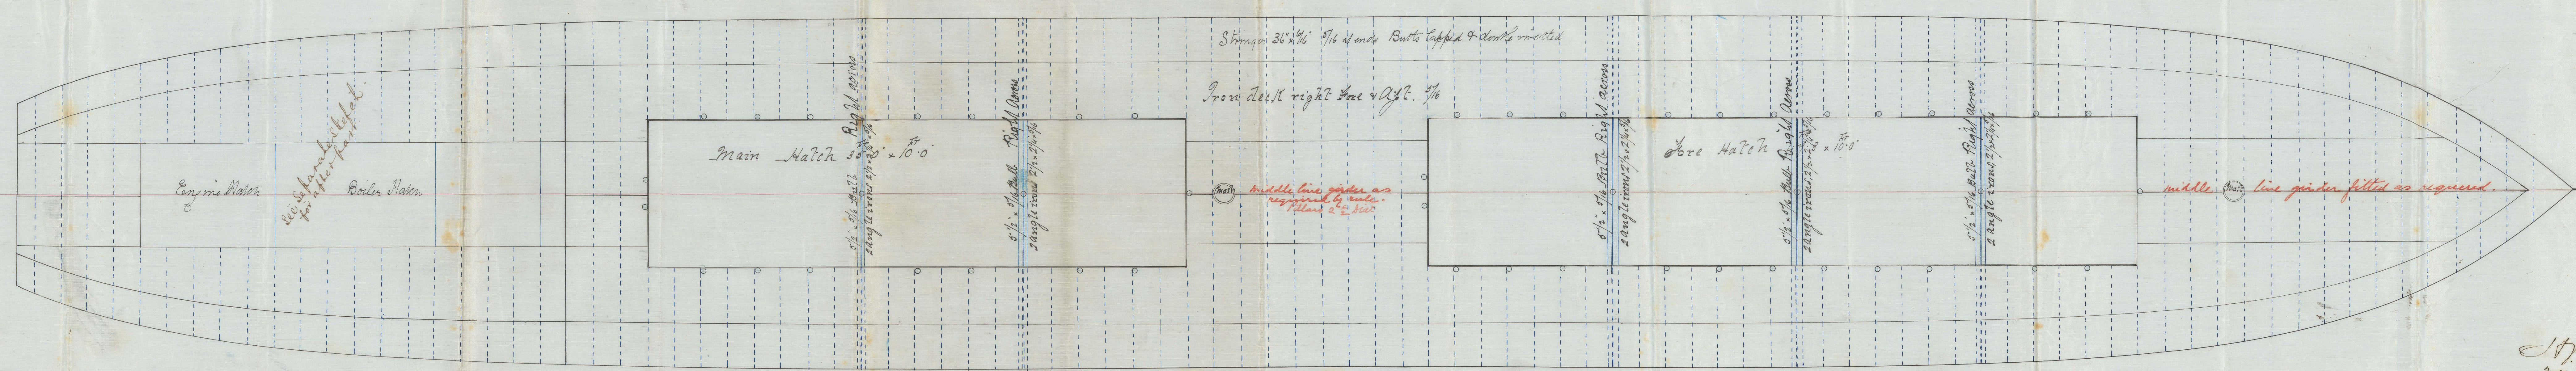


21.11.79

S. S. "Harley" of Cork
Greenock Report
No. 1/190.

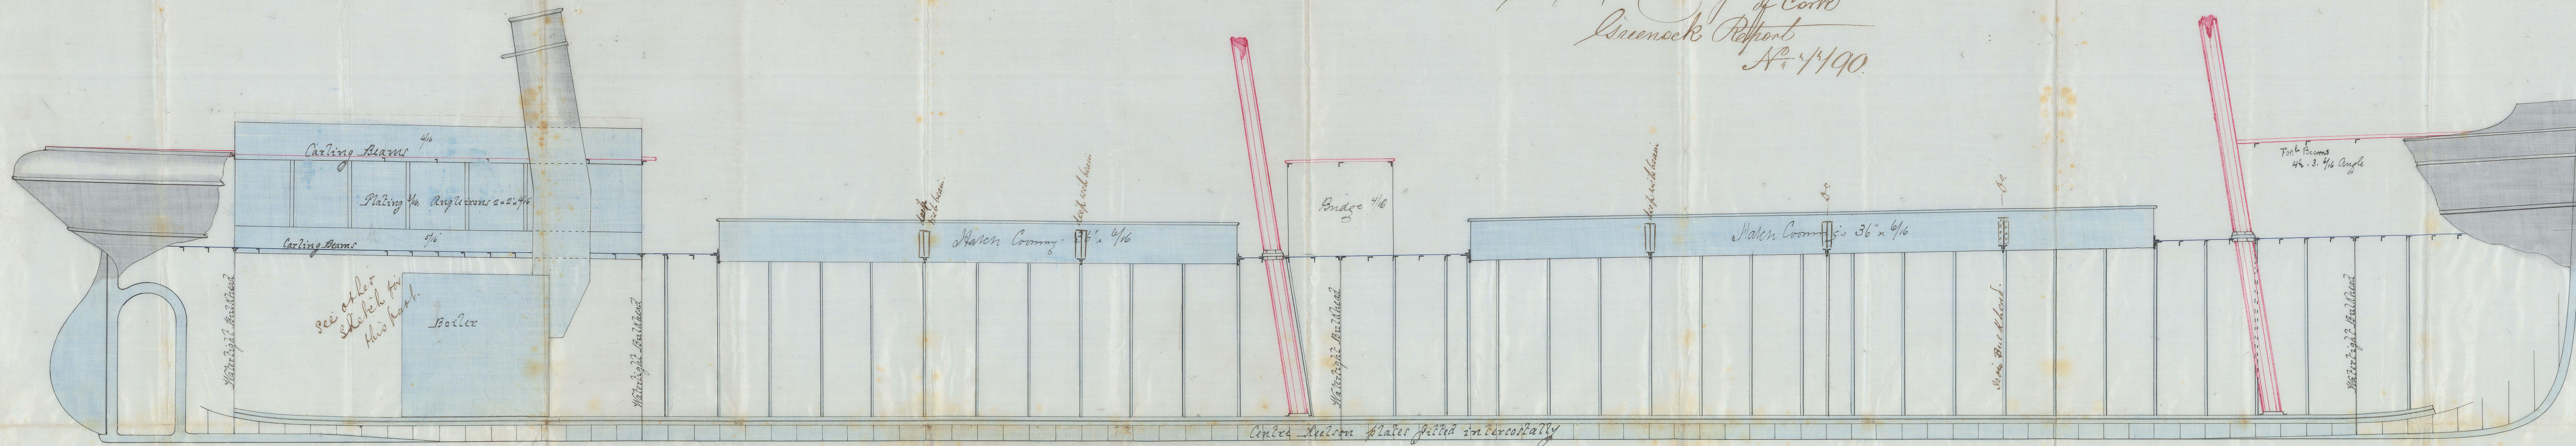

Longitudinal Main D^e Section
S. S. No. 27
Scale 1/4 inch = 1 foot

21/11/79

10/11/79