

Lloyd's Register of Shipping  
Bristol

29 May 1880

S.S. "Ashburne". Sketches illustrating nature of Damage sustained  
in March 1880. through a blow from a sea - when on voyage from  
Bristol to Baltimore: also work disturbed in effecting repairs at Baltimore

Scale  $\frac{1}{4}'' = 1$  Foot

Figure 2  
Part Plan of Upper Deck


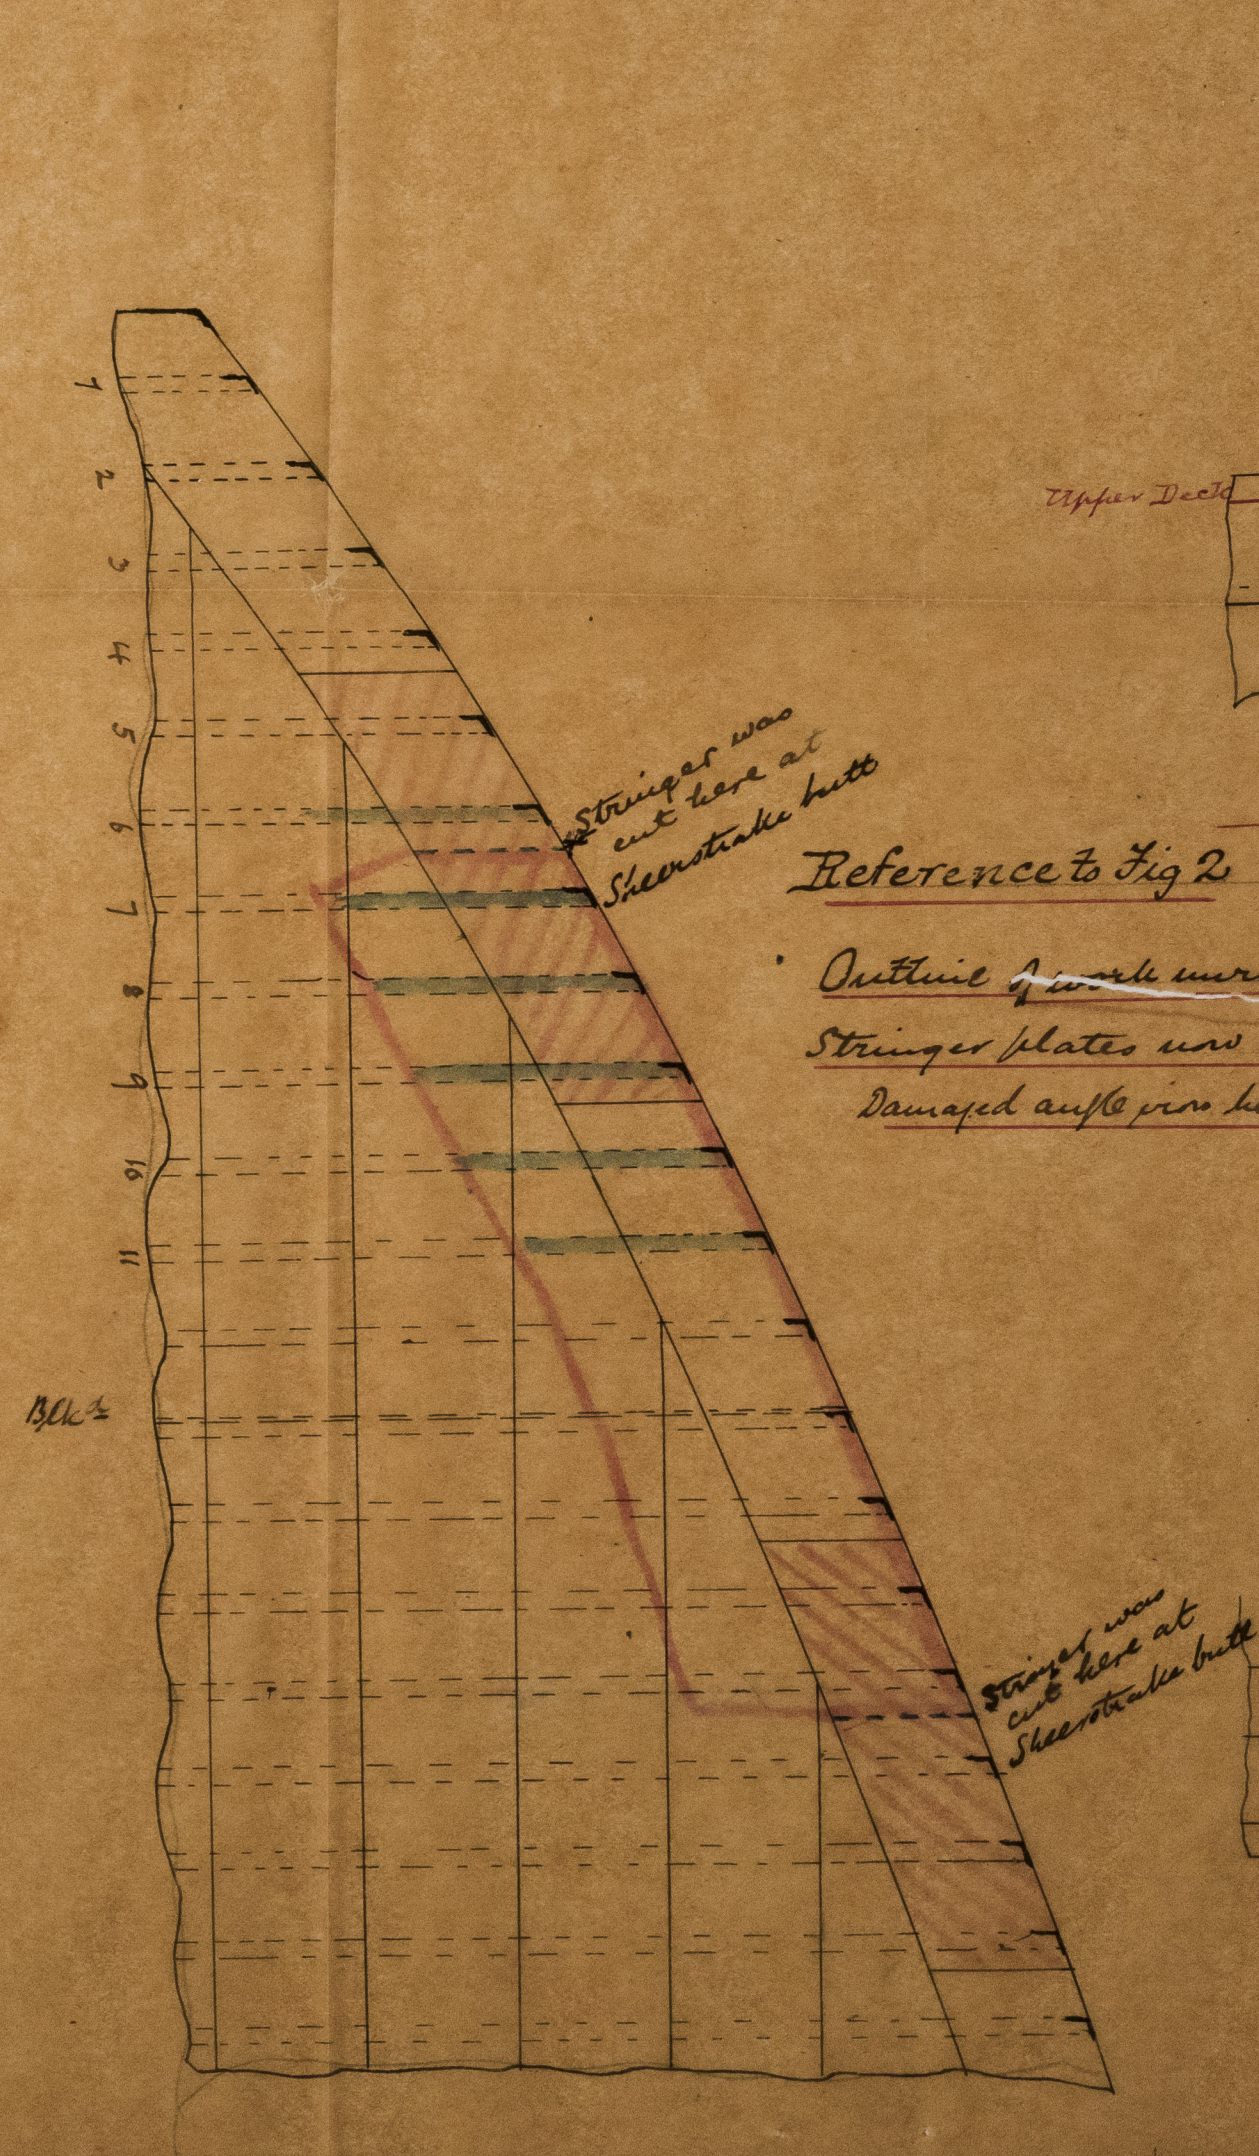


Figure 1  
Profile

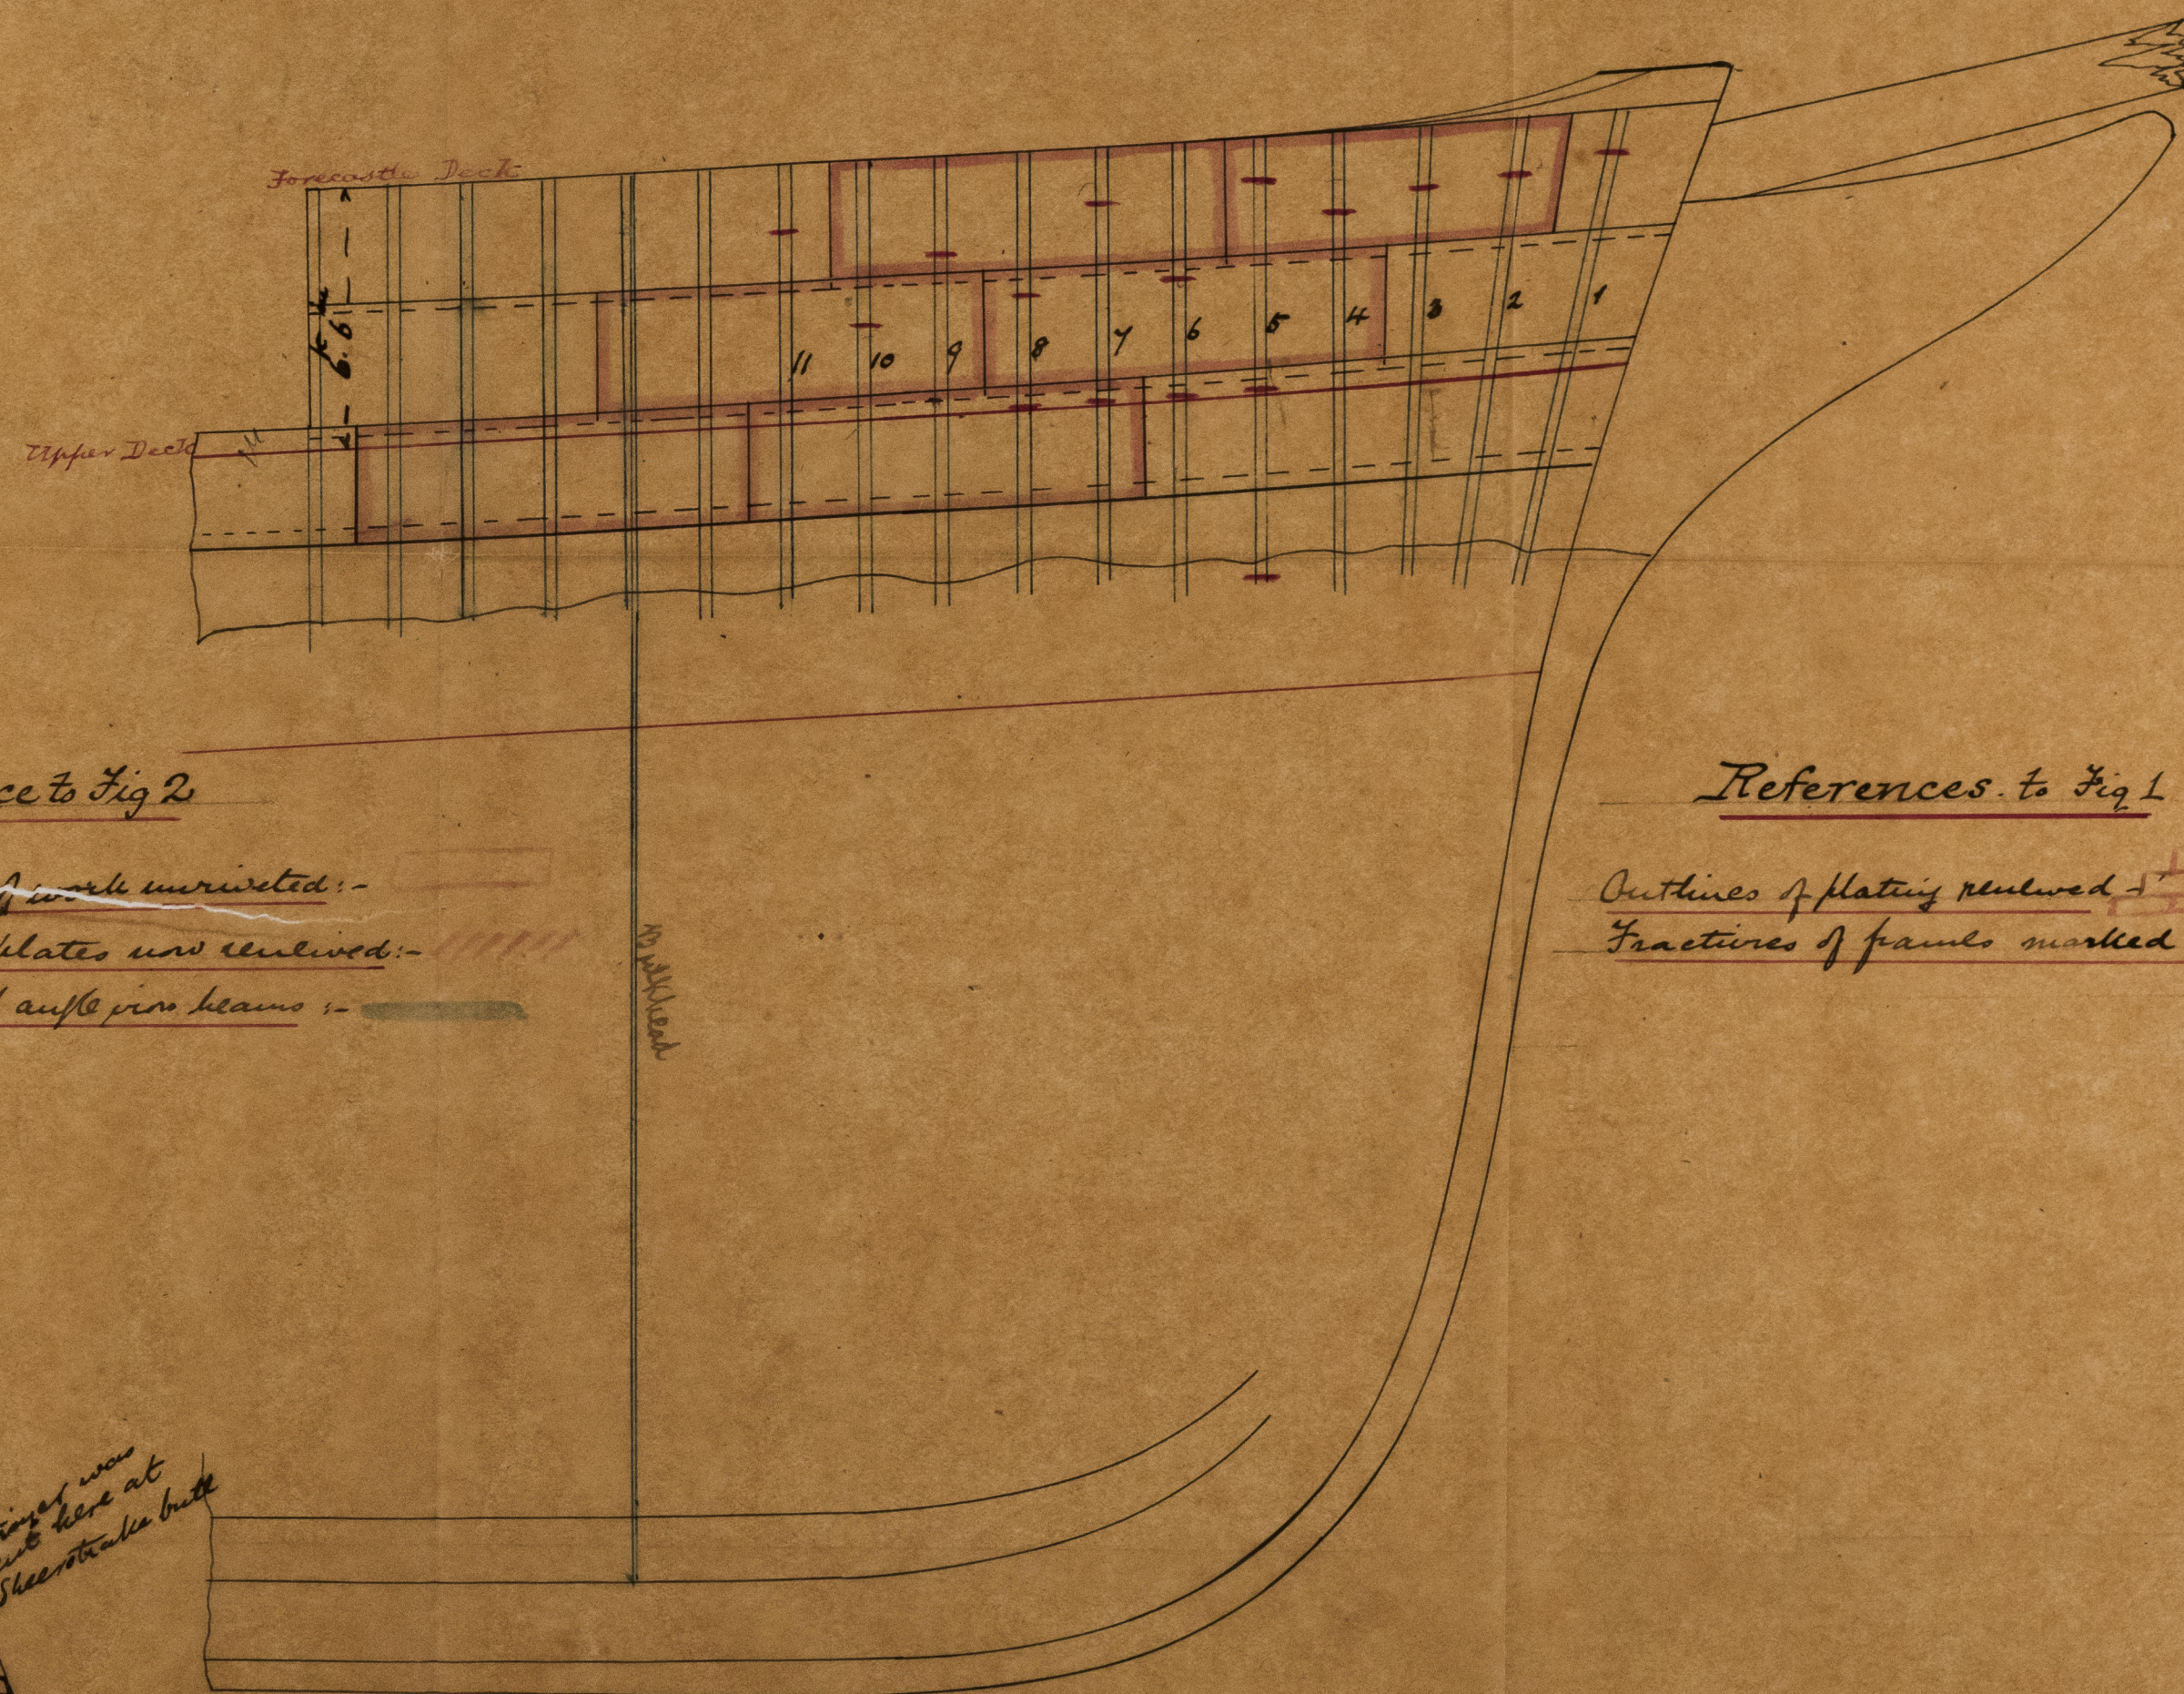

S. Heath.