

Midship Section of SS N<sup>o</sup> 5  
Scale an  $\frac{1}{8}$  of an inch to one foot

S. S. "Redland" of Bristol  
Guenock Report N<sup>o</sup> 4808.

Length for Loods 98ft 0" x 18ft x 8ft 6" hold  
Pen to Br 5.5 times Len to Depth 10.4  
N<sup>o</sup> for rules  $\frac{1}{2}$  girth 16ft 2" breadth 9ft Depth =  
9ft 6" = 34.66 = 3396 Equipment N<sup>o</sup> 3/36  
Class 90 A  
Raised quarter deck


$\frac{1}{2}$  Breadth = 9.  
Depth 9.5  
 $\frac{1}{2}$  Girth 16.16  
34.66  
98.

3396.68  
Equipment to 3396.66  
3736.34

Breadth to Length = 5.4  
Depth to " 10.3

23.1.79

Rec 23/1/79

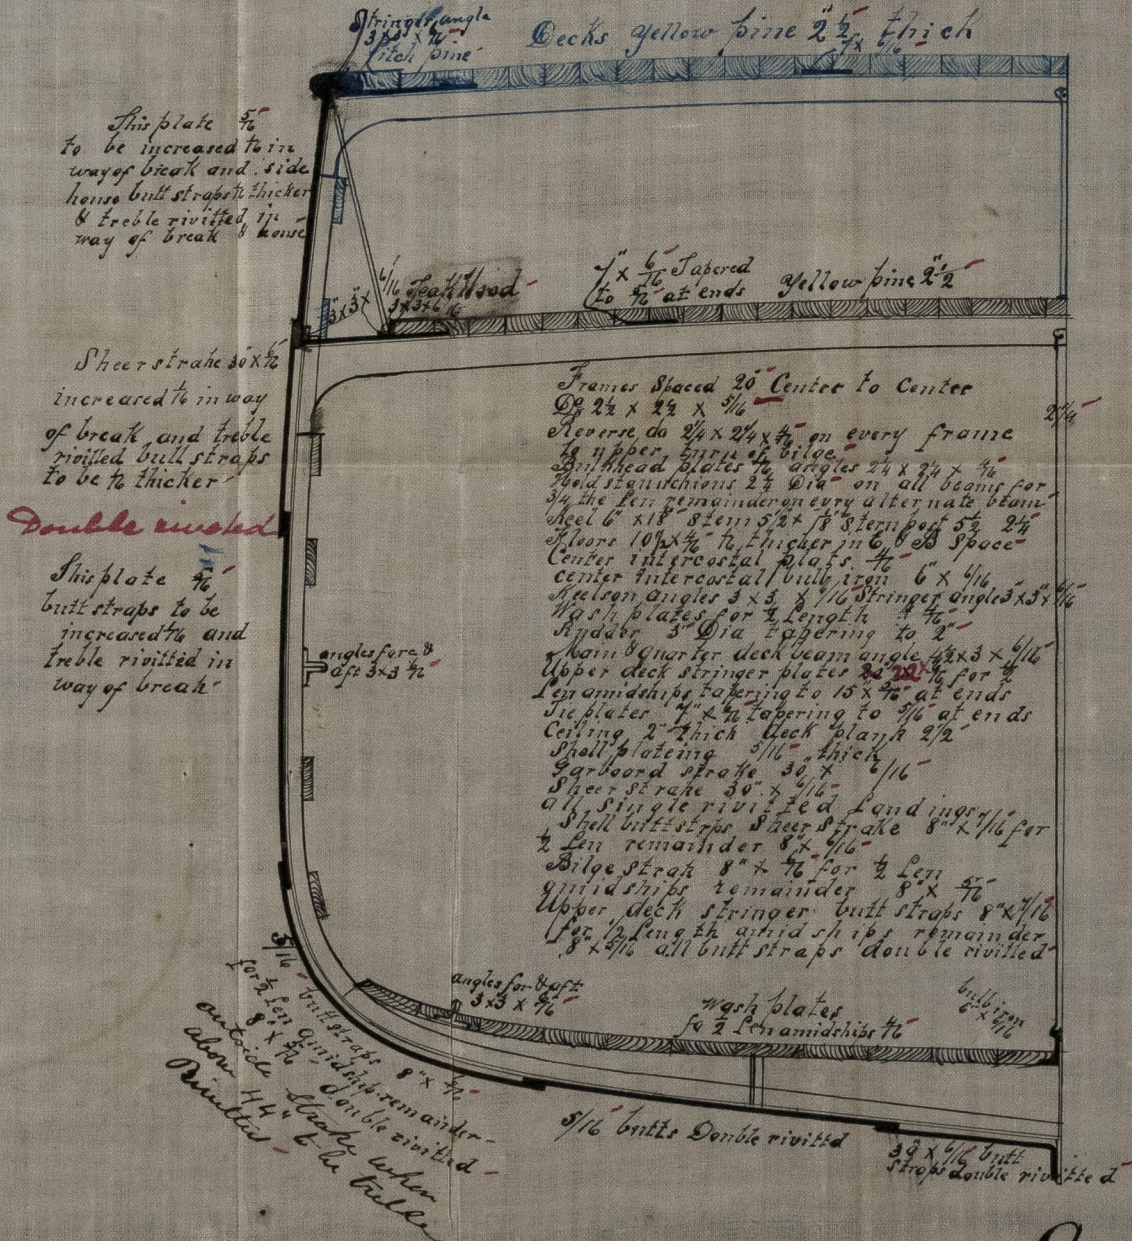

BM  
23/1/79

Campbeltown Shipbuilding Coy.

Campbeltown.

10<sup>th</sup> Jan 1879

Lloyd's Register  
Foundation