


*S S "Redland" of Bristol
Greenock Report No 4808.*



23.1.79

Rec 23/1/79
SH

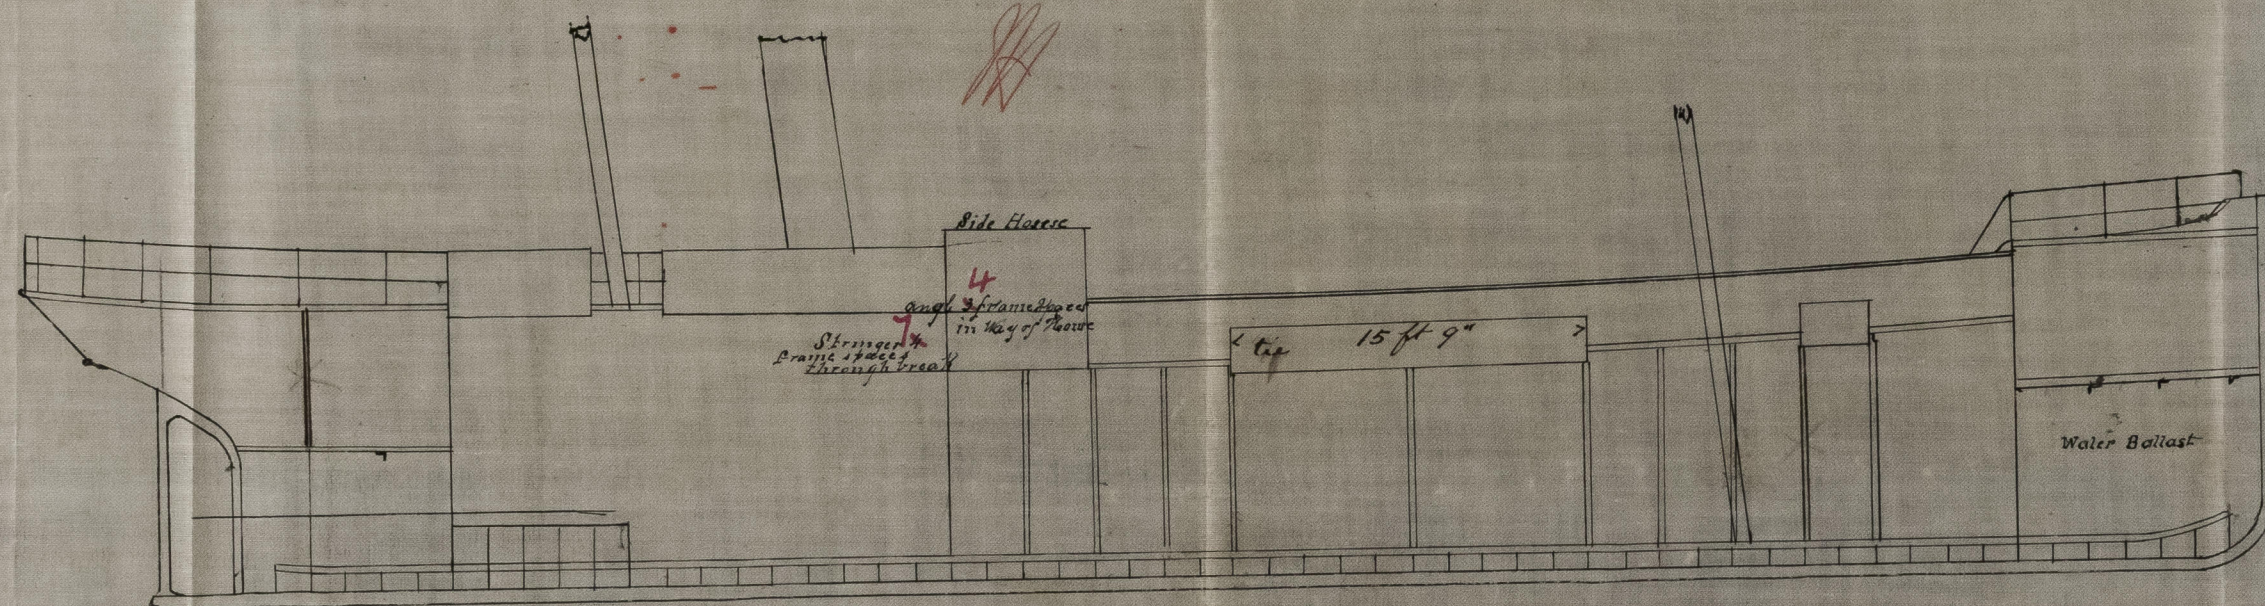

BM
23/1/79

*SS No 5
Scale 1/8" to one foot
Campbeltown Shipbuilding Co
Dec 26th 1878*



*Lloyd's Register
Foundation*