


8400-52431

11/11/79

Profile N° 244 *S.S. "Lunna" (Benalder - sister vessel)*
Scale 1/8" = one foot
Glasgow Report No. 5123

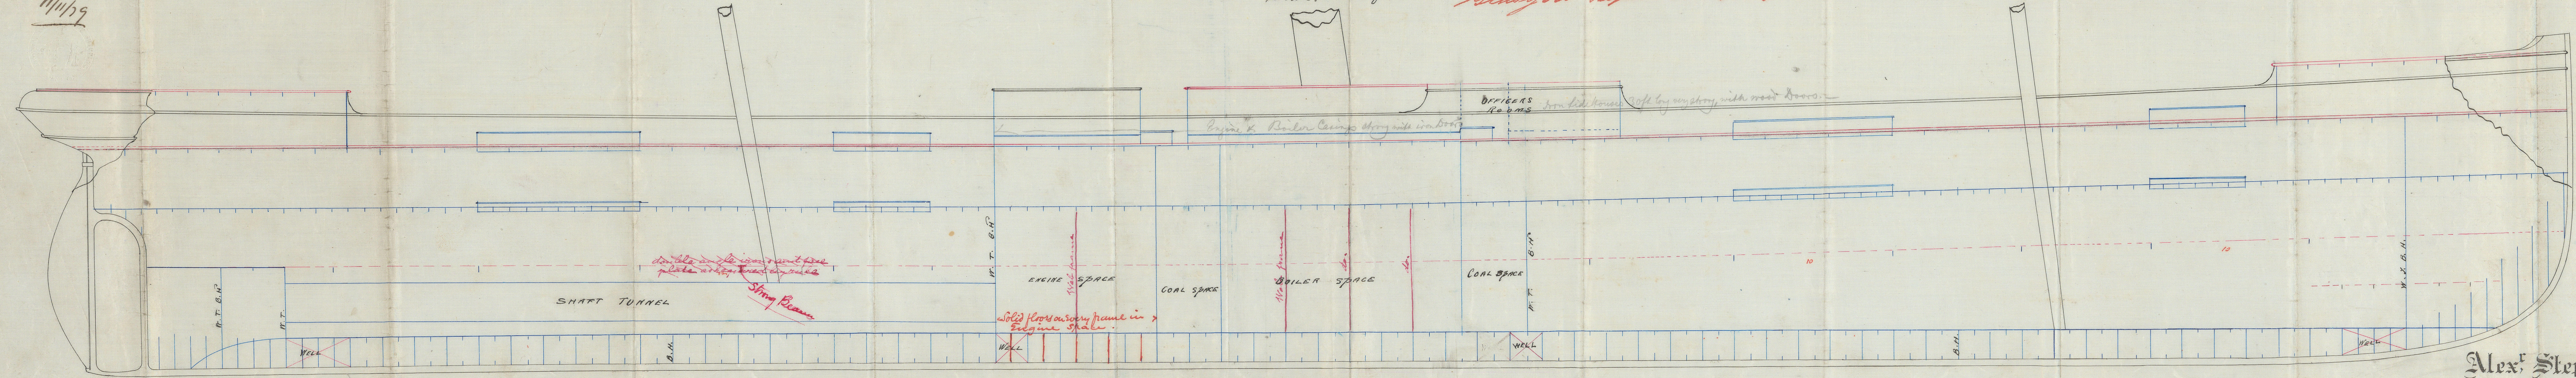

Alexr Stephen & Sons.
SHIPBUILDERS & ENGINEERS

GLASGOW

DRAWING N° 1519

Ex^d 5/11/79

11/11/79

Lloyd's Register
Foundation