

1879

MIDSHIP SECTION

S.S. N^{os} 135-136

248.11' x 31.0' x 19.2' (KEEL TO BEAMS)

WITH RAISED QUARTER DECK & BRIDGE HOUSE

TO CLASS 100A1 AT LLOYDS

SCALE $\frac{1}{2}$ " = ONE FOOT


NUMERALS

$$19.10 + 15.5 + 32.0 = 66.66 \text{ FRAMING NUMBER}$$

$247.58 \times 66.66 = 16,503.68$ PLATING "

16,503.6 + 1650.3 = 18,153.9 EQUIPMENT "

7.9 BREATHS, 12.9 DEPTHS

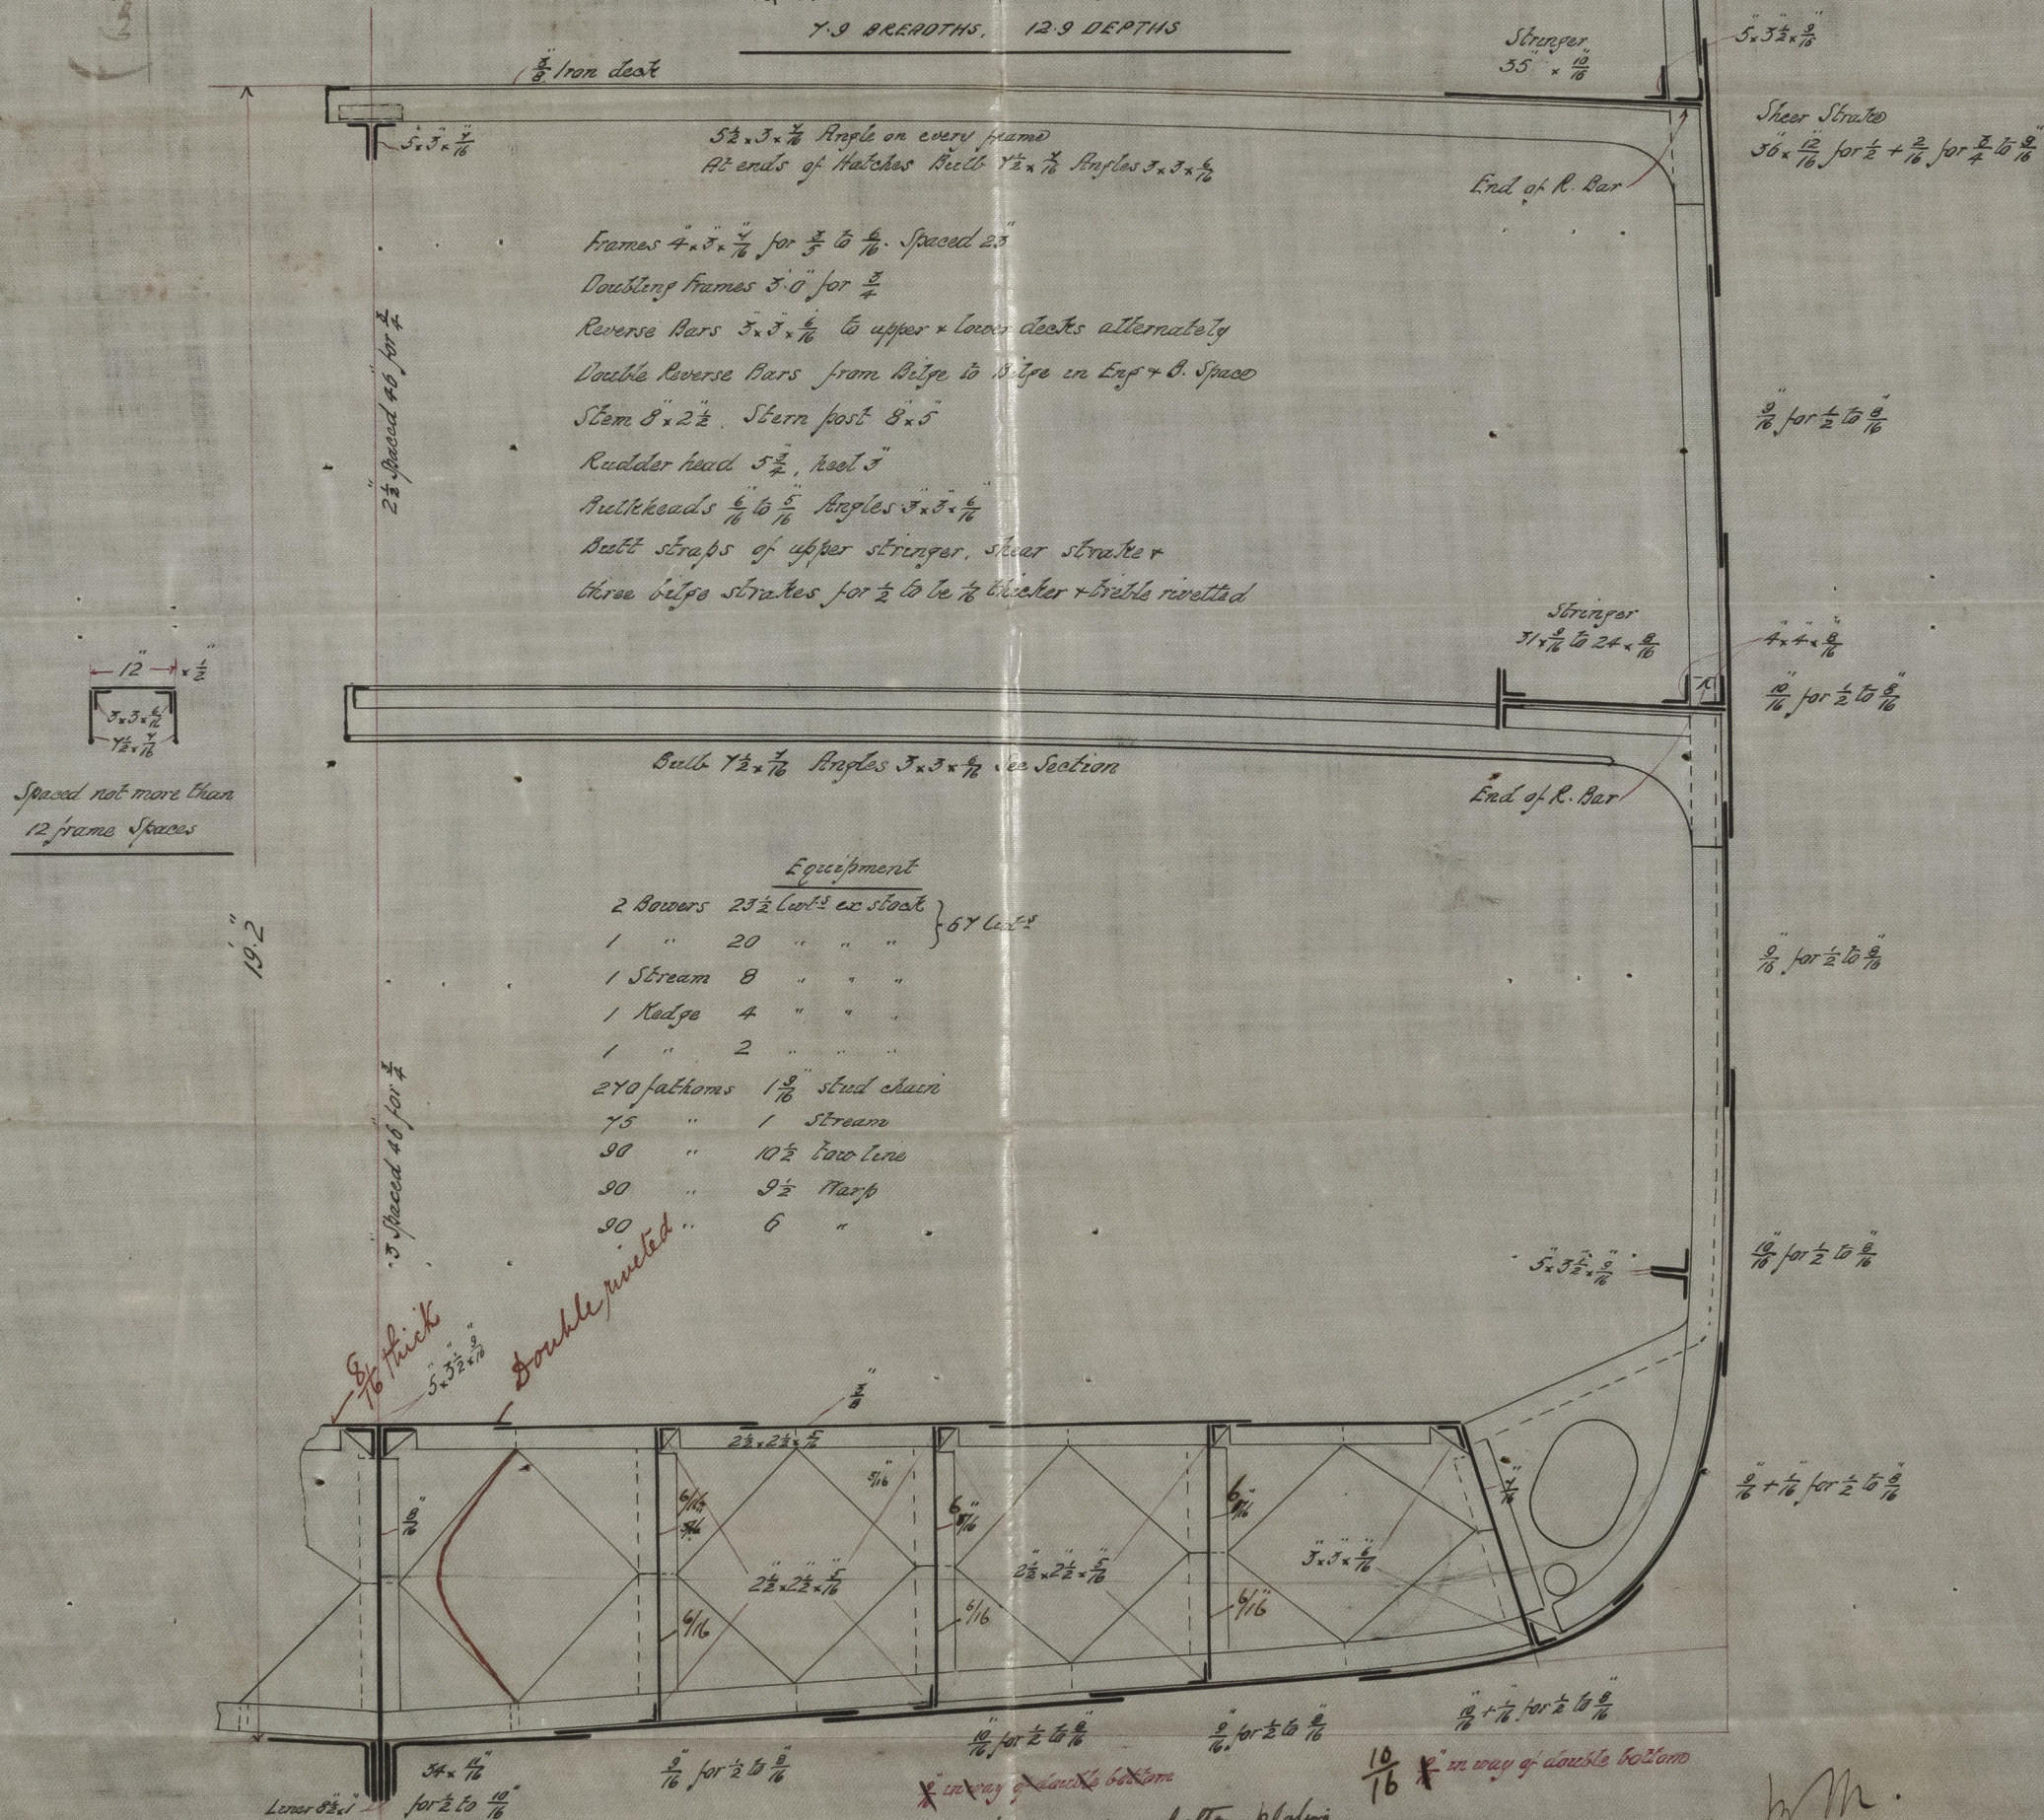

2/10/79

S/S "White Head"
In. 27183

(also to "Black Head")



© 2021

Lloyd's Register
Foundation