

Lloyd's Stamp

1504275-0100

Copy

S.S. "White Head"


Belfast Report No. 2697

Profile of S.S. No. 1358/136  
Scale  $\frac{1}{2}$ " = one foot  
248'-11" x 34'-0" x 14'-2" (Kul to Beams)

14 Nov

1879

Lloyd's Stamp  
20.11.79

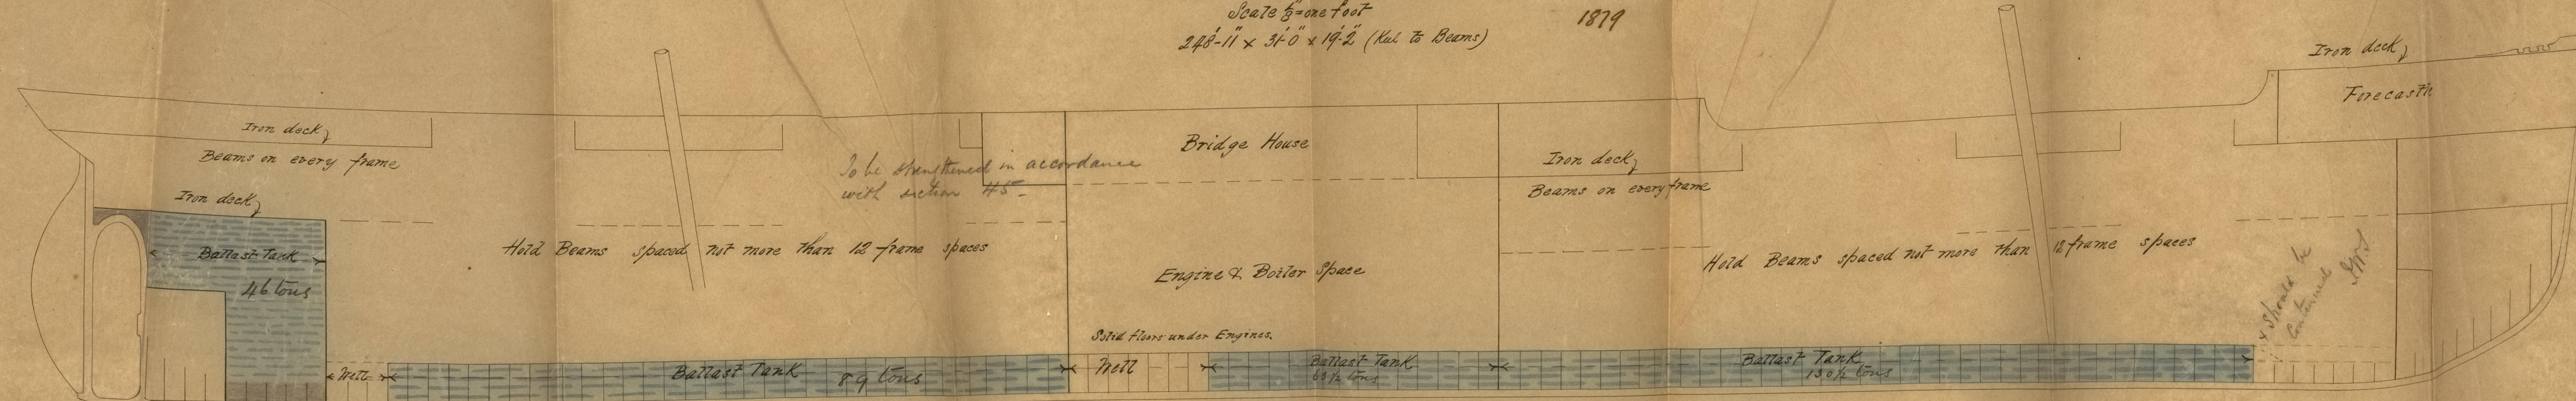


(Copy of 1879 report)  
J.M. 11/11/79  
J.M. 11/11/79

15/11/79

13m  
20/11/79



Sm 27183  
% White head  
(also % Black head)

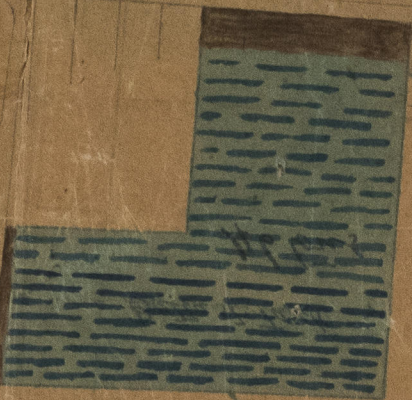

Iron rock

Black in second frame

Iron rock

H99



© 2021

Lloyd's Register  
Foundation

IRONS 42-0100