


24.11.79


L. L. Lippin English
Report No 4434

Measur Section of No 44 SS.
Sole 2-14
Miles Turnbull & Son Whitley November 1879

Section through A & B Deck

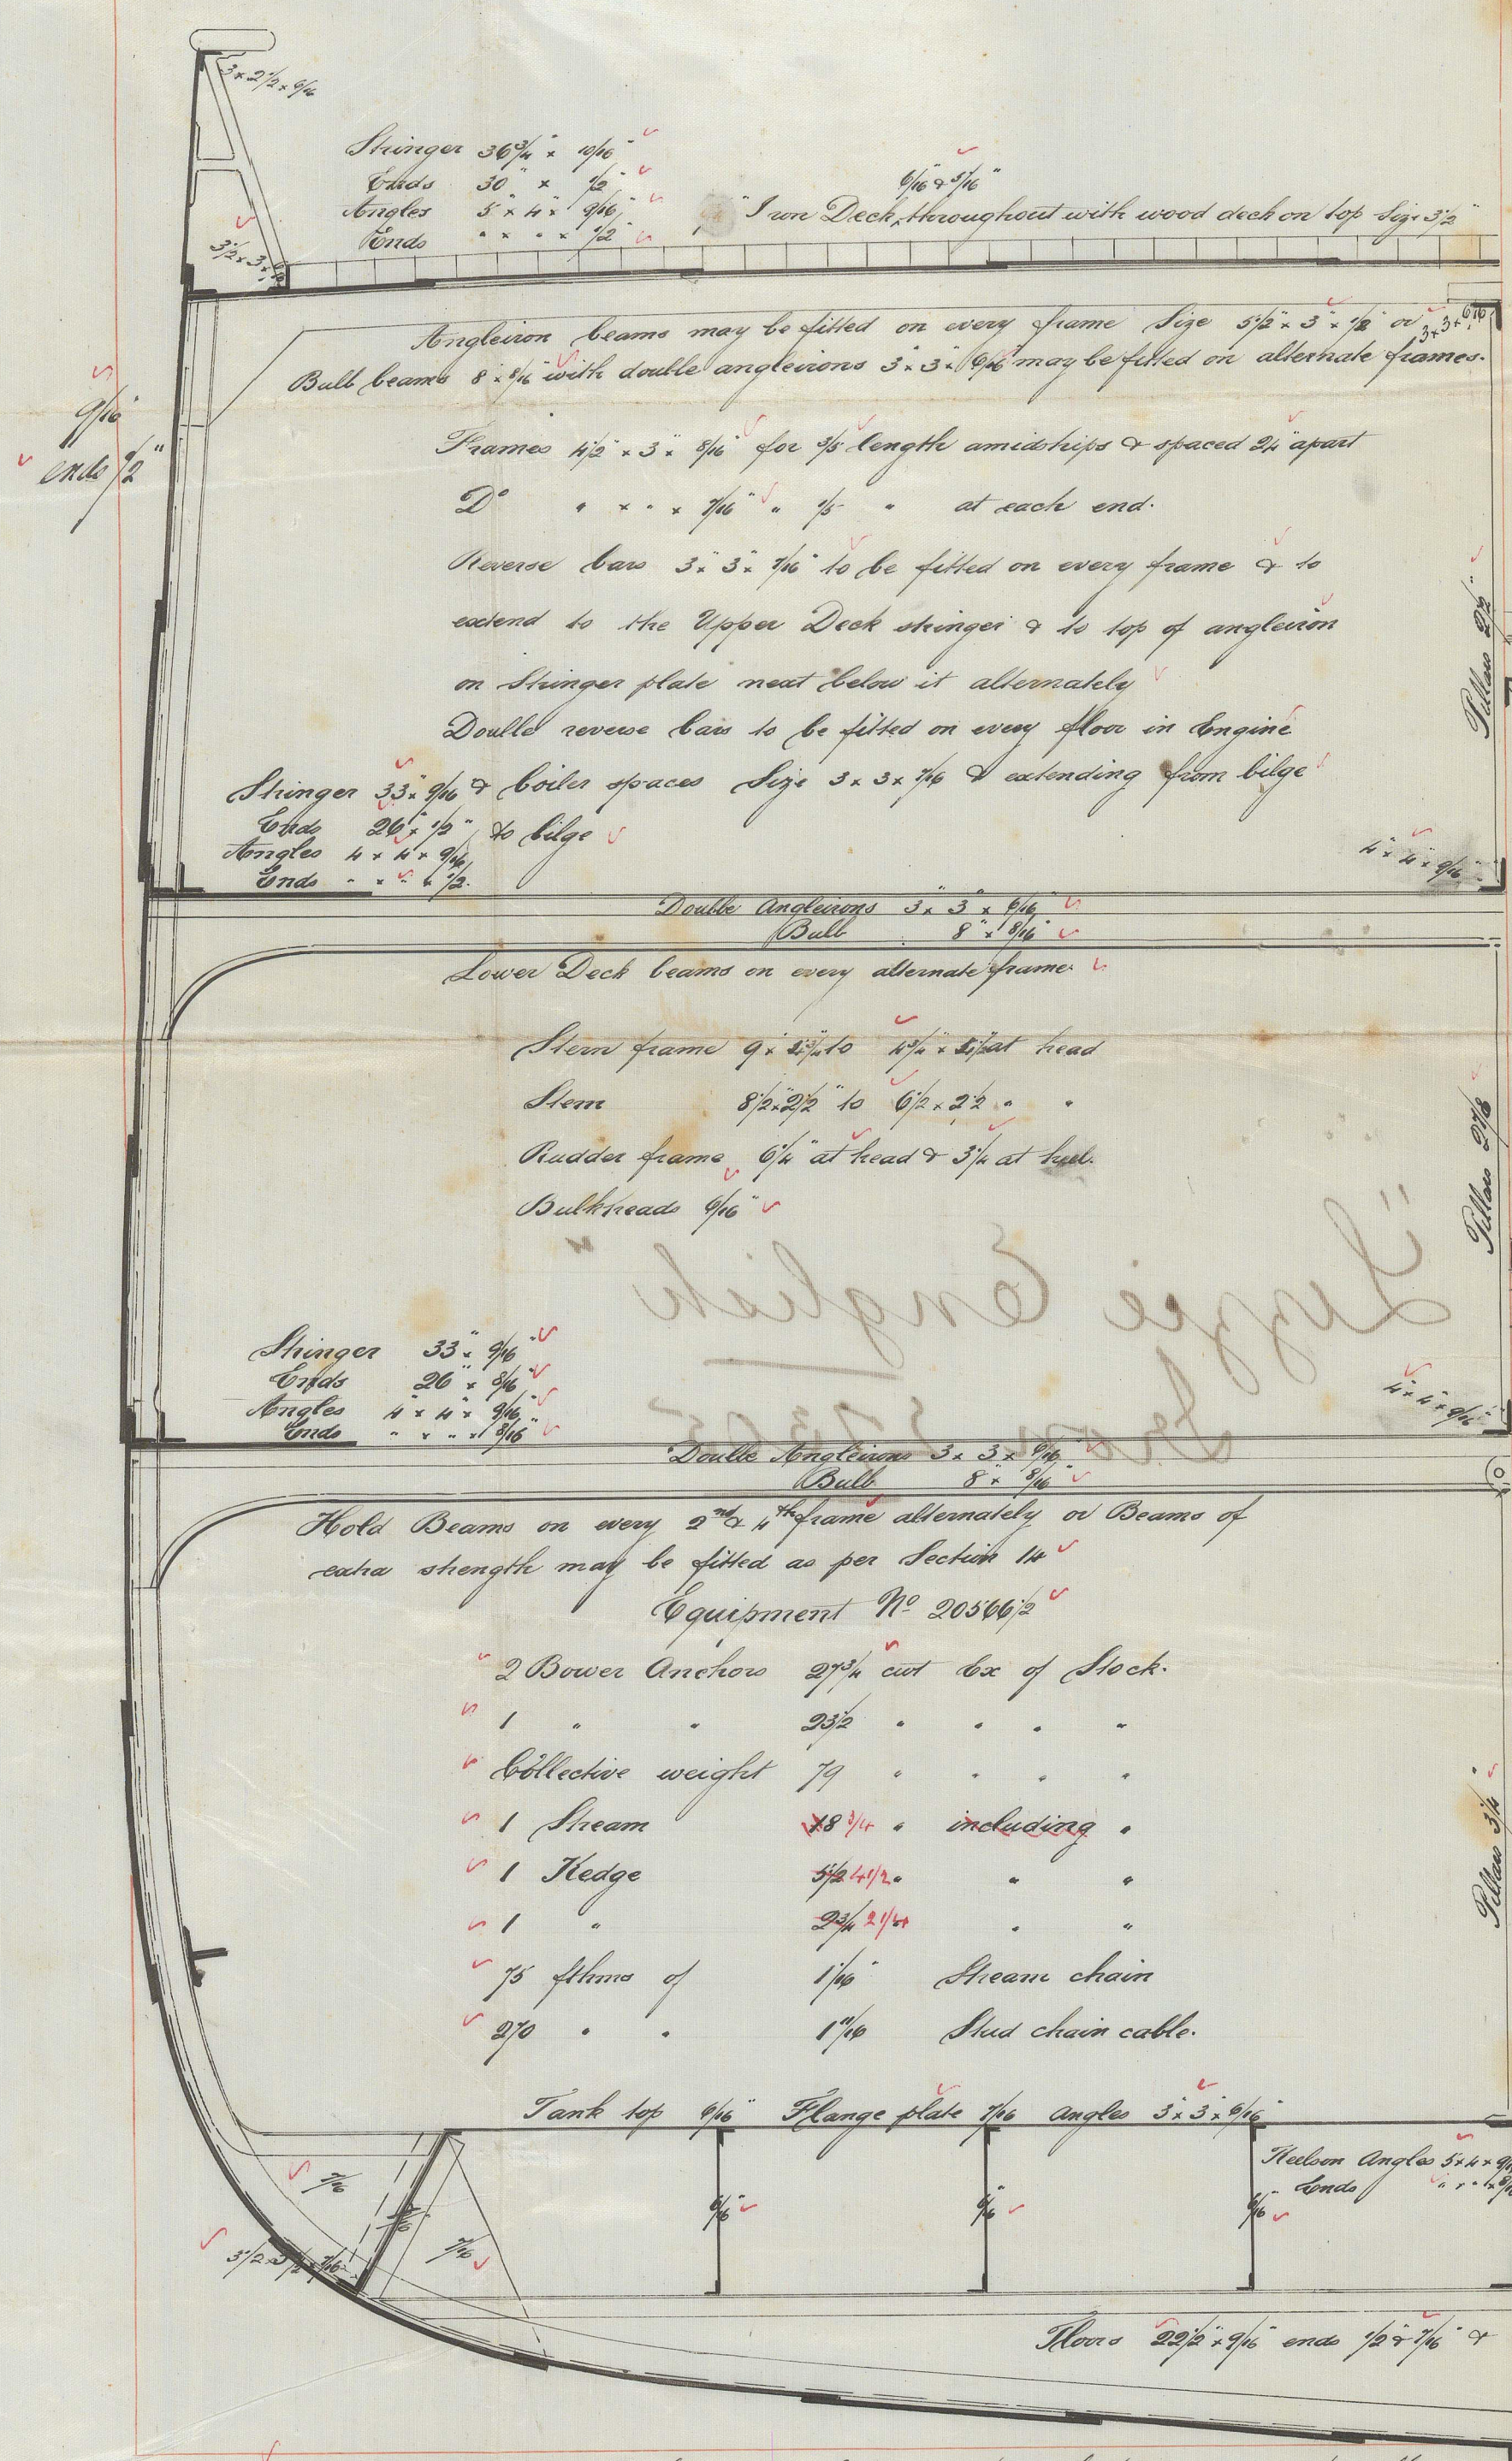

Section through Bridge & Engine Space

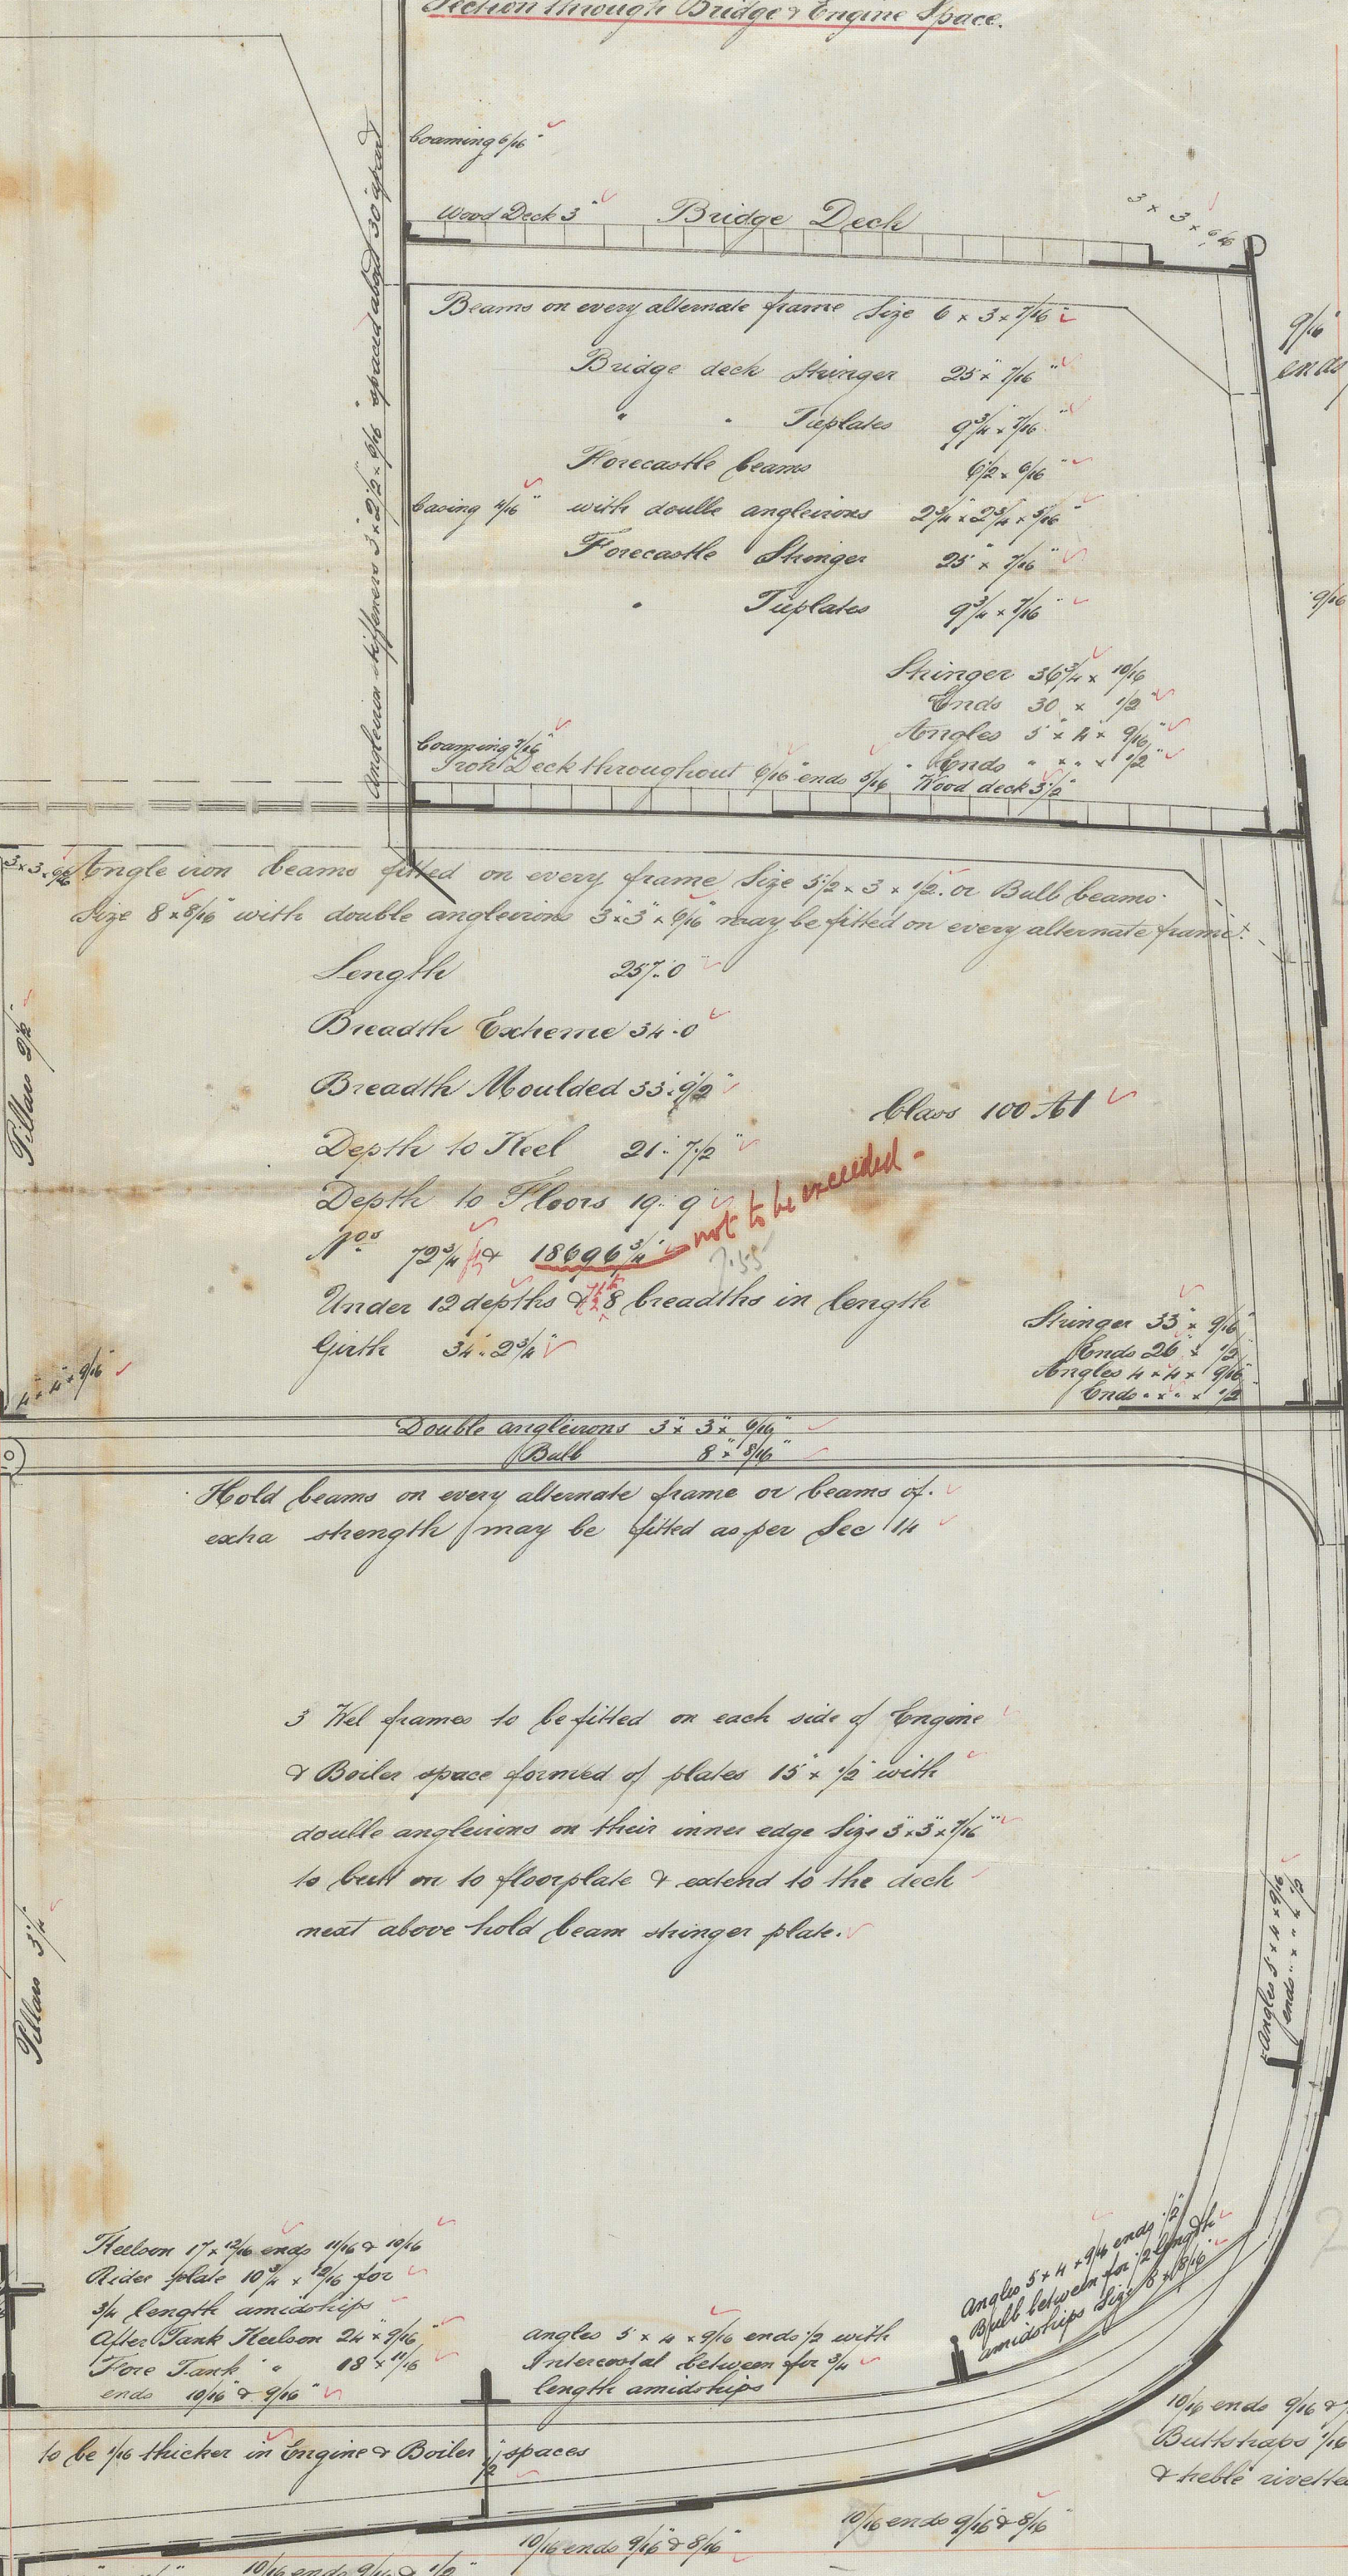

All outside plating except Garboard may be reduced 1/8 in thickness, in way of double bottom, provided that thickness be 1/8 in or more.

5 feet frames to be fitted on each side of engine & boiler space formed of plates 15 x 1/2 inch double angle irons in their inner edge 3 x 3/4 inch to bolt on to floor plate & extend to the deck next above hold beam stronger plate.

22/11/79

21/11/79

"Lizzie English"
Iron. 27305



180542-0171



© 2021

Lloyd's Register
Foundation