


98.11.79

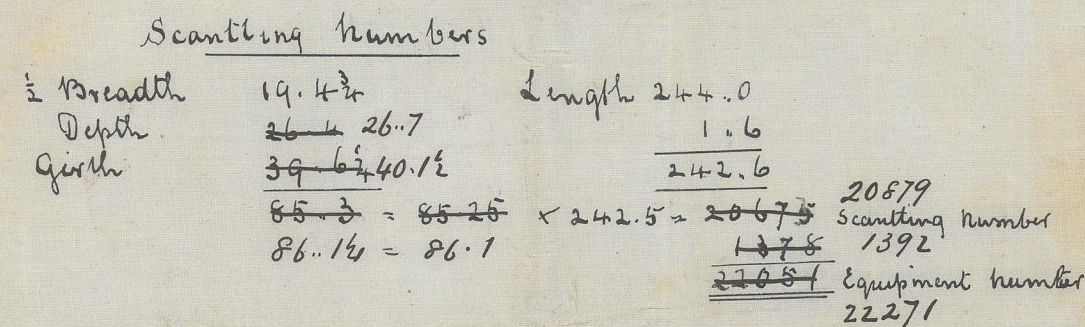

LENGTH OVER ALL 262.0
Do. B. P. 244.0
BREADTH *extreme* 39.0
DEPTH IN HOLD ~~11~~ 20.4
Do. MOULDED ~~25~~ 25.10
TONNAGE, GROSS *underdeck about* 1580 tons
Do. NET *about* 1630

SCALE.- $\frac{1}{2}$ INCH TO 1 FOOT

Class 100 A Lloyds

Roof about 46 ft Run

Beams	-----	6 x 46
Stringer	-----	24 x $\frac{3}{8}$
Ties	-----	9 x $\frac{3}{8}$
Gum wale angle	-----	5 $\frac{1}{2}$ x 3 x $\frac{3}{8}$
Plating	-----	$\frac{3}{8}$

Fore castle 28 ft long
 Beam Bulb $6\frac{1}{2} + \frac{3}{8}$ inches
 Stringer ----- $2\frac{1}{2} + \frac{3}{8}$
 Leo ----- $9 + \frac{3}{8}$
 Gun vane angle $5 \times 5 \times \frac{3}{8}$
 Plating ----- $\frac{3}{8}$



"Mooltan" Report
No. 4438

№ 26 1

STOCKTON-ON-TEES © 2021

Nov. 21st. 1879.

Lloyd's Register
Foundation

Proctor's 4438

~~4438~~
27407



© 2021

Lloyd's Register
Foundation

1802543-0030