


Ship Woolbar  
W. H. P. Report No. 4435



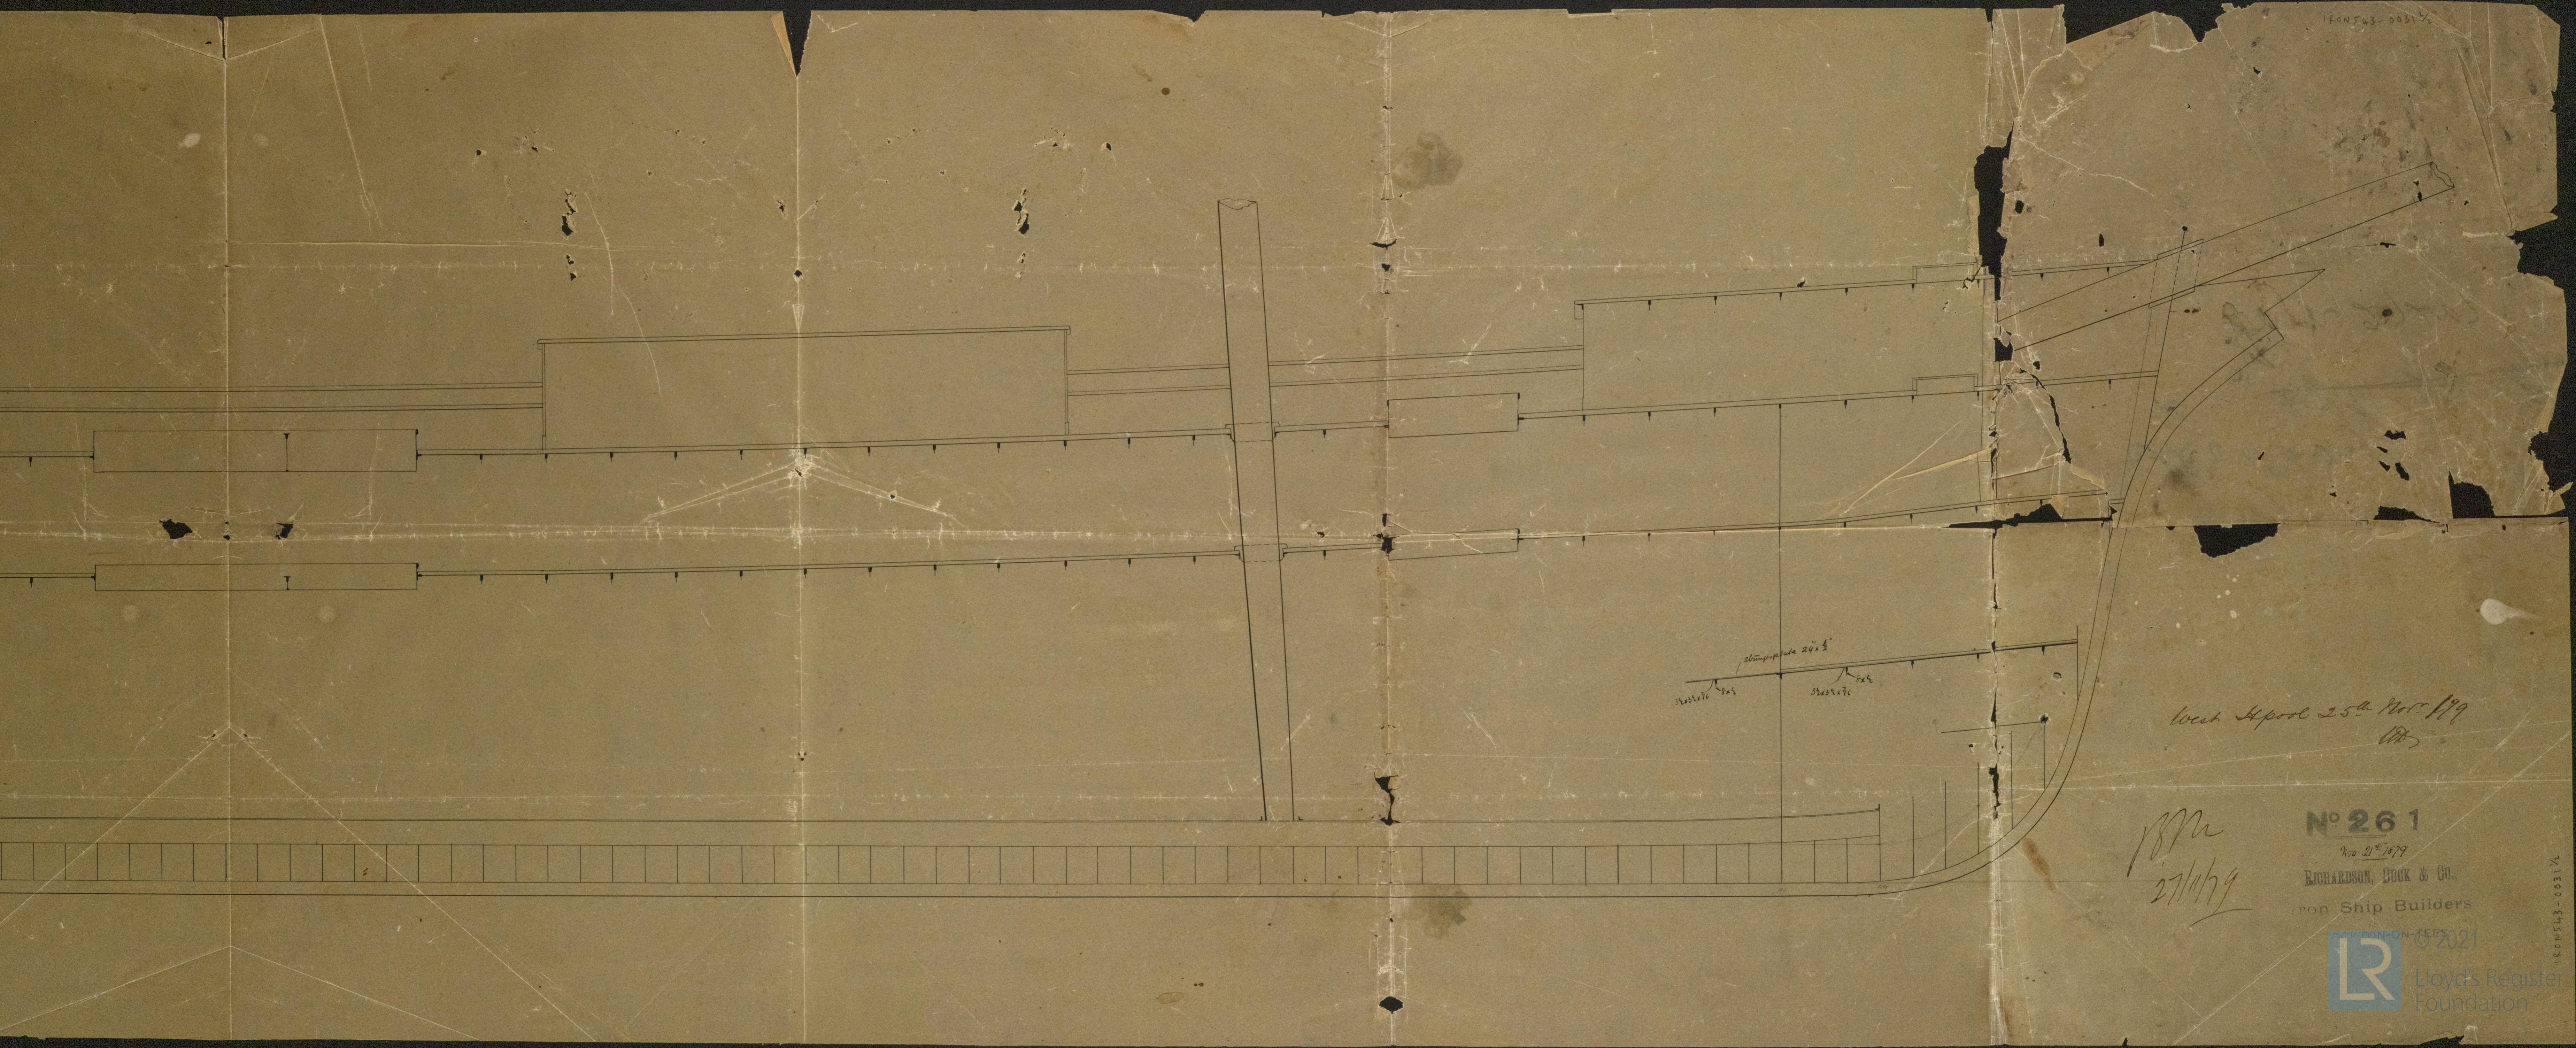

Stimpy plate 24 x 1/2  
3/16 x 1/2  
3/16 x 1/2

Work at pool 25th Nov 1879  
W.D.

1879  
27/11/79

Nº 261

Nov 21<sup>st</sup> 1879

RICHARDSON, DICK & CO.

Iron Ship Builders



© 2021  
Lloyd's Register  
Foundation

RON543-0031/4

120543-0031

Mooltan

~~Wpl 11438~~

Jan 27407



© 2021

Lloyd's Register  
Foundation