
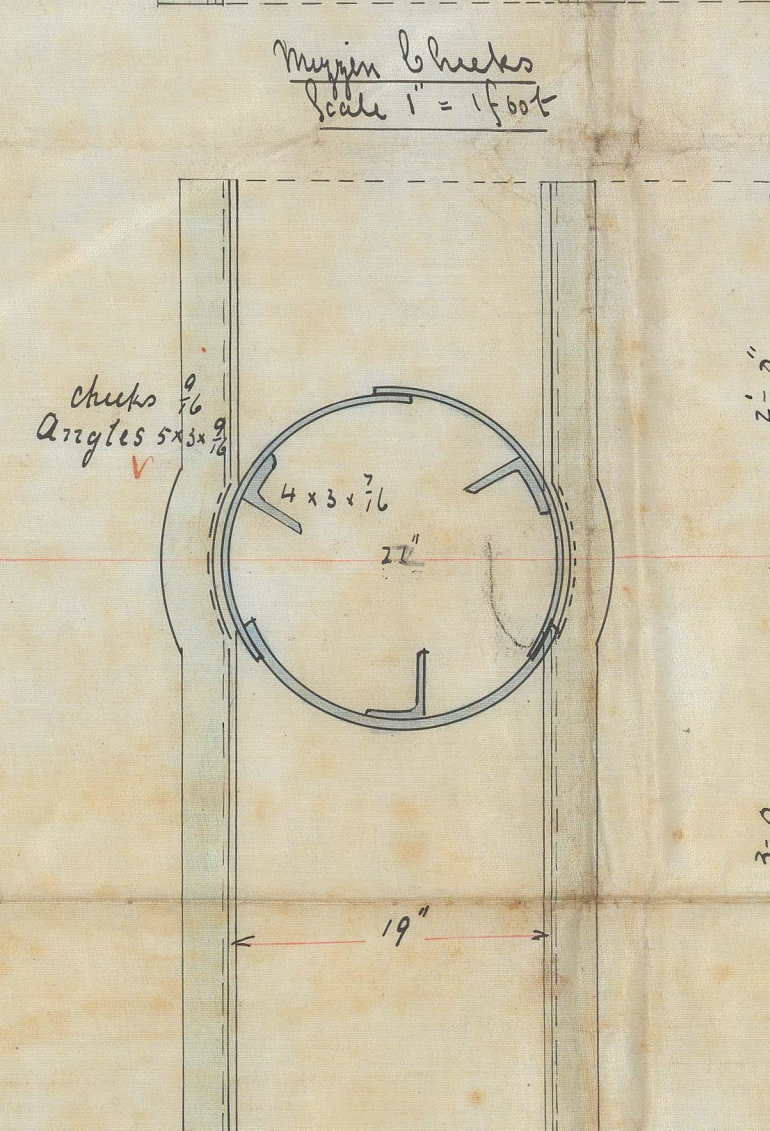
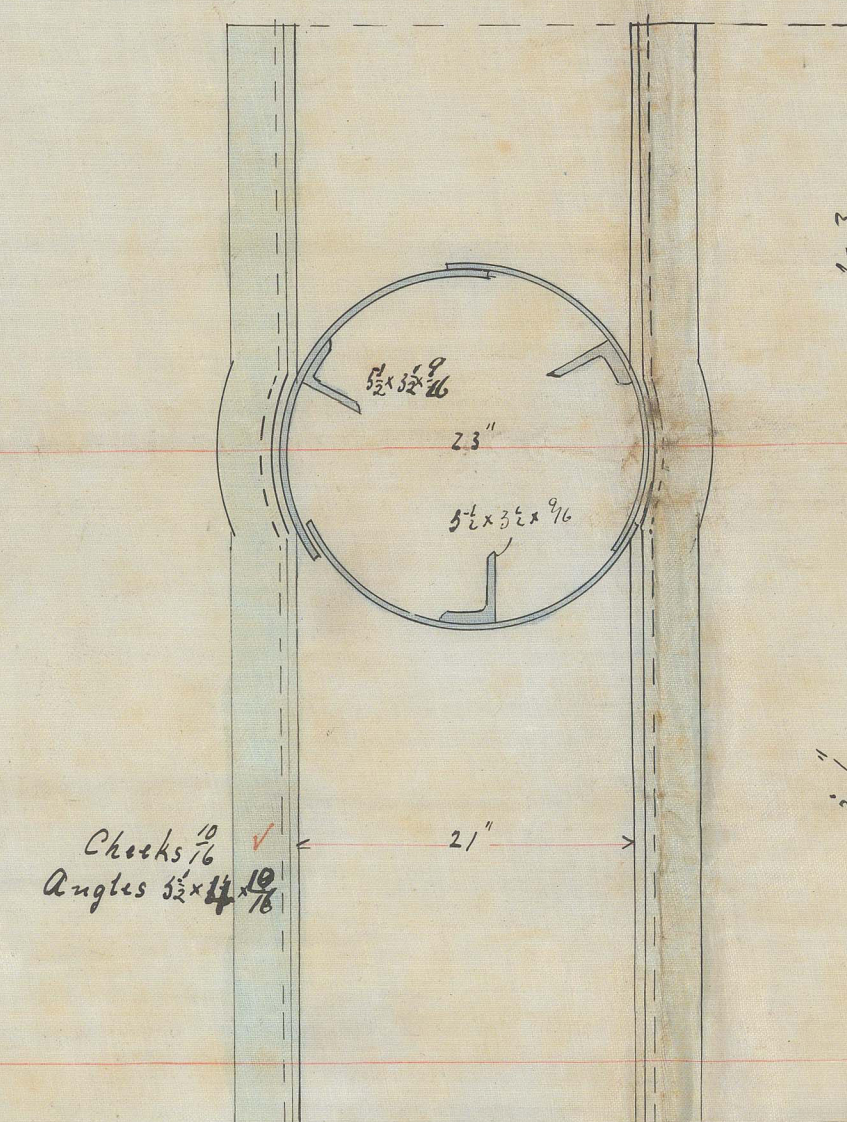





Put away
14/9/91
23.12.79
Ship "Mooltan", H. H. L. McPartick No. 4438

Iron Masts & Spars No 261 Ship
Scale 1/4" = 1 foot

Bore Checks
Scale 1" = 1 foot

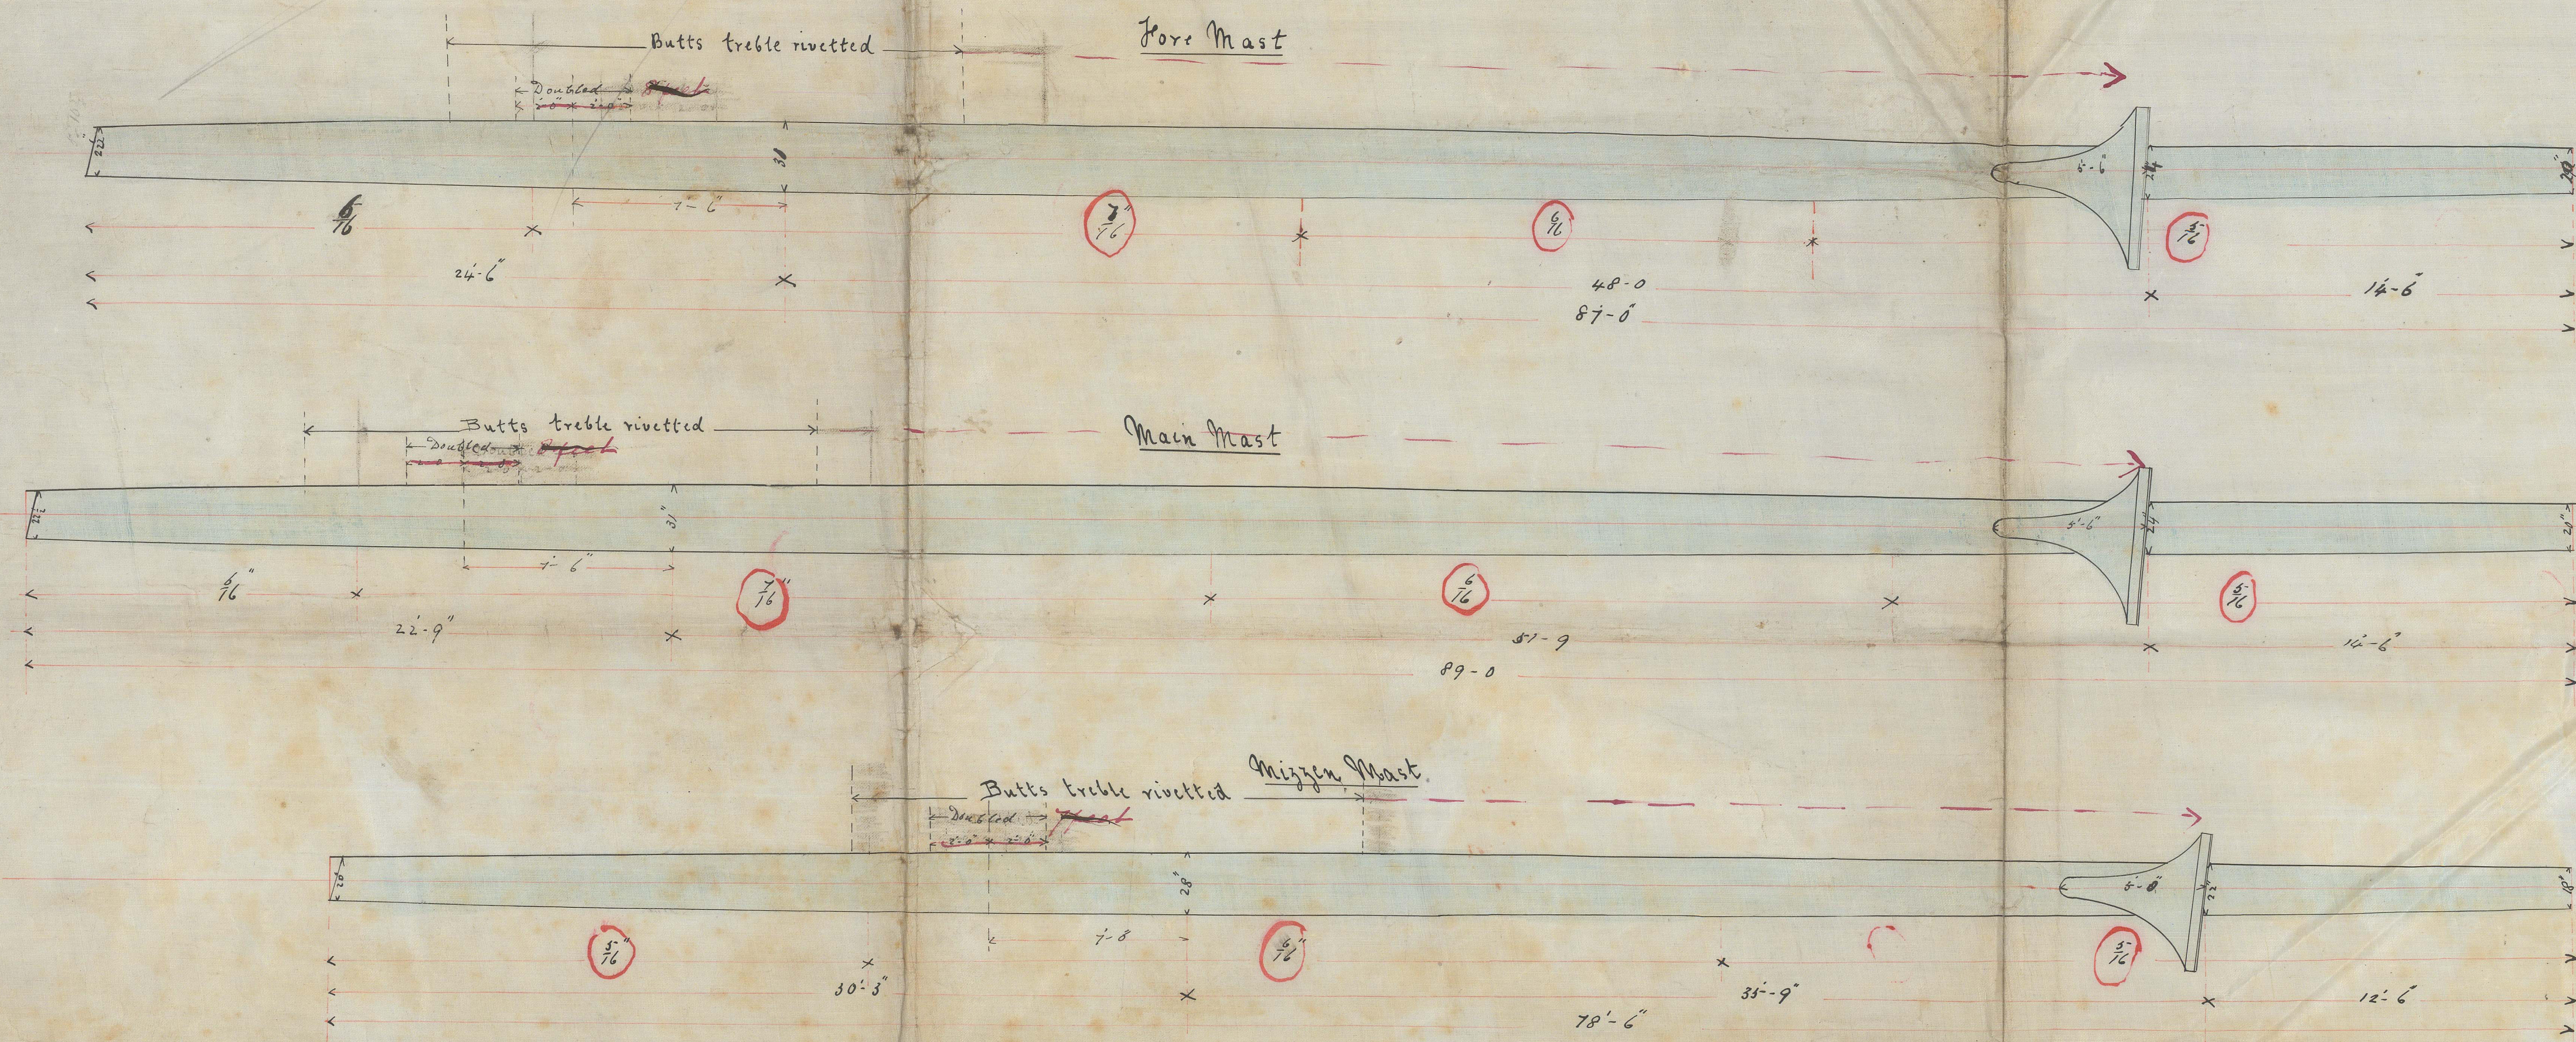

Main Checks

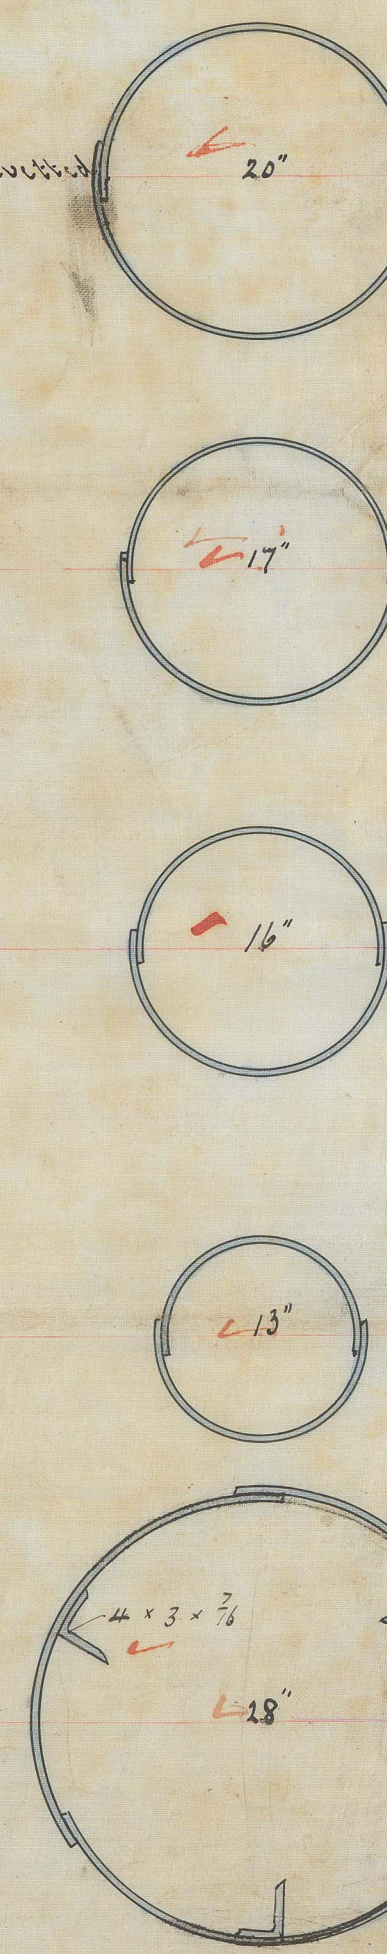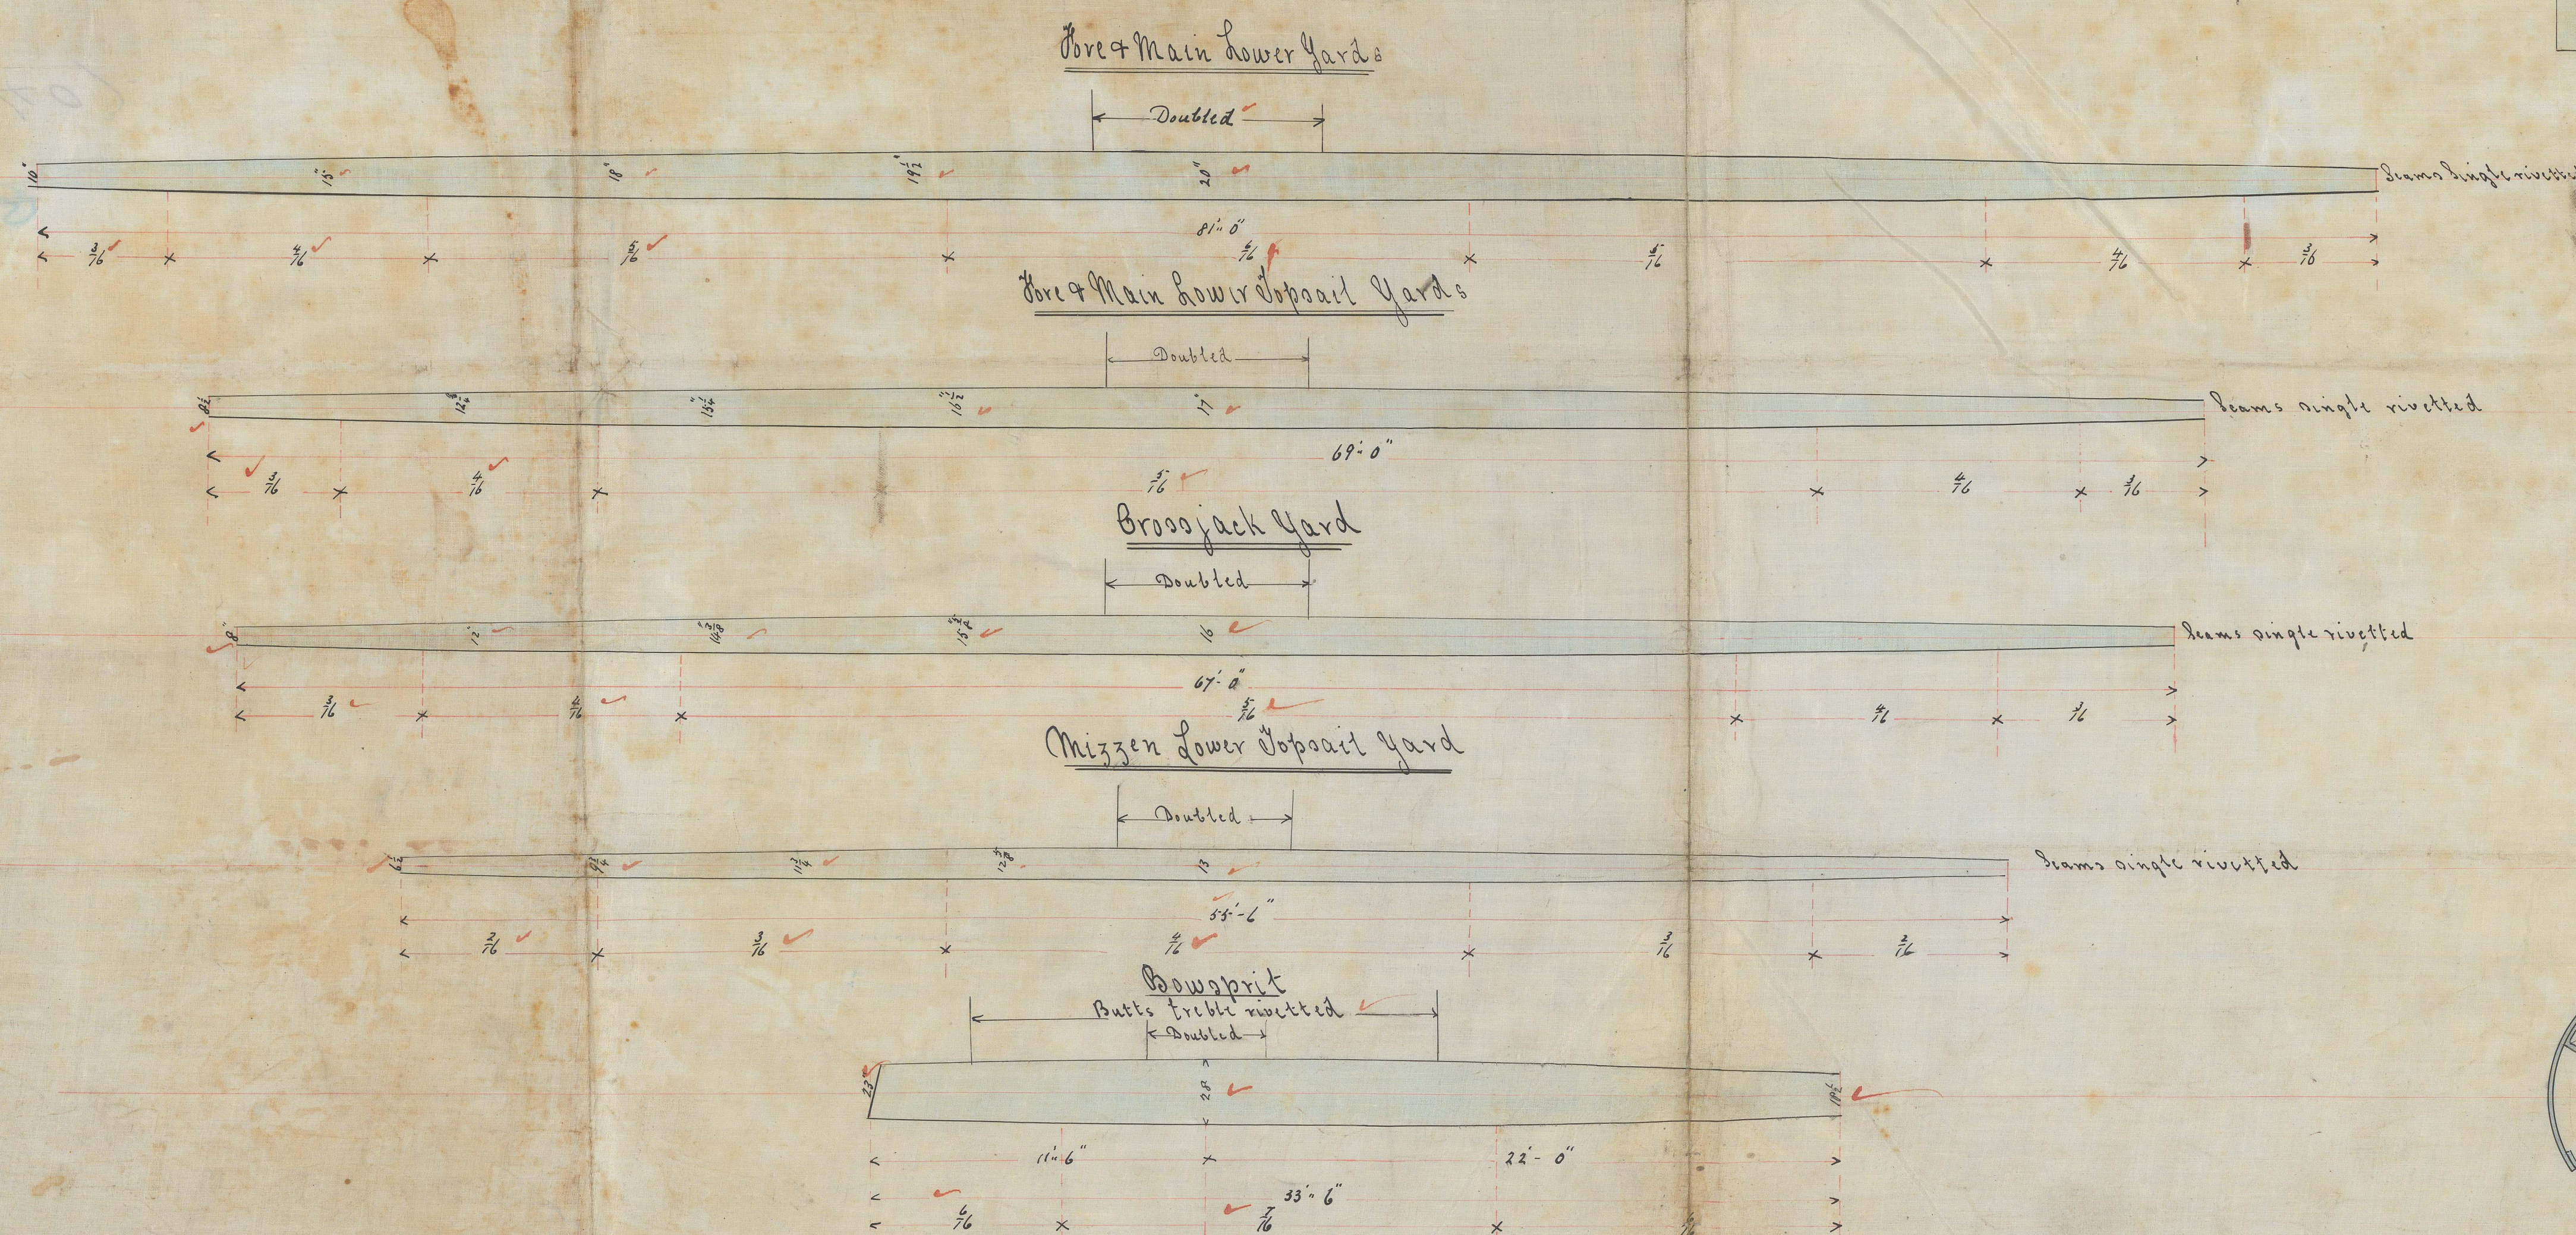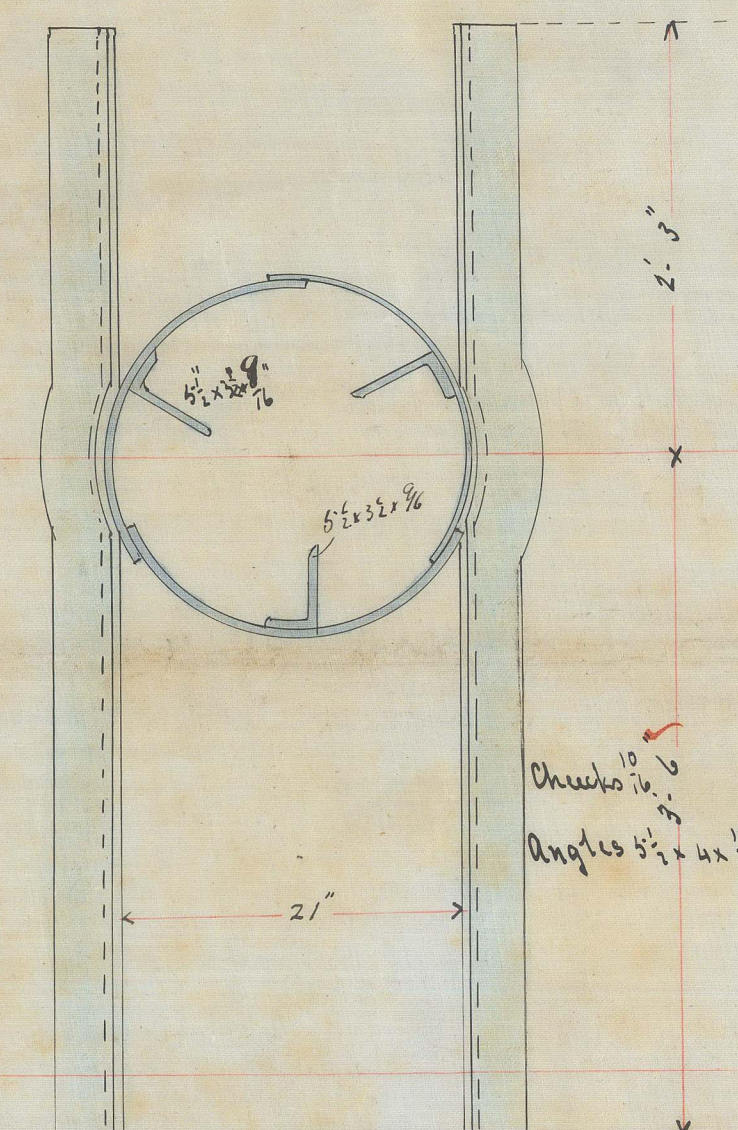

Remarks

Masts & Bowprit
Doubled when marked plates off long. Butts shifted off.
Beams single rivetted Butts double except where marked treble.
Butt straps inside 18" for treble & 12" for double rivetting.
Angles 5 in each running the whole length rivetting all flush outside.
Double rivetted straps 16 inches than plates.
Yards
plates 9ft long Butts shifted off.
Beams single rivetted Butts treble Straps 18"
Straps 16 inches than plates Rivetting all flush outside
Yards double as shown

Ship "Mooltan"
Report 4438

No 261

Richardson, Duck & Co

Iron Ship Builders

TRUSTEES OF THE

Shipbuilders' Association

18-01543-0023

1879
28/12/79

LR

© 2021
Lloyd's Register
Foundation

IRON 543-0033

Mooltar

~~Apr 11 1898~~

Iron 27407.



© 2021

Lloyd's Register
Foundation