


9.12.79

Ship 'Mooltan'
W. Hpt. Report No. 4438.


Plan of Upper Deck
Scale 1/4" = 1 foot

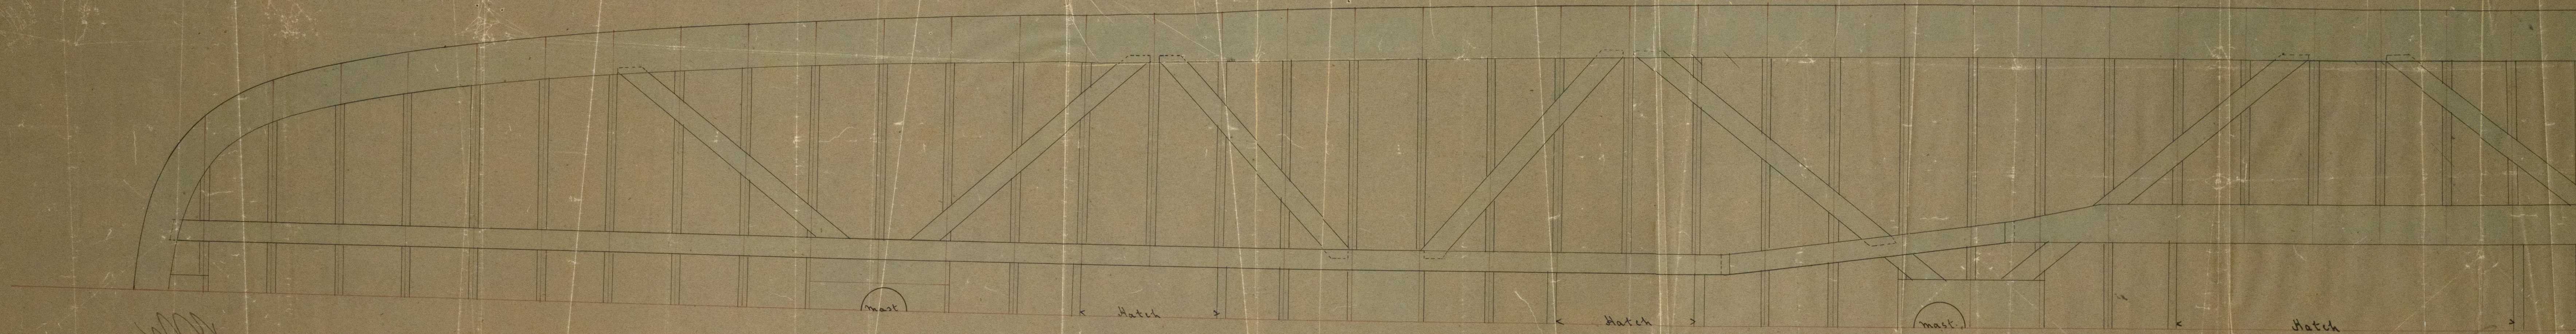

W.H. 18/10/79

Plan of Upper Deck

Scale 1/4" = 1 foot

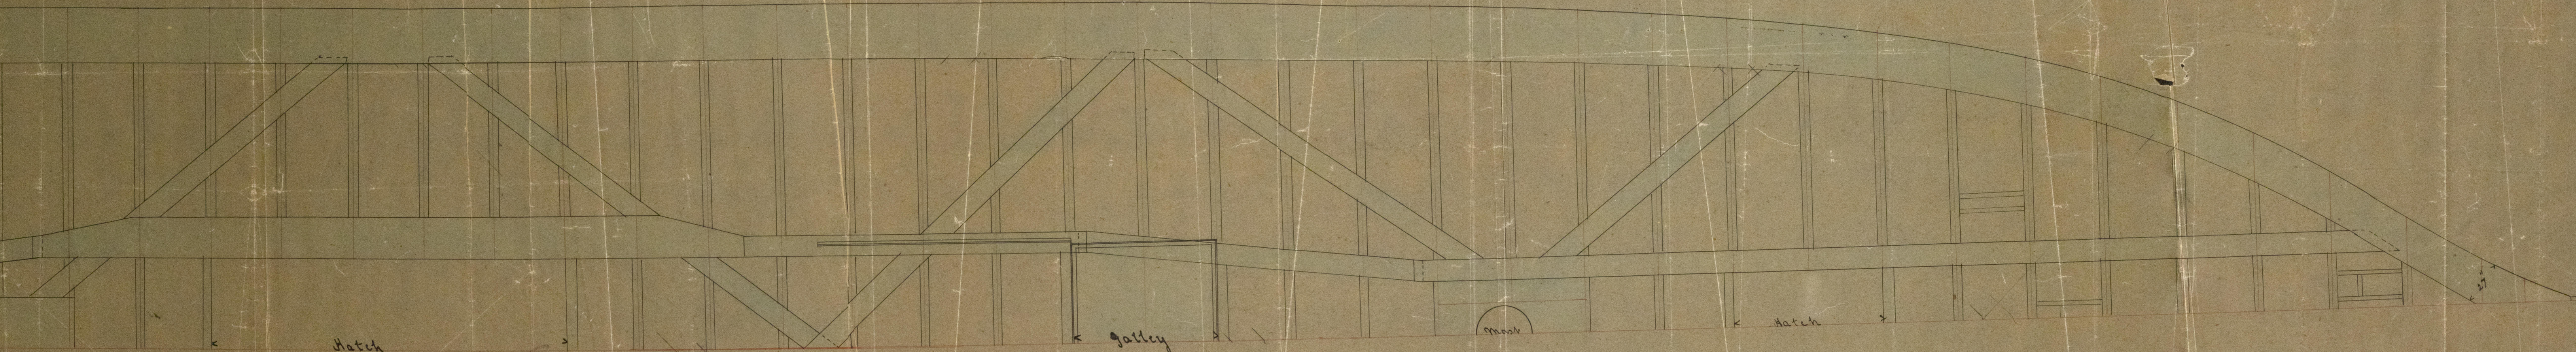

M. J. [Signature]

*West of pool
8th Dec 1879*

Nº 261

RICHARDSON, DUCK & CO.

Iron Ship Builders

STOCKTON-ON-TEES

Lloyds Register

MONS 43-0034

14. 10. 17

17. 11. 10



18M
9/12/79



© 2021

Lloyd's Register
Foundation

1201543-0034